
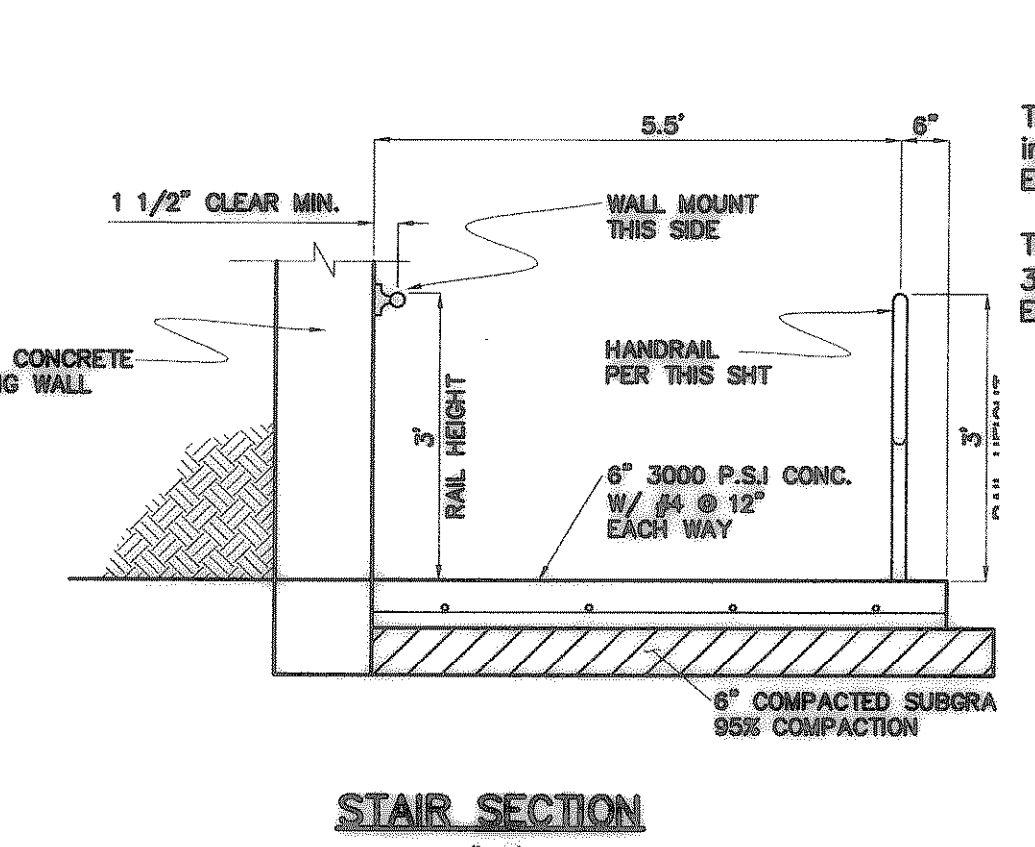
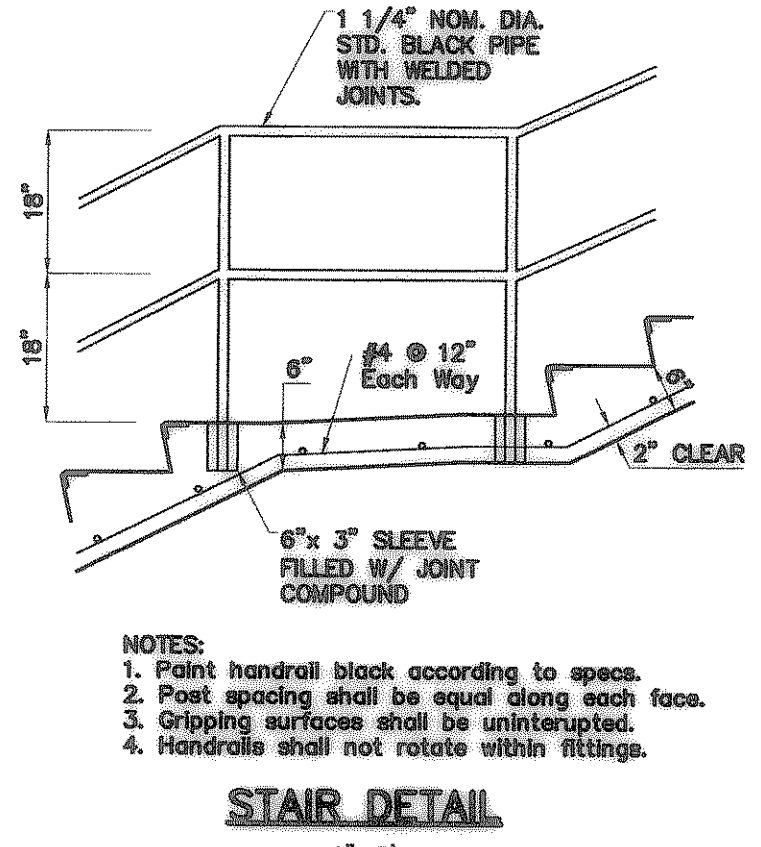
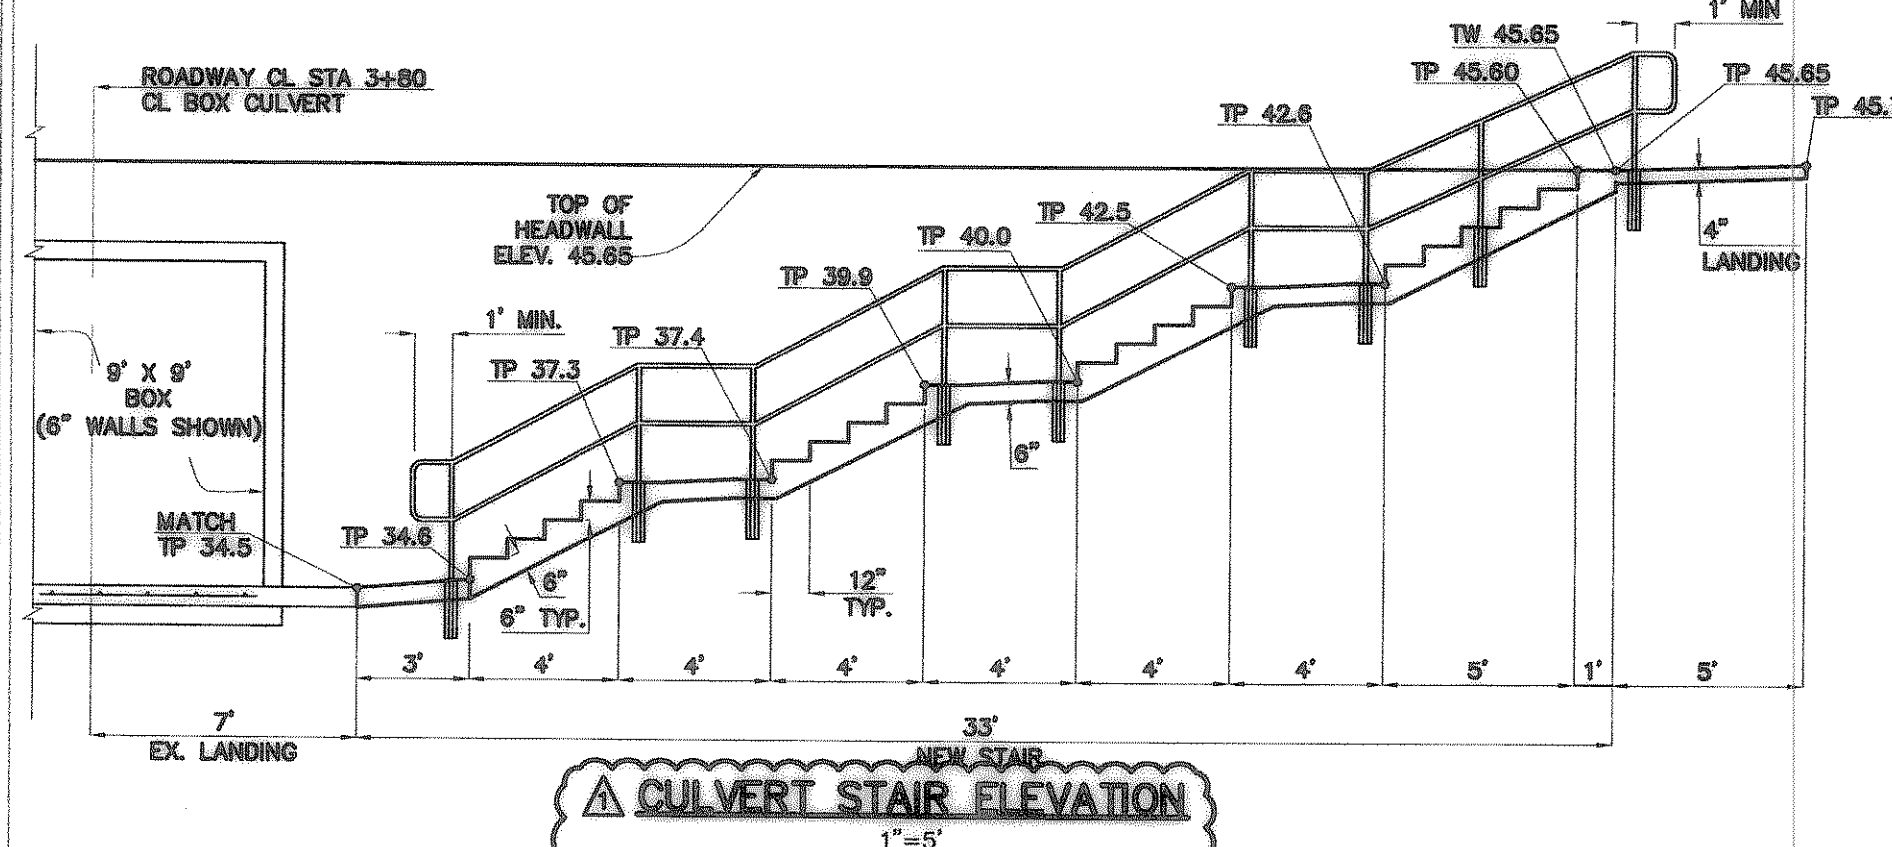


X:\S\Land Projects 2004\295-10\dwg\01C02CRAD.dwg 4/3/2008 10:20:24 AM CDT

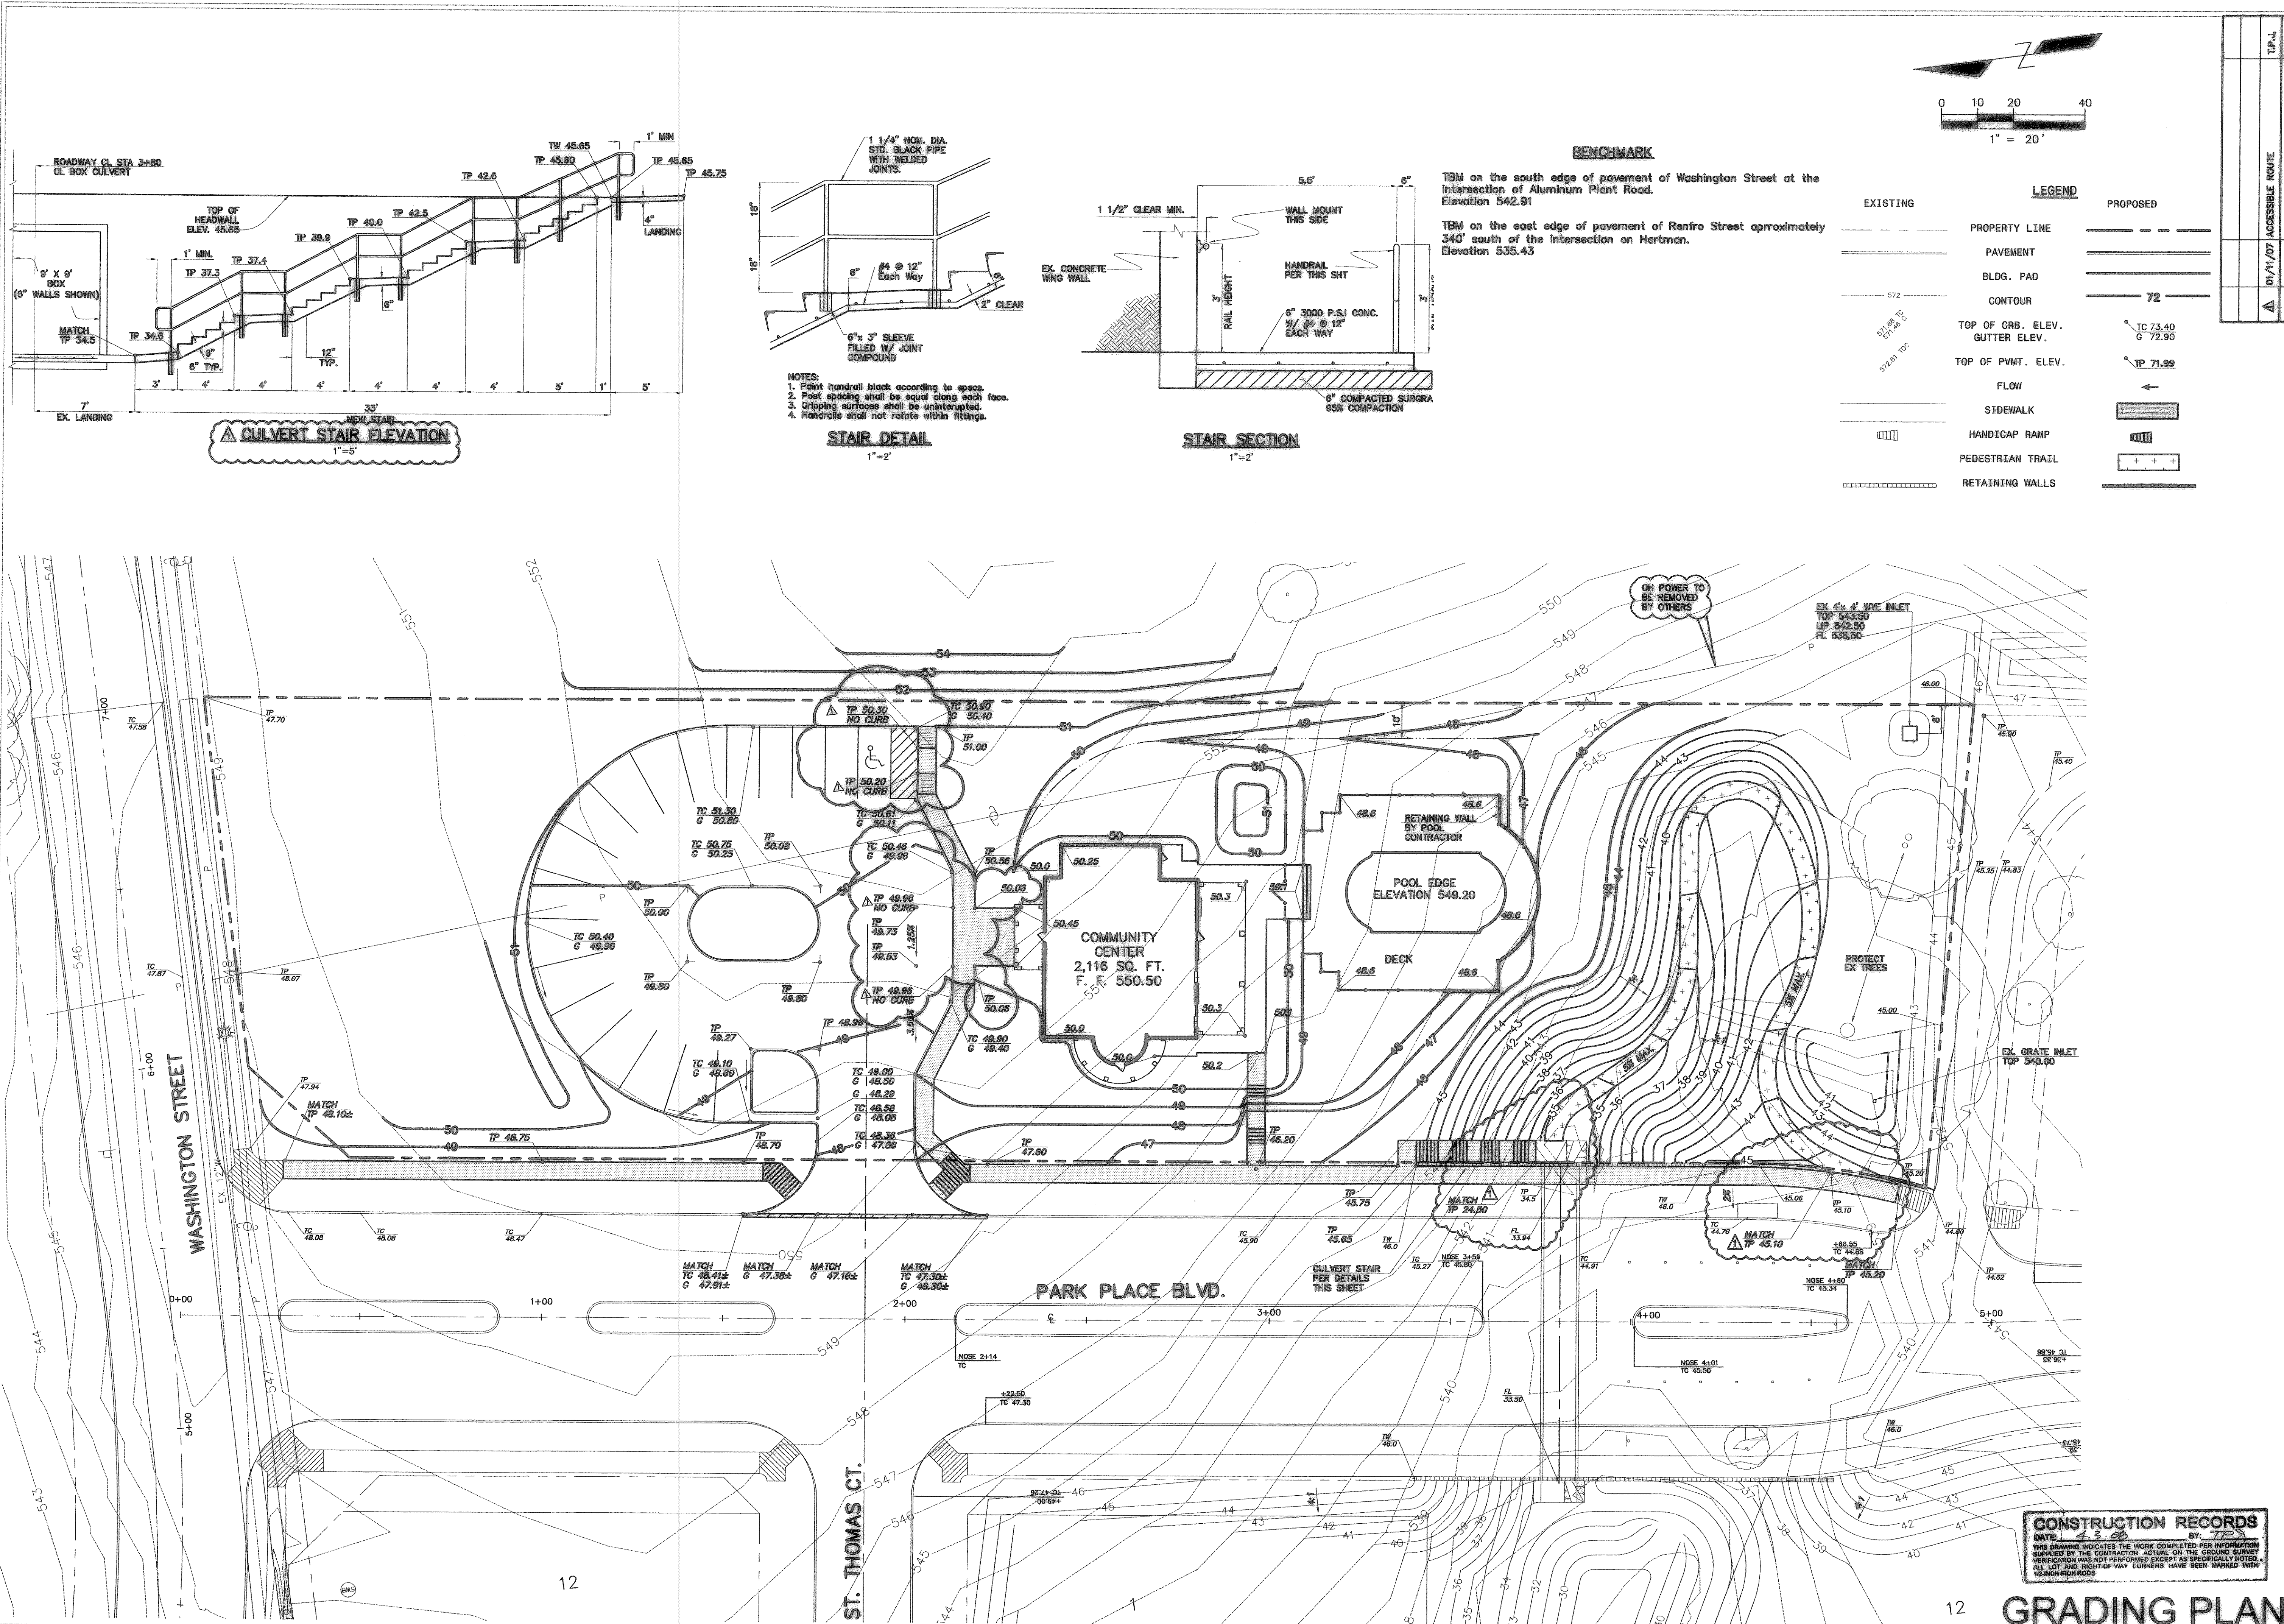

**BENCHMARK**

TBM on the south edge of pavement of Washington Street at the intersection of Aluminum Plant Road.  
Elevation 542.91

TBM on the east edge of pavement of Renfro Street approximately 340' south of the intersection on Hartman.  
Elevation 535.43

**LEGEND**

EXISTING	PROPOSED
---	---
---	---
**RAMSAY**  
**IVY COMPANY, LC**

1250 E. WASHINGTON  
ROCKWALL, TEXAS 75087

PH: 972.771.1030

DATE  
JANUARY 18, 2006

PROJECT  
0105

**C2**

**Park Place Community Center**

PARK PLACE BLVD  
ROCKWALL TEXAS

**CONSTRUCTION RECORDS**

DATE: 4.3.08 BY: TJS

THIS DRAWING INDICATES THE WORK COMPLETED PER INFORMATION SUPPLIED BY THE CONTRACTOR ACTUAL ON THE GROUND SURVEY VERIFICATION WAS NOT PERFORMED EXCEPT AS SPECIFICALLY NOTED. ALL LOT AND RIGHT-OF-WAY CORNERS HAVE BEEN MARKED WITH 1/2" BENCH MARKS.