


CONSTRUCTION RECORDS
 DATE: 11/2/06 BY: T.P.J.
 THIS DRAWING INDICATES THE WORK COMPLETED PER INFORMATION SUPPLIED BY THE CONTRACTOR ACTUAL ON THE GROUND SURVEY VERIFICATION WAS NOT PERFORMED EXCEPT AS SPECIFICALLY NOTED. ALL LOT AND RIGHT-OF-WAY CORNERS HAVE BEEN MARKED WITH 1/2-INCH IRON RODS.

| TP-A | TP-A | Revisions | App. |
|----------|---------------------|-----------|------|
| 08/09/06 | RAISED ALLEY D | | |
| 08/19/05 | ALLEY C 6+00 TO END | | |
| No. | Date | | |

THE SEAL APPEARING ON THIS DOCUMENT WAS AUTHORIZED BY THOMAS P. JONES, P.E. 5897, ON 10/15/2006.

BENCHMARK
 TBM on the south edge of pavement of Washington Street at the intersection of Aluminum Plant Road. Elevation 542.91
 TBM on the east edge of pavement of Renfro Street approximately 340' south of the intersection on Hartman. Elevation 535.43

TOMDEN ENGINEERING, L.L.P.
 12655 N. Central Expwy., Suite 1016
 Dallas, Texas 75243
 Ph: 972.386.6446 Fax: 972.386.6409
 mail@tomden.com

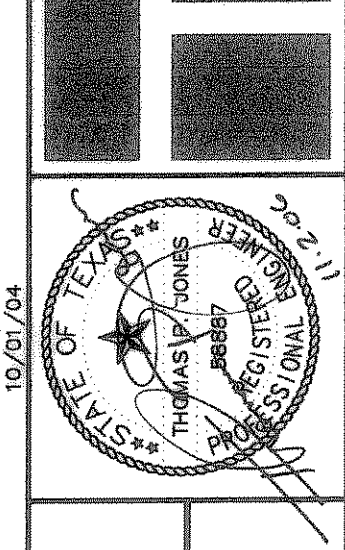

PARK PLACE - WEST PHASE II
 OWNER: COLUMBIA ENERGY SERVICES CORP.
 1200 E. WASHINGTON
 ROCKWALL, TX 75087
 972.771-7108

ALLEY PROFILES

Scale: 1" = 40' H, 1" = 4' V
 Designed by: T.P.J.
 Drawn by: R.V.A.
 Checked by: T.P.J.
 /dwg/293-02/01038\PAVING.dwg
 Date: 10/18/06 11:31