


THE SEAL APPEARING ON THIS DOCUMENT WAS AUTHORIZED BY THOMAS P. JONES 10/07/05

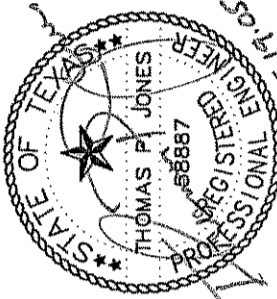

No.	Date	Revisions	App.

TOMDEN ENGINEERING, L.L.P.
 12855 N. Central Expwy., Suite 1016
 Dallas, Texas 75243
 Ph: 972.386.6446 Fax: 972.386.6409
 mail@tomden.com

**PARK PLACE - WEST
 PHASE II**

**SANITARY SEWER
 PROFILES
 LINES "B-1", "B-2", & "C"**

Scale: 1" = 40' H, 1" = 4' V
 Designed by I.P.J.
 Drawn by R.A.A.
 Checked by I.P.J.
 /s/wg/293-02/01C11SSPRO.dwg
 Date: 05/18/05 13:42