


No.	TREE TYPE	SIZE (INCHES)
1000	HACKBERRY	4
1001	HACKBERRY	6
1002	WILLOW	10
1003	HACKBERRY	8
1004	HACKBERRY	8
1005	HACKBERRY	24
1006	WILLOW	18
1008	HACKBERRY	6
1009	HACKBERRY	6
1010	HACKBERRY	6
1011	HACKBERRY	6
1012	HACKBERRY	6
1013	WILLOW	10
1018	HACKBERRY	12
1019	HACKBERRY	6
1020	HACKBERRY	18
1022	BLACK LOCUS	18
1023	WILLOW	10
1024	HACKBERRY	12
1025	HACKBERRY	12
1027	HACKBERRY	6
1029	HACKBERRY	12
1030	HACKBERRY	8
1031	HACKBERRY	10
1033	CEDRAR LOCUS	24
1034	WILLOW	18
1035	HACKBERRY	8
1036	HACKBERRY	10
1038	HACKBERRY	18
1039	HACKBERRY	8
1040	HACKBERRY	8
1041	HACKBERRY	8
1042	HACKBERRY	8
1043	HACKBERRY	8
1044	HACKBERRY	12
1045	HACKBERRY	6
1046	HACKBERRY	6
1049	WILLOW	12
1050	HACKBERRY	8
1051	HACKBERRY	8
1052	HACKBERRY	16
1054	WILLOW	10
1055	WILLOW	18
1056	HACKBERRY	20
1057	HACKBERRY	18
1059	WILLOW	18
1060	CEDRAR	6
1061	WILLOW	6
1062	HACKBERRY	8
1064	HACKBERRY	8
1065	HACKBERRY	8
1066	HACKBERRY	8
1067	WILLOW	18
1075	HACKBERRY	6

TOTAL TREE INCHES 636

No.	TREE TYPE	SIZE (INCHES)
1000	HACKBERRY	6
1001	HACKBERRY	6
1002	HACKBERRY	6
1003	WILLOW	10
1004	HACKBERRY	8
1005	HACKBERRY	8
1009	HACKBERRY	6
1010	HACKBERRY	6
1011	HACKBERRY	6
1012	HACKBERRY	6
1013	HACKBERRY	6
1019	HACKBERRY	12
1020	HACKBERRY	6
1021	BLACK LOCUS	10
1022	WILLOW	18
1024	HACKBERRY	12
1025	HACKBERRY	6
1026	HACKBERRY	6
1027	HACKBERRY	18
1030	HACKBERRY	8
1031	HACKBERRY	10
1032	BLACK LOCUS	24
1033	CEDRAR	18
1035	HACKBERRY	8
1036	HACKBERRY	10
1037	HACKBERRY	10
1038	HACKBERRY	18
1040	HACKBERRY	8
1041	HACKBERRY	8
1042	HACKBERRY	8
1043	HACKBERRY	12
1045	HACKBERRY	6
1046	HACKBERRY	6
1047	HACKBERRY	6
1048	HACKBERRY	10
1050	HACKBERRY	12
1051	HACKBERRY	8
1052	HACKBERRY	8
1053	WILLOW	10
1054	WILLOW	18
1056	WILLOW	18
1057	HACKBERRY	20
1058	HACKBERRY	16
1062	HACKBERRY	8
1063	BLACK LOCUS	10
1064	HACKBERRY	8
1066	HACKBERRY	8
1067	WILLOW	18
1075	HACKBERRY	6

TOTAL TREE INCHES 586 TO BE REMOVED

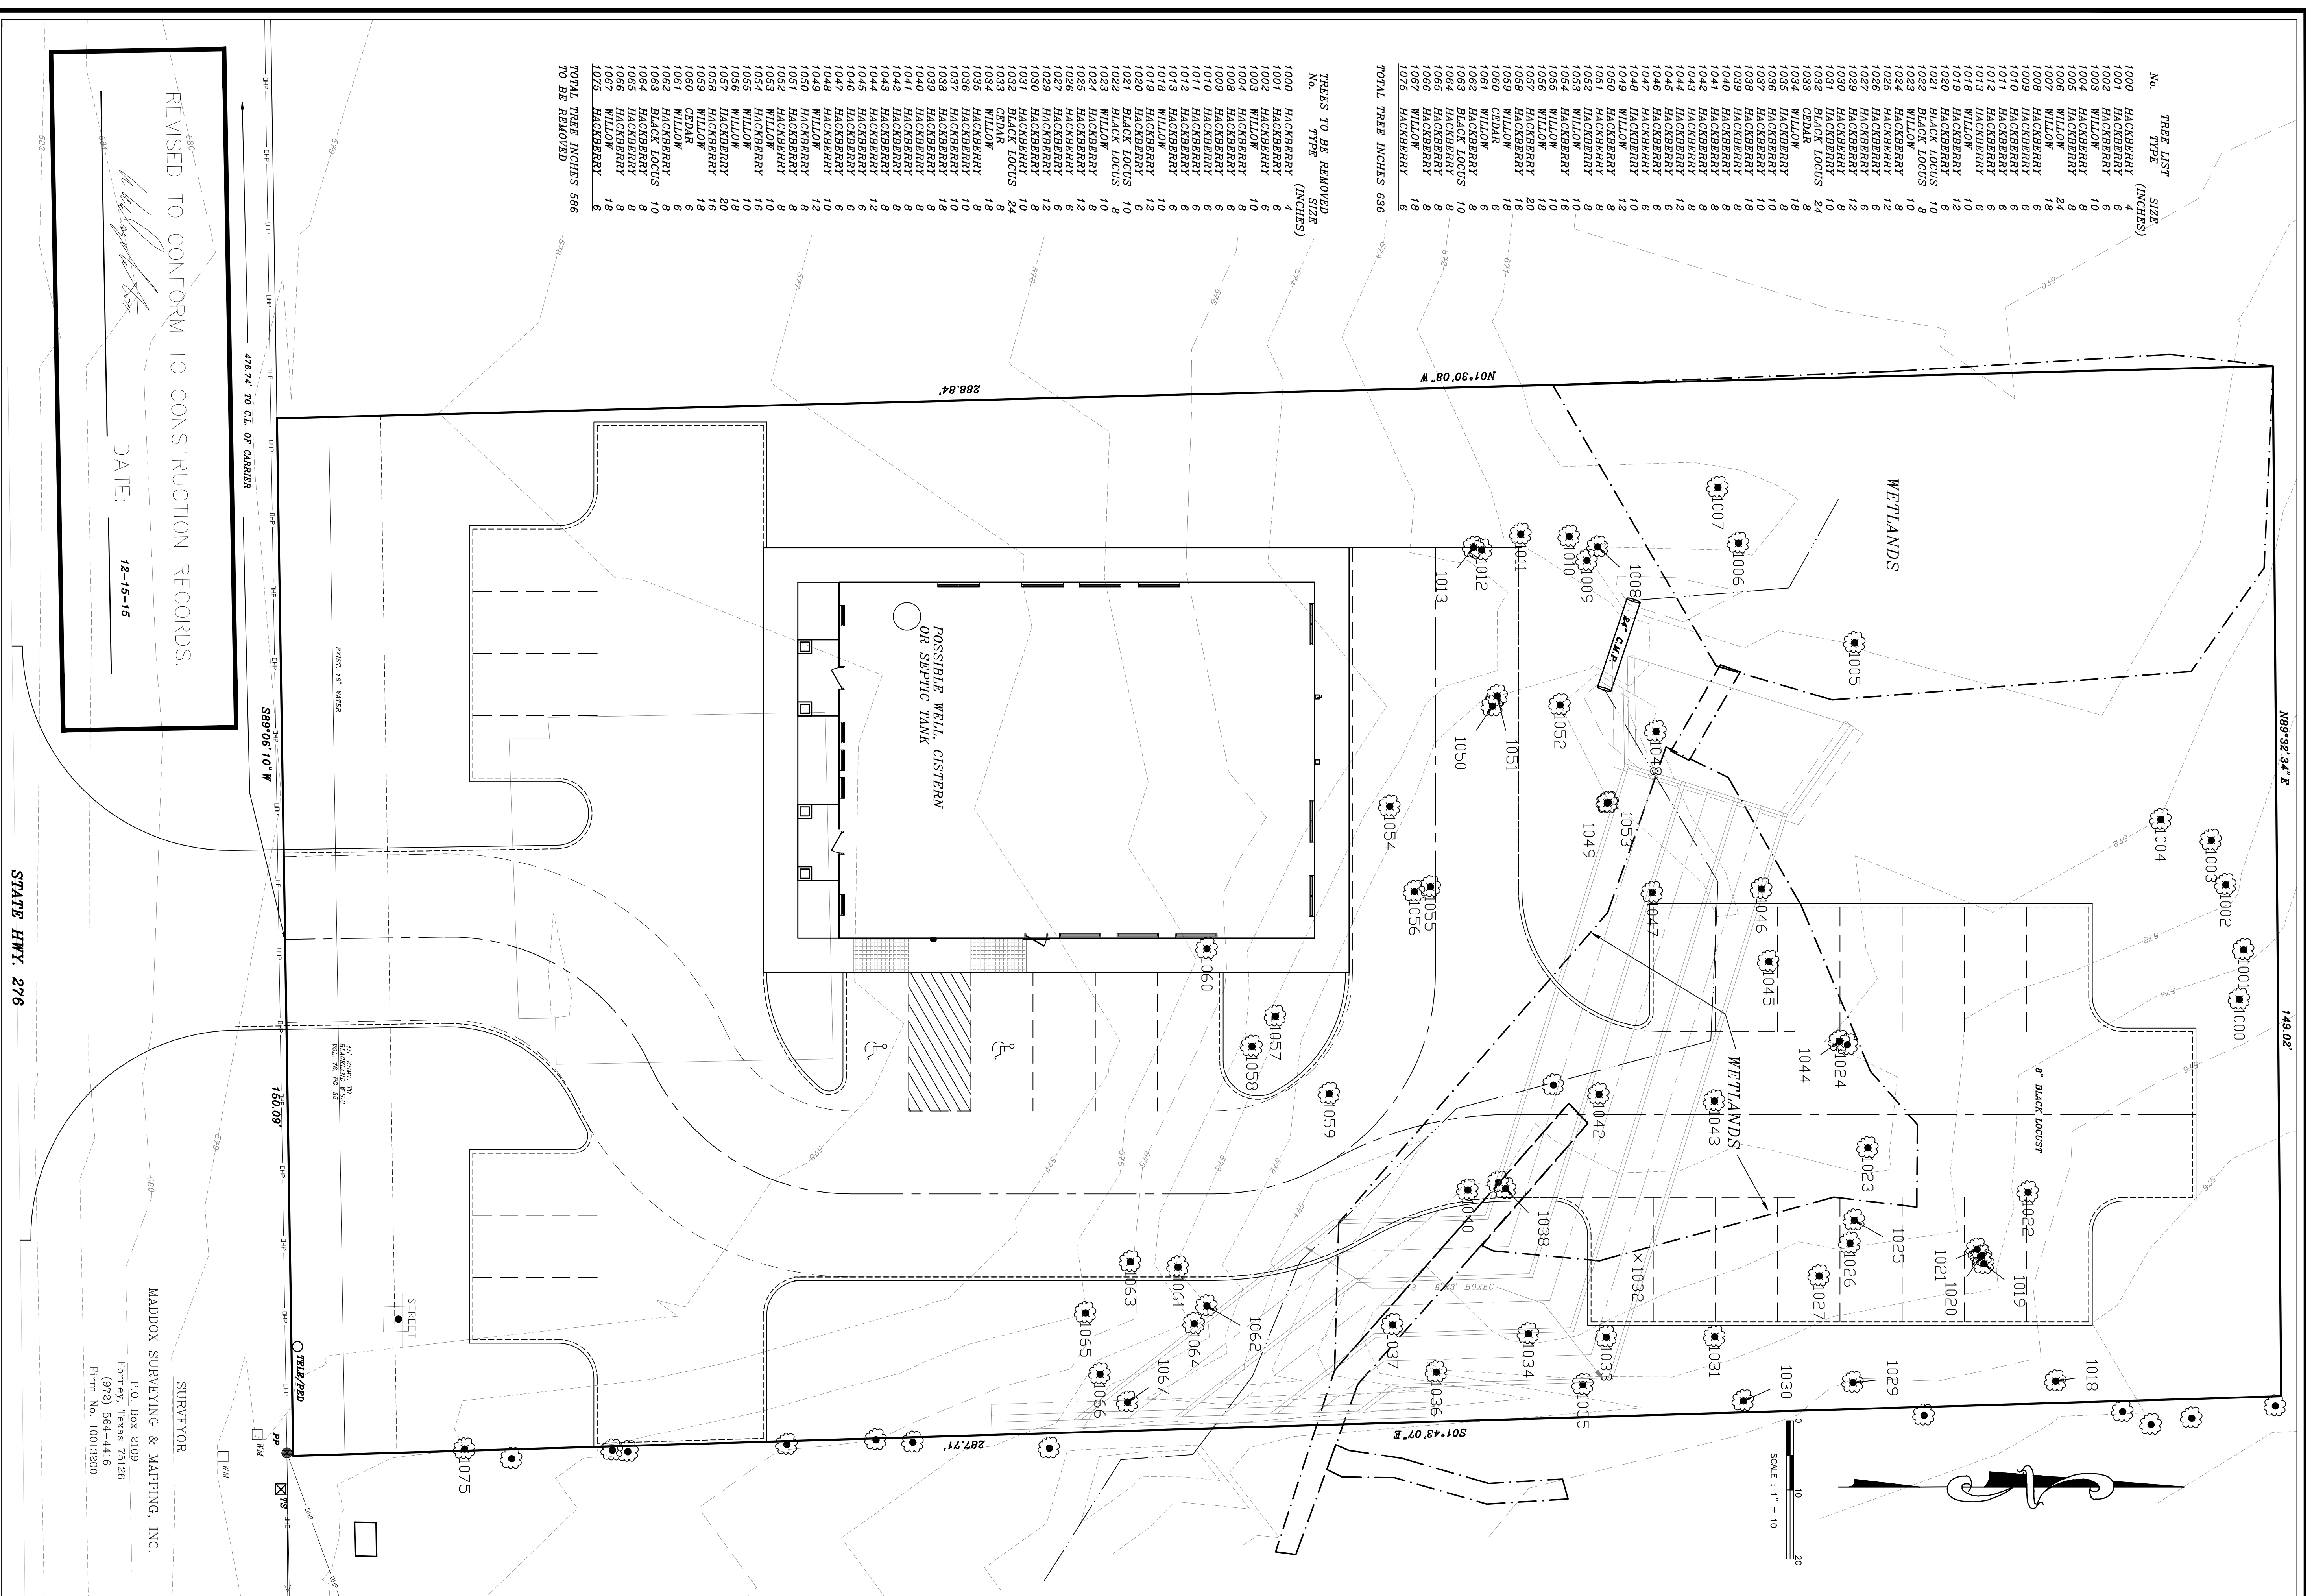

1 OF 1	PROJECT	13029
	DATE	APR 15, 2014
	SCALE	1" = 10'
	DRWN	GCW
	CHECKED	WLD
	REVISION	

**TREE SURVEY**  
**PEAR PEDI MEDICAL OFFICE**  
 J.M. ALLEN SURVEY, ABST. 2  
 ROCKWALL COUNTY, TEXAS

ENGINEERING • PROJECT MANAGEMENT • SURVEYING

**DOUPHRAITE & ASSOCIATES, INC.**

2235 RIDGE RD., # 200 ROCKWALL, TEXAS 75087  
 PHONE: (972)771-9004 FAX: (972)771-9005

THE SEAL APPEARING ON THIS SURVEY IS THE PROPERTY OF WILLIAM DOUPHRAITE, INC. NO. 67022, F-886, 0W DATE: APRIL 13, 2014

SURVEYOR

MADDOX SURVEYING & MAPPING, INC.  
 P.O. Box 2109  
 Fortney, Texas 75126  
 (972) 561-4416  
 Firm No. 10013200