


1) Quote only with lines in sheets 1.  
 2) Material for 10" line with 1" x 3" CP  
 11-6-83

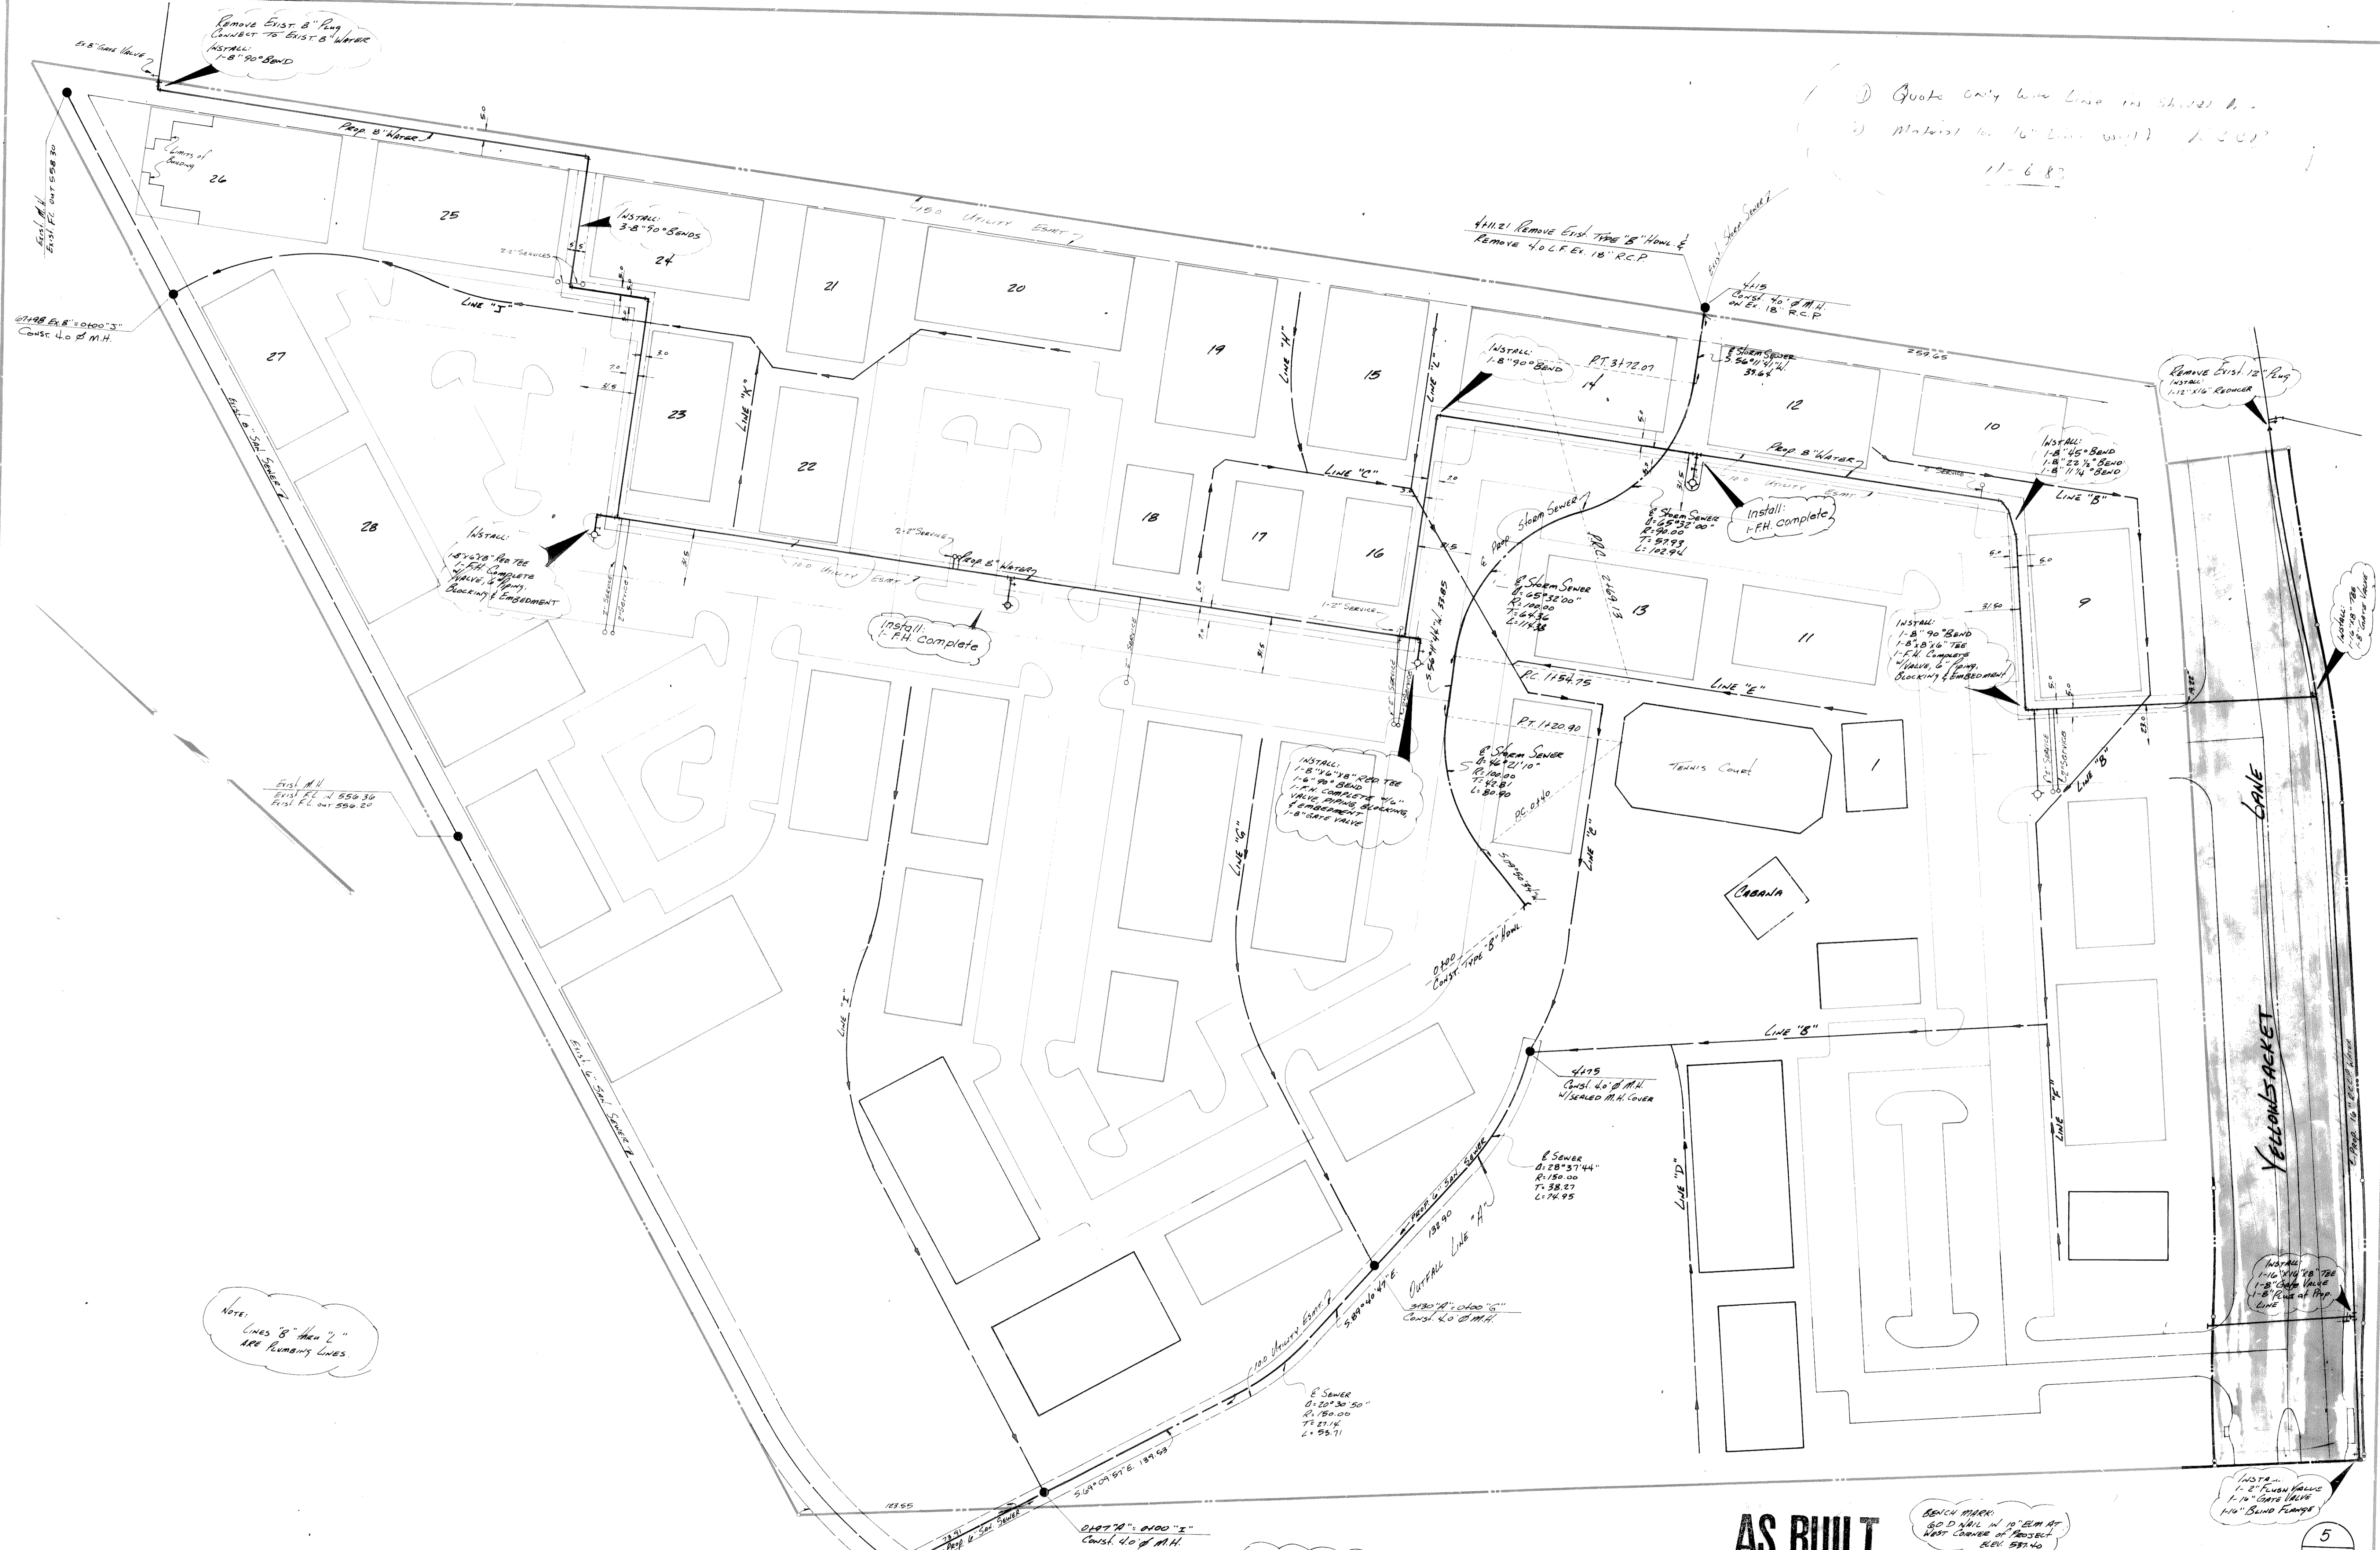

Note: Lines B thru L ARE RUNNING LINES

Note: SHADED AREA Denotes THIS CONTRACT

**AS BUILT**

BENCH MARK: 50 D NAIL IN 10" EBM AT WEST CORNER OF PROJECT. ELEV. 537.40

INSTALL: 1-2" RUBBER VALVE 1-1/2" GATE VALVE 1-1/2" BAND FLANGE

<b>WATER &amp; SEWER PLAN</b> <b>PEBBLEBROOK APARTMENTS PHASE TWO</b>		CITY OF ROCKWALL	
		ROCKWALL COUNTY, TEXAS	
Design	Drawn	Scale	Date
M.L.R.		1"=40'	AUGUST, 1982
329-BI-33 HAROLD L. EVANS CONSULTING ENGINEER CH.		REVISED 3-7-83 REVISED 3-10-83 REVISED 6-22-83 REVISED 6-30-83	