



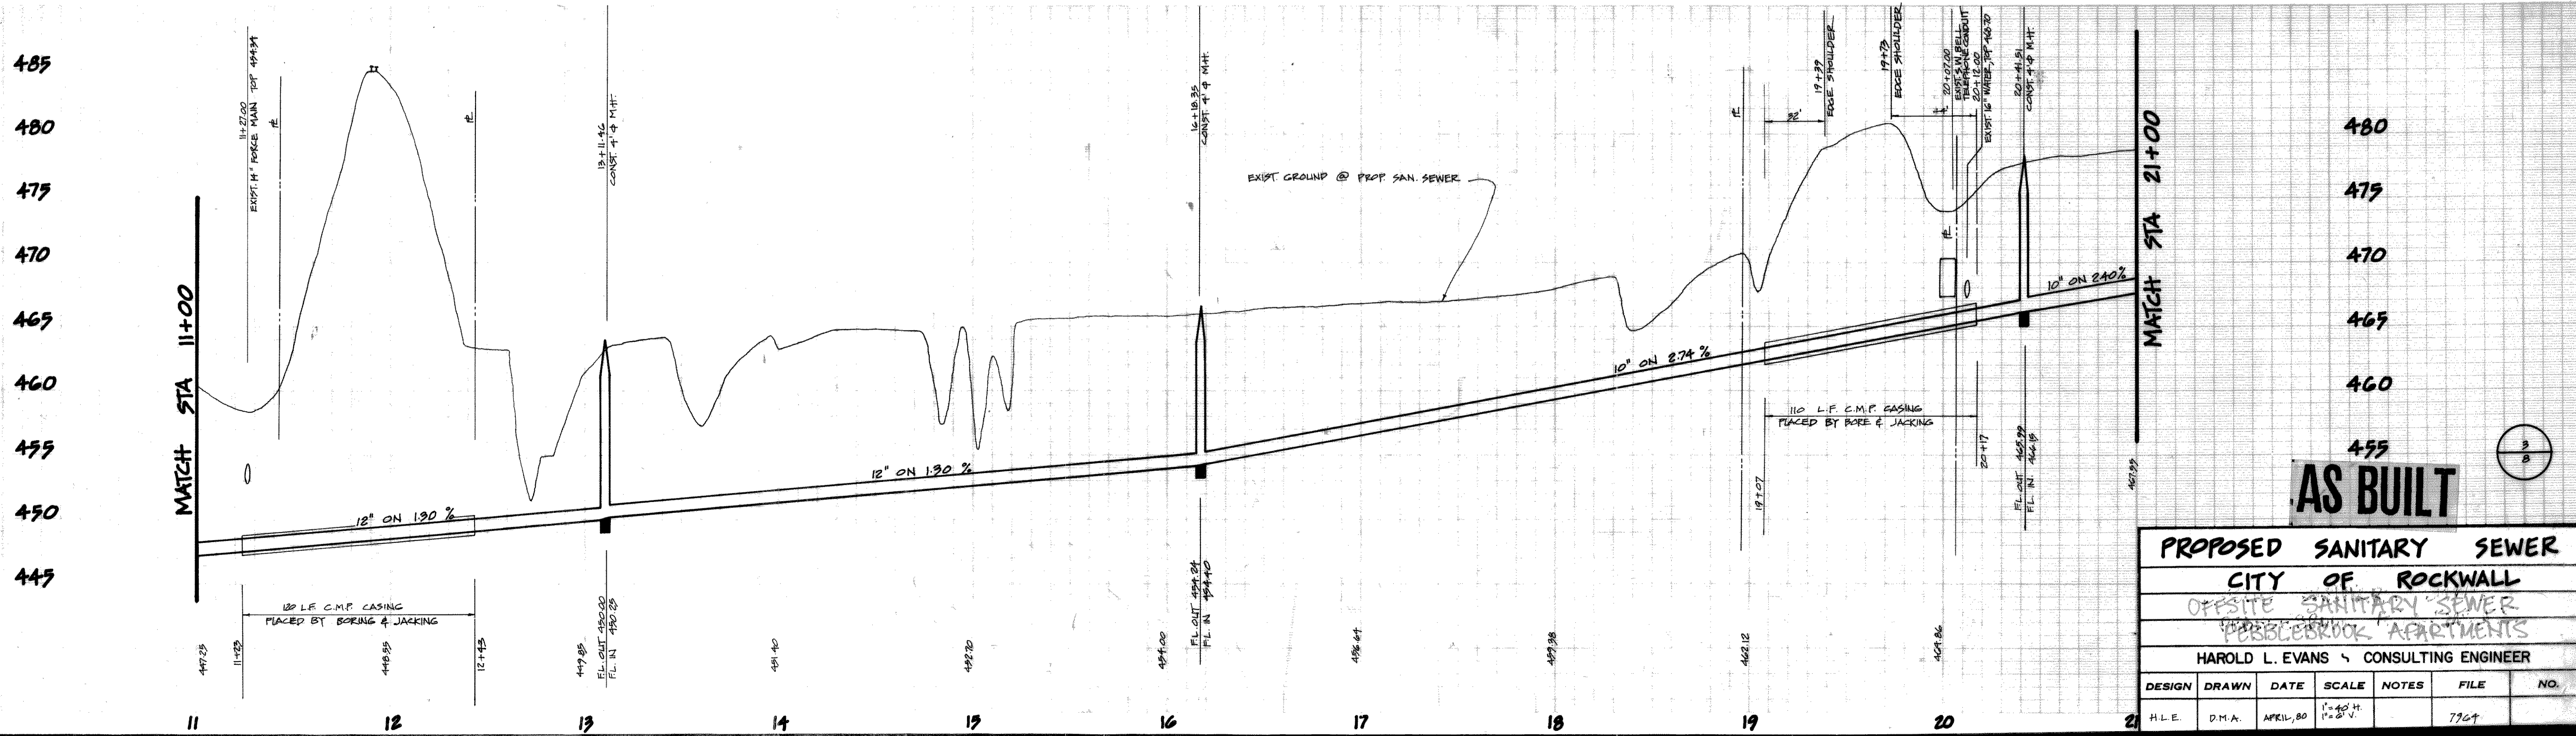

CIFCO PROPERTIES, INC.

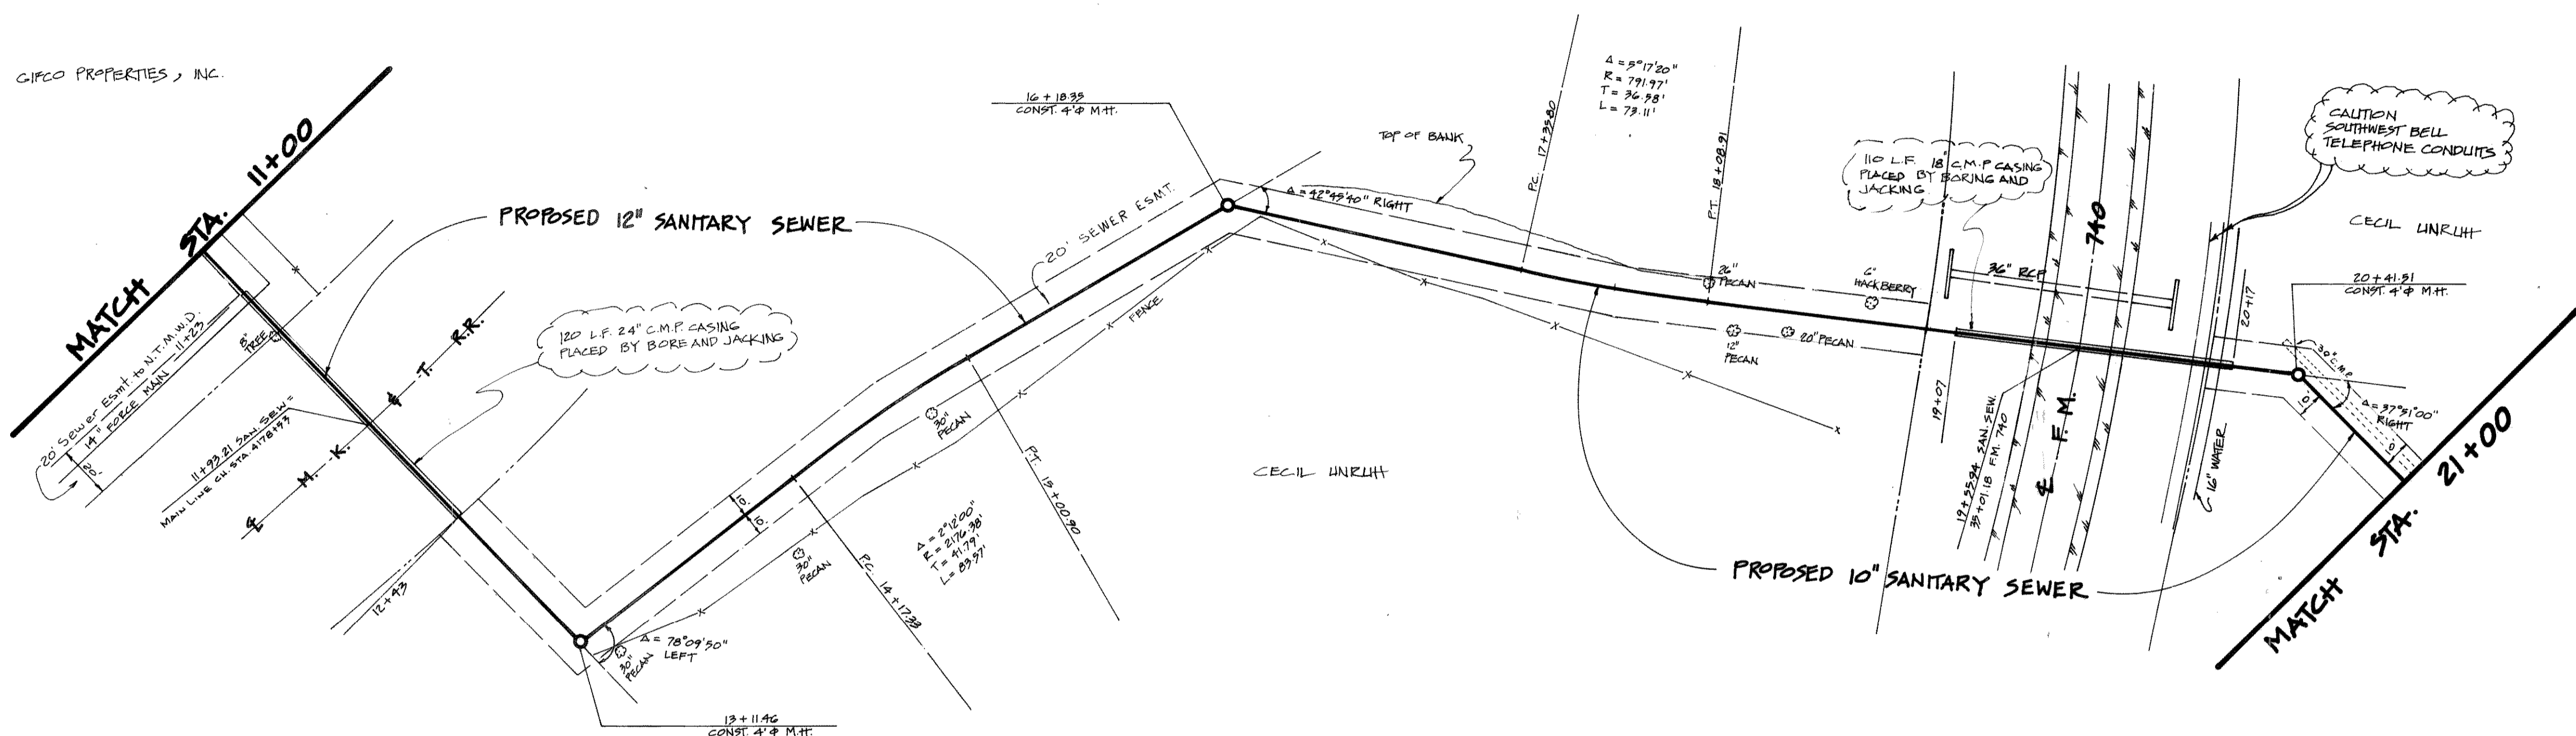

**AS BUILT**

PROPOSED SANITARY SEWER					
CITY OF ROCKWALL					
OFFSITE SANITARY SEWER					
PEBBLEBROOK APARTMENTS					
HAROLD L. EVANS CONSULTING ENGINEER					
DESIGN	DRAWN	DATE	SCALE	NOTES	FILE NO.
H.L.E.	D.M.A.	APRIL, 80	1" = 40' H. 1/2" = 20' V.		7769