

PAVING, GRADING, DRAINAGE, & UTILITY CONSTRUCTION PLANS


FOR PECAN VALLEY DRIVE AND QUAIL RUN ROAD

Pecan Valley Drive & Quail Run Road

INDEX OF SHEETS

SHEET NO.	DESCRIPTION	DATE	REVISION
	COVER SHEET	04/24/08	△△
1 of 2	FINAL PLAT	02/19/08	
2 of 2	FINAL PLAT	02/19/08	
C-1	GENERAL NOTES	02/27/08	
C-2	DEMOLITION PLAN	04/04/08	△
C-3	TREE MITIGATION PLAN	04/04/08	△
	PAVING PLANS		
C-4	PECAN VALLEY DRIVE PAVING PLAN AND PROFILE	04/04/08	△
C-5	QUAIL RUN ROAD PAVING PLAN	02/27/08	
C-6	QUAIL RUN ROAD CURB PROFILES AND PAVING CROSS SECTIONS	02/27/08	
C-7	PAVING DETAILS	02/27/08	
C-8	MASS GRADING PLAN	04/04/08	△
TCP-1	TRAFFIC CONTROL PLAN	04/24/08	△
	DRAINAGE PLANS		
C-9	DRAINAGE AREA MAP	02/27/08	
C-10	STORM SEWER AND INLET DESIGN CALCULATIONS	02/27/08	
C-11	PECAN VALLEY DRIVE STORM SEWER PLAN AND PROFILE	02/27/08	
C-12	QUAIL RUN ROAD STORM SEWER PLAN AND PROFILE	04/04/08	△
C-13	STORM SEWER LINE "D" AND "E" PLAN AND PROFILE	02/27/08	
	TxDOT STORM SEWER DETAILS		
C-14	TxDOT MULTIPLE BOX CULVERTS CAST-IN-PLACE 8'-0" SPAN 0' TO 13' FILL MC-8-13	MAY 2005	
C-15	TxDOT MULTIPLE BOX CULVERTS CAST-IN-PLACE MISCELLANEOUS DETAILS MC-MD	MAY 2005	
C-16	TxDOT CONCRETE WINGWALLS WITH PARALLEL WINGS FOR SKEWED AND NON-SKEWED BOX CULVERTS PW	MAY 2005	
C-16A	TxDOT CONCRETE WINGWALLS WITH STRAIGHT WINGS FOR 0° SKEW BOX CULVERTS SW-0	MAY 2005	
C-17	TxDOT CONCRETE WINGWALLS WITH FLARED WINGS FOR SKEWED BOX CULVERTS FW-S	MAY 2005	
C-18	TxDOT PEDESTRIAN RAIL TYPE PR2	FEB. 2003	
C-19	TxDOT RAIL ANCHORAGE CURB BOX CULVERT RAIL MOUNTING DETAILS RAC (SHEET 1 OF 2)	MAY 2005	
C-20	TxDOT RAIL ANCHORAGE CURB BOX CULVERT RAIL MOUNTING DETAILS RAC (SHEET 2 OF 2)	MAY 2005	

ROCKWALL, TEXAS

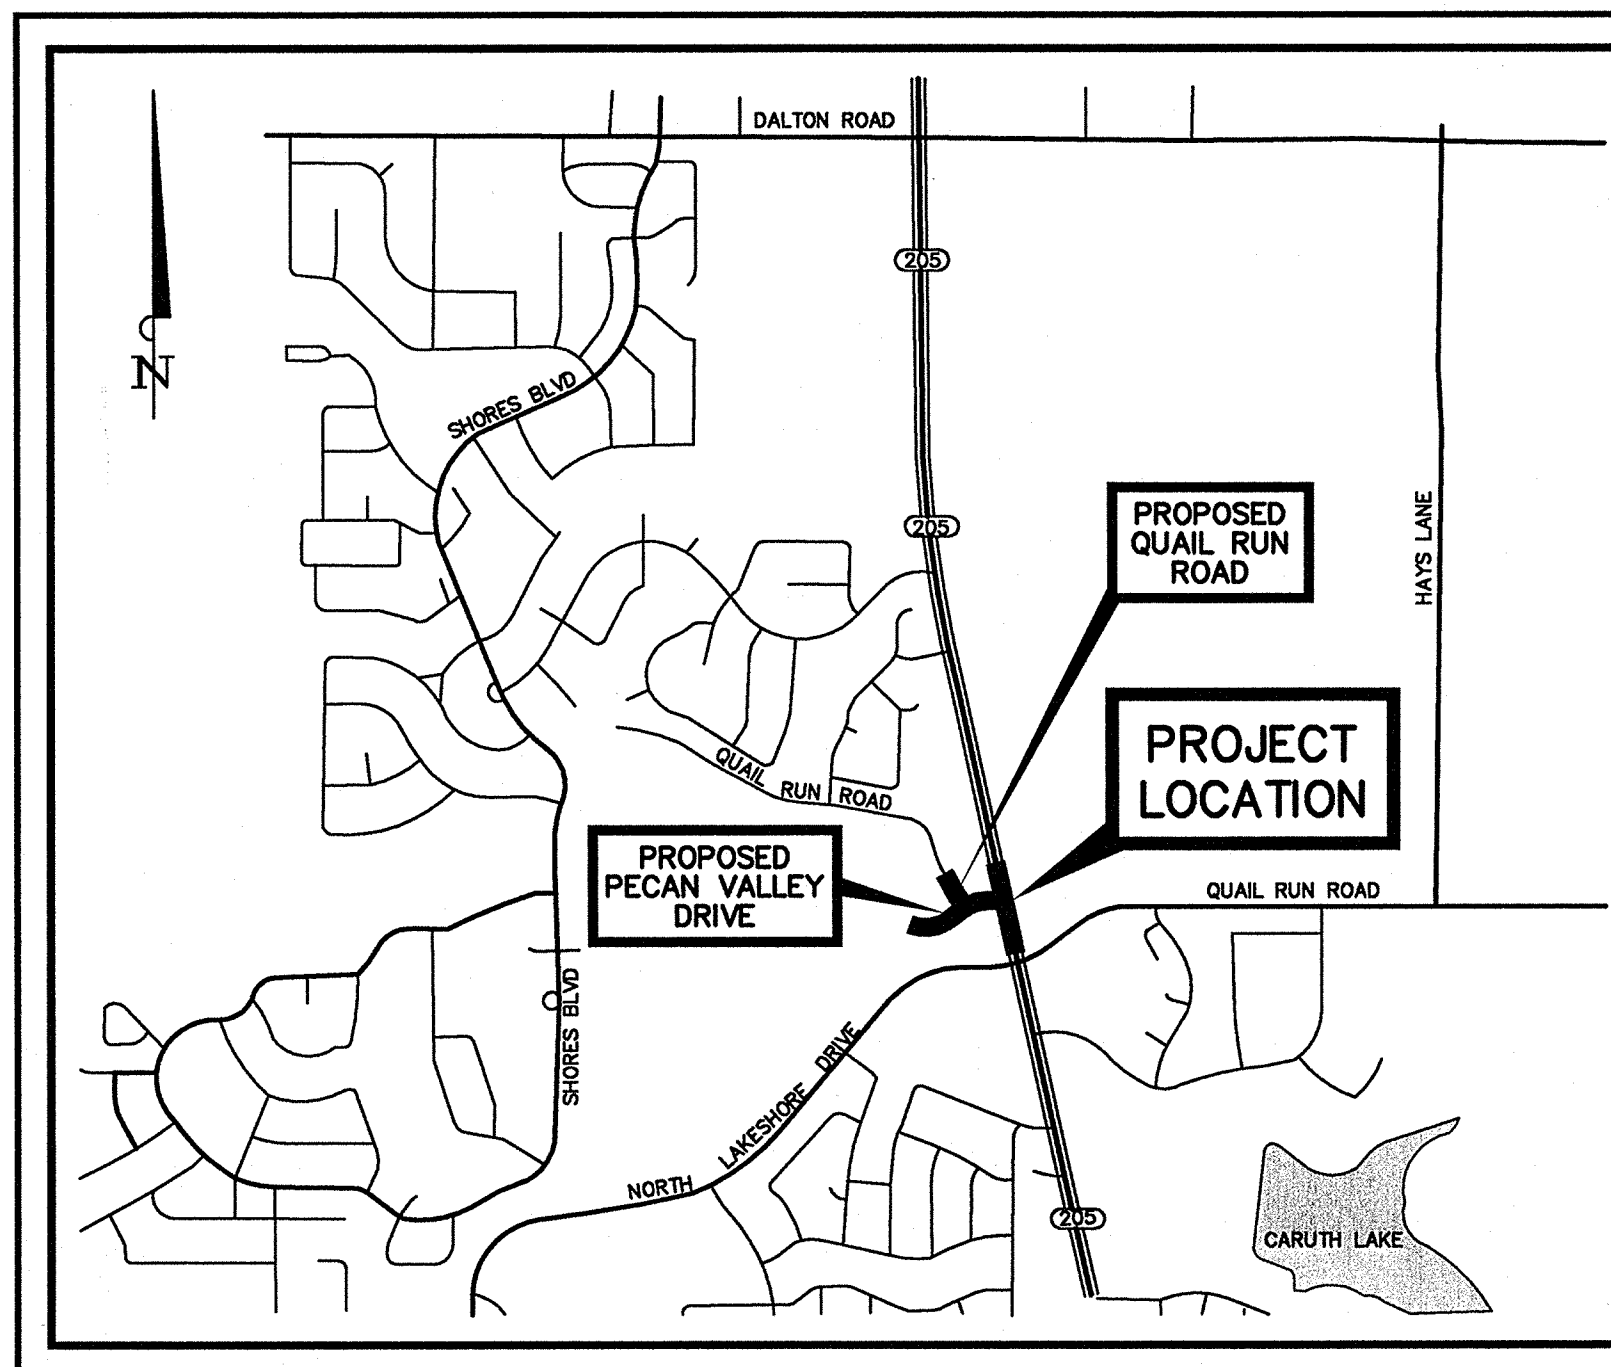

Location Map
Not To Scale

INDEX OF SHEETS

SHEET NO.	DESCRIPTION	DATE	REVISION
	UTILITY PLANS AND PROFILES		
C-21	SANITARY SEWER LINE "A" PLAN AND PROFILE	02/27/08	
C-22	WATER LINE "A" PLAN AND PROFILE	04/04/08	△
C-23	WATER LINES "B" AND "C" PLAN AND PROFILE	04/04/08	△
C-24	CONDUIT / SLEEVING PLAN	02/27/08	
	STORMWATER POLLUTION PREVENTION PLANS		
C-25	EROSION CONTROL PLAN / SITE MAP (SWPPP)	02/27/08	
C-26	EROSION CONTROL PLAN DETAILS (SWPPP)	02/27/08	
	PAVEMENT MARKING PLAN, TRAFFIC CONTROL PLANS, AND TxDOT STANDARD DETAILS		
C-27	S.H. 205 PAVEMENT MARKING REMOVAL & RE-STRIPING PLAN	02/27/08	
C-28	TxDOT TRAFFIC CONTROL PLAN TCP(2-1)-98	APRIL 1998	
C-29	TxDOT TRAFFIC CONTROL PLAN TCP(2-3)-03	MARCH 2003	
C-30	TxDOT TRAFFIC CONTROL PLAN MOBILE OPERATIONS UNDIVIDED HIGHWAYS TCP(3-1)-98	APRIL 1998	
C-31	TxDOT TRAFFIC CONTROL PLAN MOBILE OPERATIONS RAISED PAVEMENT MARKER INSTALLATION TCP(3-3)-98	APRIL 1998	
C-32	TxDOT TRAFFIC CONTROL PLAN FOR SURFACING OPERATIONS TCP(7-1)-98	APRIL 1998	
C-33	TxDOT BARRICADE AND CONSTRUCTION GENERAL NOTES AND REQUIREMENTS BC(1)-03	APRIL 2003	
C-34	TxDOT BARRICADE AND CONSTRUCTION PROJECT LIMIT STANDARD BC(2)-03	NOV. 2002	
C-35	TxDOT BARRICADE AND CONSTRUCTION WORK ZONE SPEED LIMIT STANDARD BC(3)-03	NOV. 2002	
C-36	TxDOT BARRICADE AND CONSTRUCTION TEMPORARY SIGN NOTES STANDARD BC(4)-03	NOV. 2002	
C-37	TxDOT BARRICADE AND CONSTRUCTION TYPICAL SIGN SUPPORT STANDARD BC(5)-03	NOV. 2002	
C-38	TxDOT BARRICADE AND CONSTRUCTION ARROW AND MESSAGE SIGNS, REFLECTORS & WARNING LIGHT STANDARD BC(6)-03	NOV. 2002	
C-39	TxDOT BARRICADE AND CONSTRUCTION PLASTIC DRUM STANDARD BC(7)-03	APRIL 2003	
C-40	TxDOT BARRICADE AND CONSTRUCTION CHANNELIZING DEVICES STANDARD BC(8)-03	NOV. 2002	
C-41	TxDOT BARRICADE AND CONSTRUCTION TYPE III BARRICADE AND CONES STANDARD BC(9)-03	NOV. 2002	
C-42	TxDOT BARRICADE AND CONSTRUCTION PAVEMENT MARKINGS STANDARD BC(10)-03	NOV. 2002	
C-43	TxDOT BARRICADE AND CONSTRUCTION PAVEMENT MARKING PATTERNS STANDARD BC(11)-03	NOV. 2002	
C-44	TxDOT BARRICADE AND CONSTRUCTION REGULATORY & GUIDE SIGNS STANDARDS BC(12)-03	NOV. 2002	
C-45	TxDOT SUPPLEMENTAL MARKINGS USING RAISED PAVEMENT MARKERS REFLECTORIZED PROFILE MARKINGS PM(3)-00A	AUG. 2000	
C-46	TxDOT PAVEMENT MARKINGS FOR TWO-WAY LEFT TURN LANES DIVIDED HIGHWAYS AND RURAL LEFT TURN BAYS PM(4)-03	MARCH 2003	
C-47	TxDOT STANDARD PAVEMENT MARKINGS (ARROWS) PM(6)-01	MARCH 2001	

DEVELOPER:

SALVO REAL ESTATE SOLUTIONS
5005 L.B.J. Freeway, Suite 840
Dallas, Texas 75244
Phone: (972) 331-2050
Fax: (972) 331-0020
Contact: Craig Pincince

OWNER:

ARKOMA DEVELOPMENT, L.L.C.
203 East I-30
Rockwall, Texas 75032
Phone: (972) 771-6000
Fax: (972) 771-5888
Contact: Jean Voltz

ENGINEER:

KIMLEY-HORN AND ASSOCIATES, INC.
5750 Genesis Court, Suite 200
Frisco, Texas 75034
Phone: (972) 335-3580
Fax: (972) 335-3779
Contact: Pieter Kessels, P.E.


PREPARED BY:

 **Kimley-Horn and Associates, Inc.**

5750 Genesis Court, Suite 200
Frisco, Texas 75034

Tel. No. (972) 335-3580
Fax No. (972) 335-3779

April 2008

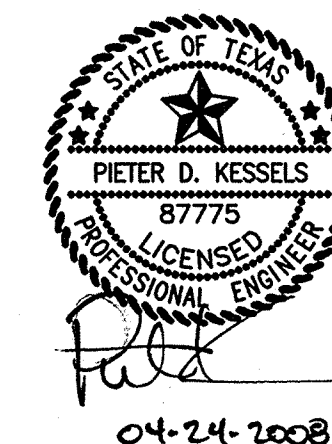

TxDOT General Notes

- All construction within the State Right of Way will require compliance to TxDOT Standard Specifications, Standard Plans, TxDOT on-line Manuals, and the Texas Manual on Uniform Traffic Control Devices.
- Posted Speed Limit on State Highway 205 is 55 miles per hour.

RECORD DRAWING
THIS RECORD DRAWING HEREIN REFLECTS TO THE BEST OF THE DESIGN ENGINEER'S KNOWLEDGE, THE APPROXIMATE LOCATION OF THE CONSTRUCTED WORK, USING INFORMATION AS PROVIDED BY THE CONTRACTORS AND SURVEYED GRADES.