


CONSTRUCTION PLAN SET
FOR
PEOPLES TRACT ADDITION
CITY OF ROCKWALL
ROCKWALL COUNTY, TEXAS

SHEET INDEX

No.	SHEET TITLE
1	COVER
2	FINAL PLAT - SHEET 1 OF 2
3	FINAL PLAT - SHEET 2 OF 2
4	GENERAL NOTES
5	WATER PLAN & PROFILE - STA 1+00 TO 12+50
6	WATER PLAN & PROFILE - STA 12+50 TO END
7	EROSION CONTROL PLAN
8	EROSION CONTROL DETAILS
9	WATER DETAILS

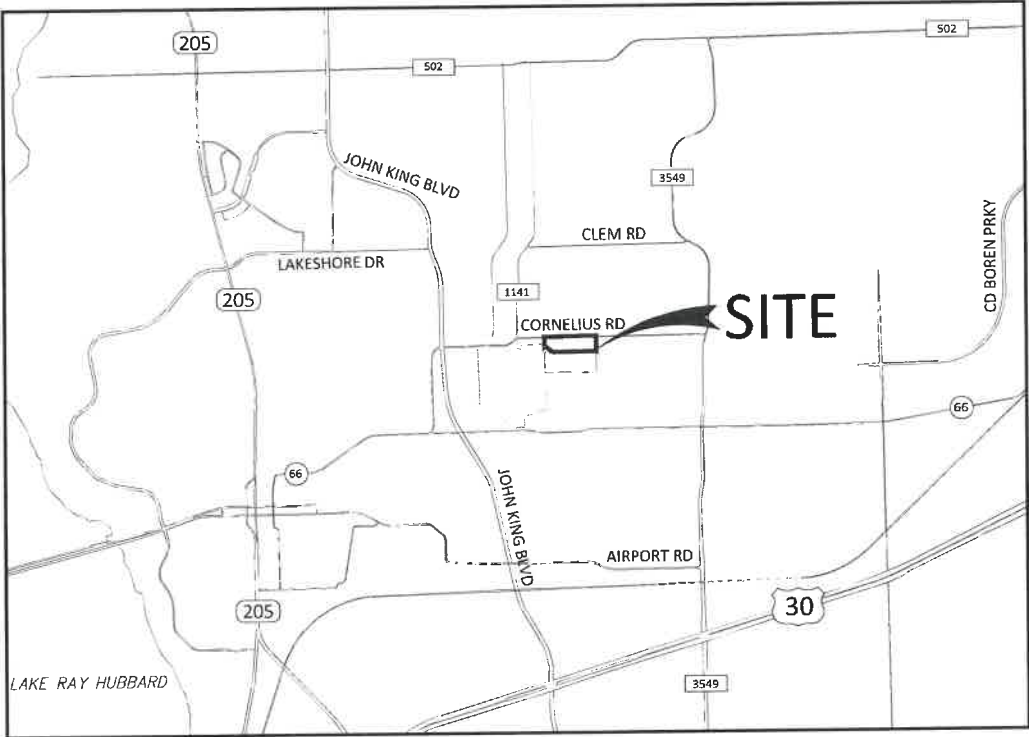


LOCATION MAP
SCALE: 1" = 2,000'
MAPSCO PG. 85-F6

RECORD DRAWING

To the best of our knowledge, Johnson Volk Consulting, Inc., hereby states that this plan is As-Built. This information provided is based on surveying at the site and information provided by the contractor. The original sealed drawings are on file at the offices of:

Johnson Volk Consulting, Inc.

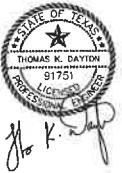

08/05/2024
JVC No MJP504

"ALL RESPONSIBILITY FOR ADEQUACY OF DESIGN REMAINS WITH THE DESIGN ENGINEER. THE CITY OF ROCKWALL, IN REVIEWING AND RELEASING PLANS FOR CONSTRUCTION, ASSUMES NO RESPONSIBILITY FOR ADEQUACY OR ACCURACY OF DESIGN."

August 24

Owner:
Michael L. Peoples
4416 W. Lovers Ln, Suite 200
Dallas, Texas 75209
Phone: 214-677-1431

Engineer/Surveyor:
Johnson Volk Consulting, Inc.
704 Central Parkway East, Suite. 1200
Plano, Texas 75074
Phone: 972-201-3100
Contact: Tom Dayton, PE

JOHNSON VOLK CONSULTING
TBPELS: Engineering Firm No. 11962 / Land Surveying Firm No. 10194033
704 Central Parkway East | Suite 1200 | Plano, TX 75074 | 972.201.3100



VICINITY MAP
N.T.S.

LEGEND

- Point of Curvature or Tangency on Center Line
- 1/2" Iron rod set with a yellow plastic cap stamped "JVC" (unless otherwise noted)
- 1/2" IRF (unless otherwise noted)

AC Acre
BL Building Line
C1 Curve No.
<CM> Control Monument
DE Drainage Easement
DUE Drainage Utility Easement
Esmt Easement
L1 Line No.
SF Square Feet
UE Utility Easement
VE Visibility Easement
SE Sidewalk Easement
D.R.R.C.T.= Deed Records of Rockwall County, Texas
P.R.R.C.T.= Plat Records of Rockwall County, Texas



100 50 0 100 200
SCALE 1" = 100'

FINAL PLAT LOTS 1-8, BLOCK A PEOPLES TRACT ADDITION

BEING 8 LOTS
15.561 ACRES OR 677,846 SQ. FT.
8 SINGLE FAMILY LOTS
SITUATED IN THE
WILLIAM DALTON SURVEY, ABSTRACT NO. 72
CITY OF ROCKWALL,
ROCKWALL COUNTY, TEXAS
P2024-009

July 15, 2024
SHEET 1 OF 2

RECORD DRAWING

To the best of our knowledge, Johnson Volk Consulting, Inc., hereby states that this plan is As-Built. This information provided is based on surveying at the site and information provided by the contractor. The original sealed drawings are on file at the offices of:


Johnson Volk Consulting, Inc.

Owner:
Estate of Michael L Peoples, SR
Andrea Danley, Independent Executor
P.O. Box 41
Rockwall, Texas 75087

Developer:
Michael Joyce Properties
767 Justin Rd
Rockwall, Texas 75087
Phone: 512-965-6280

Engineer/Surveyor:
Johnson Volk Consulting, Inc.
704 Central Parkway East, Suite. 1200
Plano, Texas 75074
Phone: 972-201-3100
Contact: Tom Dayton, PE

**JOHNSON VOLK
CONSULTING**
TBPELS: Engineering Firm No. 11962 / Land Surveying Firm No. 10194033
704 Central Parkway East | Suite 1200 | Plano, TX 75074 | 972.201.3100

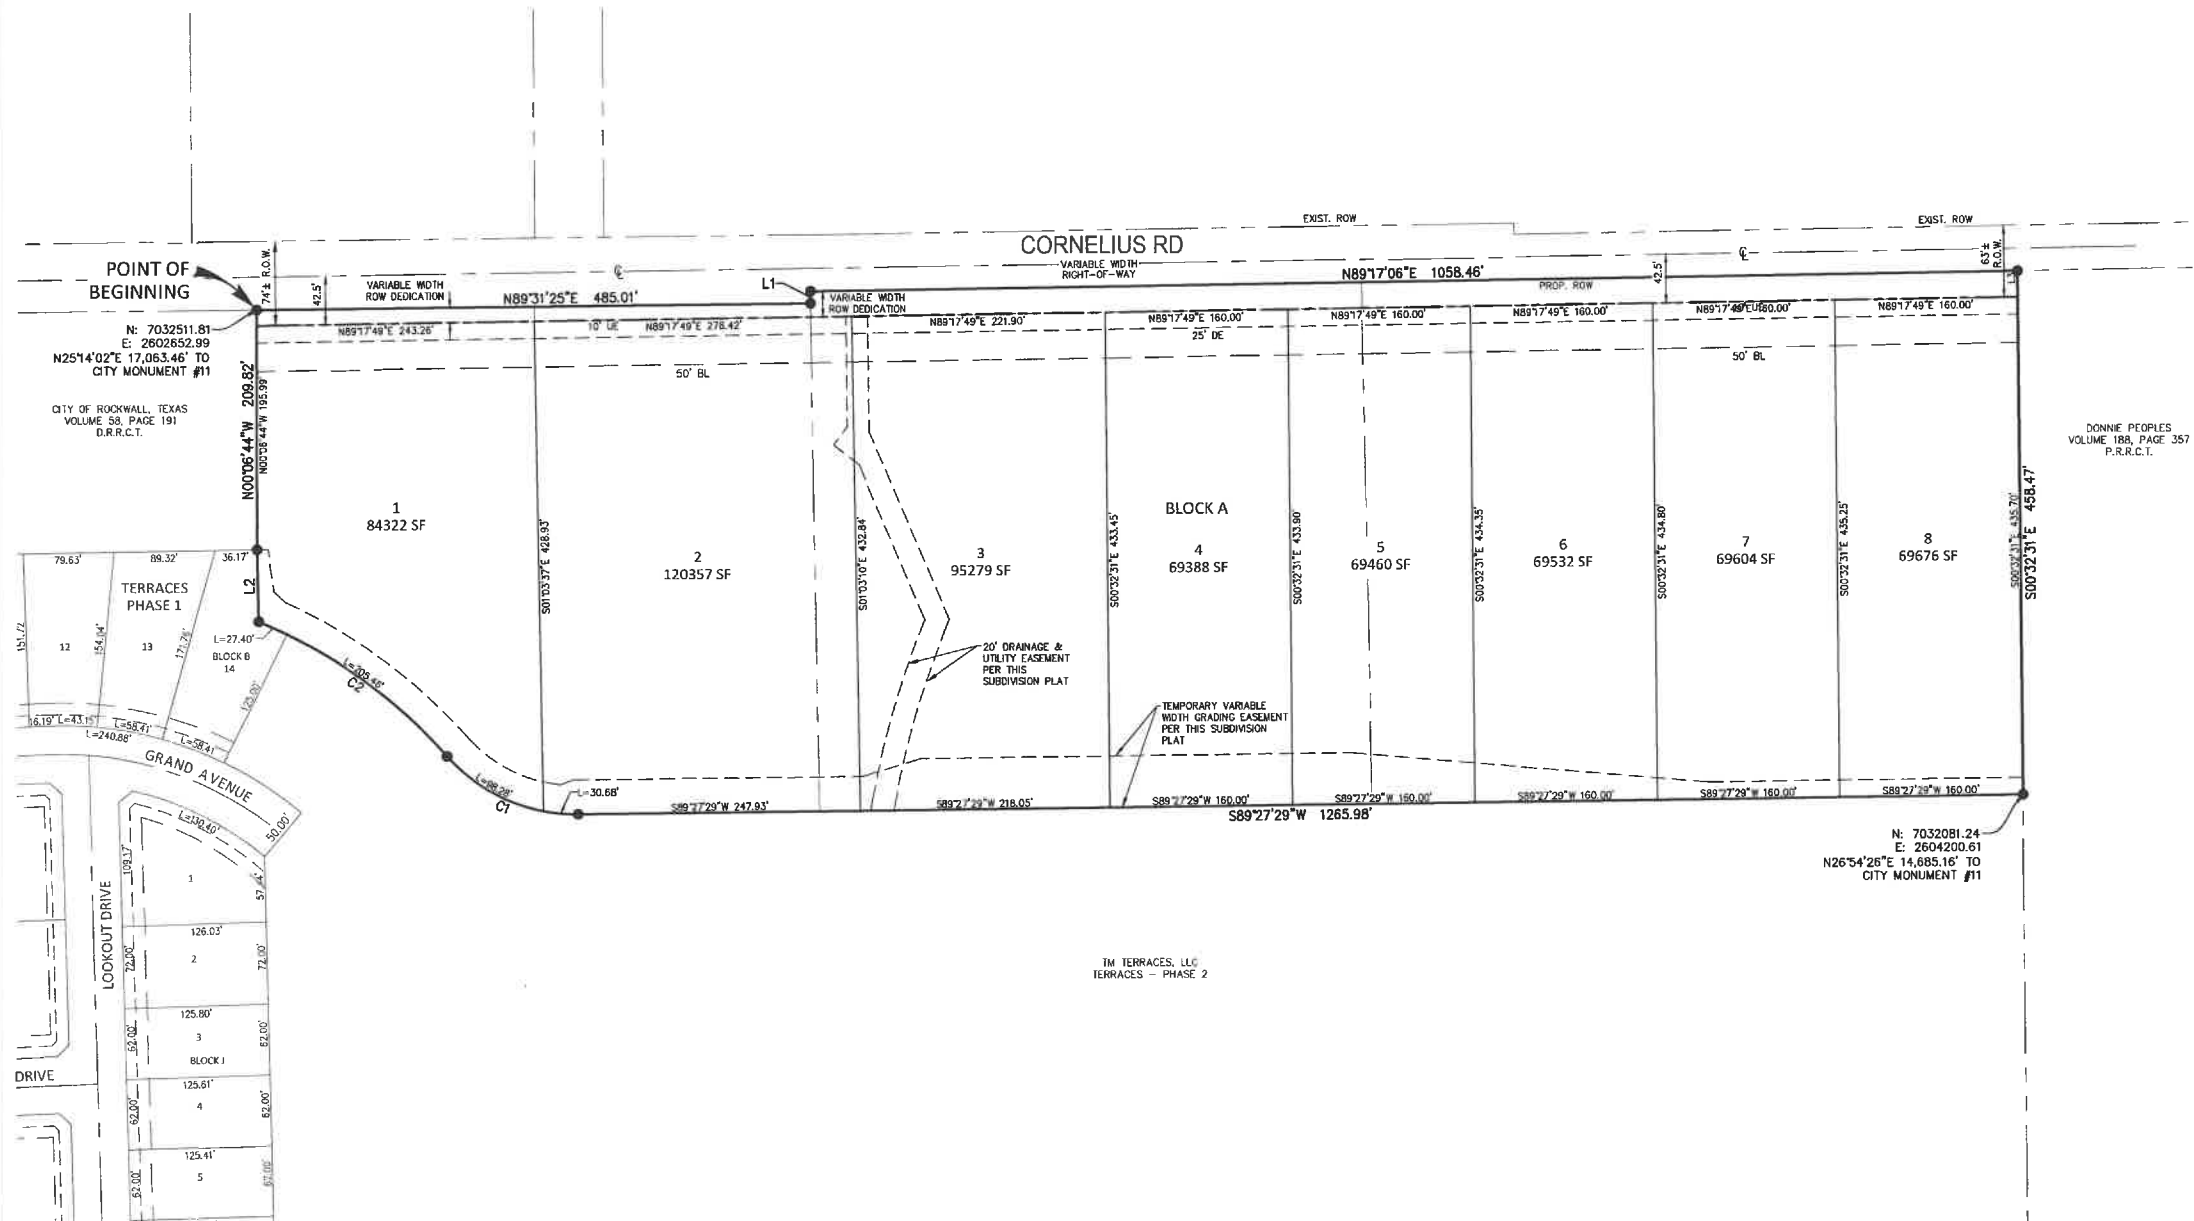

GENERAL NOTES:

- ALL LOT CORNERS MONUMENTED WITH A 1/2" IRON ROD WITH A YELLOW PLASTIC CAP STAMPED "JVC" UNLESS OTHERWISE NOTED.
- SUBDIVIDER'S STATEMENT. SELLING A PORTION OF THIS ADDITION BY METES AND BOUNDS IS UNLAWFUL AND A VIOLATION OF THE SUBDIVISION ORDINANCE OF THE CITY AND CHAPTER 212, MUNICIPAL REGULATION OF SUBDIVISIONS AND PROPERTY DEVELOPMENT, OF THE TEXAS LOCAL GOVERNMENT CODE, AND SHALL BE SUBJECT TO THE CITY WITHHOLDING UTILITIES AND BUILDING PERMITS.
- BASIS OF BEARING AND COORDINATES SHOWN HEREON REFER TO "TEXAS STATE PLANE COORDINATE SYSTEM, NORTH CENTRAL ZONE (4202), NORTH AMERICAN DATUM OF 1983 ON GRID COORDINATE VALUES. DIRECTION FOR CONTROL ESTABLISHED THROUGH <CM1> AND <CM2> HAVING A BEARING AND DISTANCE OF S29°53'54"E, 2,758.60'.
- LOCATION OF 1% ANNUAL FLOOD CHANCE ESTIMATED FROM FEMA FIRM PANEL 48139C0325F DATED JUNE 3, 2013.
- LOTS ADJACENT TO FLOODPLAIN SHALL HAVE A MINIMUM FINISHED FLOOR ELEVATION 2' ABOVE THE 100-YR WSEL.
- PUBLIC IMPROVEMENT STATEMENT. IT SHALL BE THE POLICY OF THE CITY OF ROCKWALL TO WITHHOLD ISSUING BUILDING PERMITS UNTIL ALL STREETS, WATER, SEWER AND STORM DRAINAGE SYSTEMS HAVE BEEN ACCEPTED BY THE CITY. THE APPROVAL OF A SUBDIVISION PLAT BY THE CITY DOES NOT CONSTITUTE ANY REPRESENTATION, ASSURANCE OR GUARANTEE THAT ANY BUILDING WITHIN SUCH SUBDIVISION PLAT SHALL BE APPROVED, AUTHORIZED OR PERMIT ISSUED, NOR SHALL SUCH APPROVAL CONSTITUTE ANY REPRESENTATION, ASSURANCE OR GUARANTEE BY THE CITY OF THE ADEQUACY AND AVAILABILITY FOR WATER AND SANITARY SEWER FOR PERSONAL USE AND FIRE PROTECTION WITHIN SUCH SUBDIVISION PLAT, AS REQUIRED UNDER THE SUBDIVISION ORDINANCE OF THE CITY.
- DRAINAGE AND DETENTION EASEMENTS. THE PROPERTY OWNER SHALL BE RESPONSIBLE FOR MAINTAINING, REPAIRING AND REPLACING AND SHALL BEAR SOLE RESPONSIBILITY OF ALL SYSTEMS WITHIN THE DRAINAGE AND DETENTION EASEMENTS.
- ALL OPEN SPACE, PARKS & GREEN BELTS SHALL BE PRIVATE AND MAINTAINED, REPLACED AND REPAIRED BY HOA/PROPERTY OWNER.
- STREET APPURTENANCES. ALL DECORATIVE SIGNAGE, POSTS OR LIGHTS INSTALLED IN PUBLIC RIGHT-OF-WAY SHALL BE INSTALLED, MAINTAINED, REPAIRED, AND REPLACED BY THE HOMEOWNER'S ASSOCIATION (HOA).
- FIRE LANES. ALL FIRE LANES WILL BE CONSTRUCTED, MAINTAINED, REPAIRED AND REPLACED BY THE PROPERTY OWNER. FIRE LANES SHALL BE CONSTRUCTED IN ACCORDANCE WITH THE APPROVED CIVIL ENGINEERING PLANS FOR BOTH ON-SITE AND OFF-SITE LANE IMPROVEMENTS.

Line Table		
Line	Length	Direction
L1	10.64	N00° 28' 35"W
L2	63.06	N01° 28' 22"W
L3	12.77	N00° 32' 31"W

Curve Table					
Curve #	Length	Radius	Delta	Chord Length	Chord Bearing
C1	128.96	150.00	049°15'27"	125.02	N65° 54' 48"W
C2	205.46	450.00	026°09'34"	203.68	N54° 21' 52"W

LEGAL DESCRIPTION:

BEING a tract of land situated in the William Dalton Survey, Abstract Number 72 Rockwall County, Texas and being portions of those tracts of land conveyed to Mike Peoples, according to the documents filed of record in Volume 1679, Page 190, Volume 1679, Page 196, Volume 173, Page 752 and Volume 184, Page 522, Deed Records Rockwall County, Texas (D.R.R.C.T.) and being more particularly described as follows:

BEGINNING at a point for the northeast corner of that tract of land conveyed to the City of Rockwall, Texas according to the document filed of record in Volume 58, Page 191, (D.R.R.C.T.) same being the northwest corner of the tract of land described herein;

THENCE, North 89 degrees 31 minutes 25 seconds East, a distance of 485.01 feet to a point for a corner of this tract;

THENCE, North 00 degrees 28 minutes 35 seconds West, a distance of 10.64 feet to a point for a corner of this tract;

THENCE, North 89 degrees 17 minutes 06 seconds East, a distance of 1058.46 feet to a point for the northwest corner of that tract of land conveyed to Donnie Peoples according to the document filed of record in Volume 188, Page 357 (D.R.R.C.T.) and being the common northeast corner of this tract;

THENCE, South 00 degrees 32 minutes 31 seconds East, with the west line of said Donnie Peoples tract, same being common with the east line of this tract, a distance of 458.47 feet to a point for the southeast corner of this tract;

THENCE, South 89 degrees 27 minutes 29 seconds West, leaving said common line, a distance of 1265.98 feet to a point for a corner of this tract and being the beginning of a curve to the right, having a central angle of 49° 15' 27", a radius of 150.00 feet, and a long chord bearing and distance of North 65 degrees 54 minutes 48 seconds West, 125.02 feet;

THENCE, with said curve to the right an arc distance of 128.96 feet to a point for a corner of this tract and the beginning of a non-tangent curve to the left, having a central angle of 26° 09' 34", a radius of 450.00 feet, and a long chord bearing and distance of North 54 degrees 21 minutes 52seconds West, 203.68 feet;

THENCE, with said curve to the left an arc distance of 205.46 feet to a point in the east line of Terraces Phase One, an addition to the City of Rockwall, Rockwall County, Texas according to the plat filed of record in Document Number 20240000000459 Plat Records Rockwall County, Texas for the most westerly southwest corner of this tract;

THENCE, North 01 degrees 28 minutes 22 seconds West, with said east line, a distance of 63.06 feet to a point for the northeast corner of said addition, same being the common southeast corner of the above-mentioned City of Rockwall tract and a common corner of this tract;

THENCE North 00 degrees 06 minutes 44 seconds West, with the east line of said City of Rockwall tract and common west line of this tract, a distance of 209.82 feet to the POINT OF BEGINNING and containing 677,846 square feet or 15.561 acres of land.

OWNER'S CERTIFICATION:

NOW THEREFORE, KNOW ALL MEN BY THESE PRESENTS:

STATE OF TEXAS §
COUNTY OF ROCKWALL §

I, the undersigned owner of the land shown on this plat, and designated herein as the PEOPLES TRACT subdivision to the City of Rockwall, Texas, and whose name is subscribed hereto, hereby dedicate to the use of the public forever any streets, alleys, parks, water courses, drains, easements and public places thereon shown on the purpose and consideration therein expressed. I further certify that all other parties who have a mortgage or lien interest in the PEOPLES TRACT subdivision have been notified and signed this plat. I understand and do hereby reserve the easement strips shown on this plat for the purposes stated and for the mutual use and accommodation of all utilities desiring to use or using same. I also understand the following:

1. No buildings shall be constructed or placed upon, over, or across the utility easements as described herein.
2. Any public utility shall have the right to remove and keep removed all or part of any buildings, fences, trees, shrubs, or other growths or improvements which in any way endanger or interfere with construction, maintenance or efficiency of their respective system on any of these easement strips; and any public utility shall at all times have the right of ingress or egress to, from and upon the said easement strips for purpose of construction, reconstruction, inspecting, patrolling, maintaining, and either adding to or removing all or part of there respective system without the necessity of, at any time, procuring the permission of anyone.
3. The City of Rockwall will not be responsible for any claims of any nature resulting from or occasioned by the establishment of grade of streets in the subdivision.
4. The developer and subdivision engineer shall bear total responsibility for storm drain improvements.
5. The developer shall be responsible for the necessary facilities to provide drainage patterns and drainage controls such that properties within the drainage area are not adversely affected by storm drainage from the development.
6. No house dwelling unit, or other structure shall be constructed on any lot in this addition by the owner or any other person until the developer and/or owner has complied with all requirements of the Subdivision Regulations of the City of Rockwall regarding improvements with respect to the entire block on the street or streets on which property abuts, including the actual installation of streets with the required base and paving, curb and gutter, water and sewer, drainage structures, storm sewers, and alleys all according to the specifications of the City of Rockwall; or

Until an escrow deposit, sufficient to pay for the cost of such improvements, as determined by the city's engineer and/or city administrator, computed on a private commercial rate basis, has been made with the city secretary, accompanied by an agreement signed by the developer and/or owner, authorizing the city to make such improvements at prevailing private commercial rates, or have the same made by a contractor and pay the same out of the escrow deposit, should the developer and/or owner fail to refuse to install the required improvements within the time stated in such written agreement, but in no case shall the City be obligated to make such improvements itself. Such deposit may be used by the owner and/or developer as progress payments as the work progresses in making such improvements by making certified requisitions to the city secretary, supported by evidence of work done; or

Until the developer and/or owner files a corporate surety bond with the city secretary in a sum equal to the cost of such improvements for the designated area, guaranteeing the installation thereof within the time stated in the bond, which shall be fixed by the city council of the City of Rockwall.

I further acknowledge that the dedications and/or exactions made herein are proportional to the impact of the Subdivision upon the public services required in order that the development will comport with the present and future growth needs of the City; I, my (our) successors and assigns hereby waive any claim, damage, or cause of action that I may have as a result of the dedication of exactions made herein.

Signature _____
Name _____
Title _____

STATE OF TEXAS §
COUNTY OF DALLAS §

BEFORE ME, the undersigned authority, on this day personally appeared _____ of Micheal L. Peoples, known to me to be the person whose name is subscribed to the foregoing instrument and acknowledged to me that he executed the same for the purpose and consideration therein stated.

Given under my hand and seal of office, this ____ day of _____, 2024.

Notary public in and for the State of Texas

My Commission Expires

SURVEYOR'S CERTIFICATE:

NOW, THEREFORE KNOW ALL MEN BY THESE PRESENTS:

THAT I, Ryan S. Reynolds, do hereby certify that I prepared this plat from an actual and accurate survey of the land, and that the corner monuments shown thereon were properly placed under my personal supervision.

RYAN S. REYNOLDS, R.P.L.S.
Texas Registered Professional Land Surveyor No. 6385.

STATE OF TEXAS §
COUNTY OF COLLIN §

BEFORE ME, the undersigned authority, on this day personally appeared Ryan S. Reynolds, known to me to be the person whose name is subscribed to the above and foregoing instrument, and acknowledged to me that he executed the same for the purposes and consideration expressed and in the capacity therein stated.

Given under my hand and seal of office, this ____ day of _____, 2024.

Notary public for and in the State of Texas

My commission expires: _____

Planning & Zoning Commission, Chairperson

Date

APPROVED:
I hereby certify that the above and foregoing plat of an addition to the City of Rockwall, Texas be approved by the City Council of the City of Rockwall on ____ day of _____, 2024.

This approval shall be invalid unless the approved plat for such addition is recorded in the office of the County Clerk of Rockwall, County, Texas, within one hundred eighty (180) days from said date of approval.

WITNESS OUR HANDS, this ____ day of _____, 2024.

Mayor, City of Rockwall

City Secretary

City Engineer

RECORD DRAWING

To the best of our knowledge, Johnson Volk Consulting, Inc., hereby states that this plan is As-Built. This information provided is based on surveying at the site and information provided by the contractor. The original sealed drawings are on file at the offices of:

Johnson Volk Consulting, Inc.

Owner:
Estate of Michael L Peoples, SR
Andrea Danley, Independent Executor
P.O. Box 41
Rockwall, Texas 75087

Developer:
Michael Joyce Properties
787 Justin Rd
Rockwall, Texas 75087
Phone: 512-965-6280

Engineer/Surveyor:
Johnson Volk Consulting, Inc.
704 Central Parkway East, Suite. 1200
Plano, Texas 75074
Phone: 972-201-3100
Contact: Tom Dayton, PE



 **JOHNSON VOLK CONSULTING**
TBPELS: Engineering Firm No. 11962 / Land Surveying Firm No. 10194033
704 Central Parkway East | Suite 1200 | Plano, TX 75074 | 972.201.3100

FINAL PLAT
LOTS 1-8, BLOCK A
PEOPLES TRACT
ADDITION

BEING 8 LOTS
15.561 ACRES OR 677,846 SQ. FT.
8 SINGLE FAMILY LOTS

SITUATED IN THE
WILLIAM DALTON SURVEY, ABSTRACT NO. 72
CITY OF ROCKWALL,
ROCKWALL COUNTY, TEXAS
P2024-009

July 15, 2024
SHEET 2 OF 2

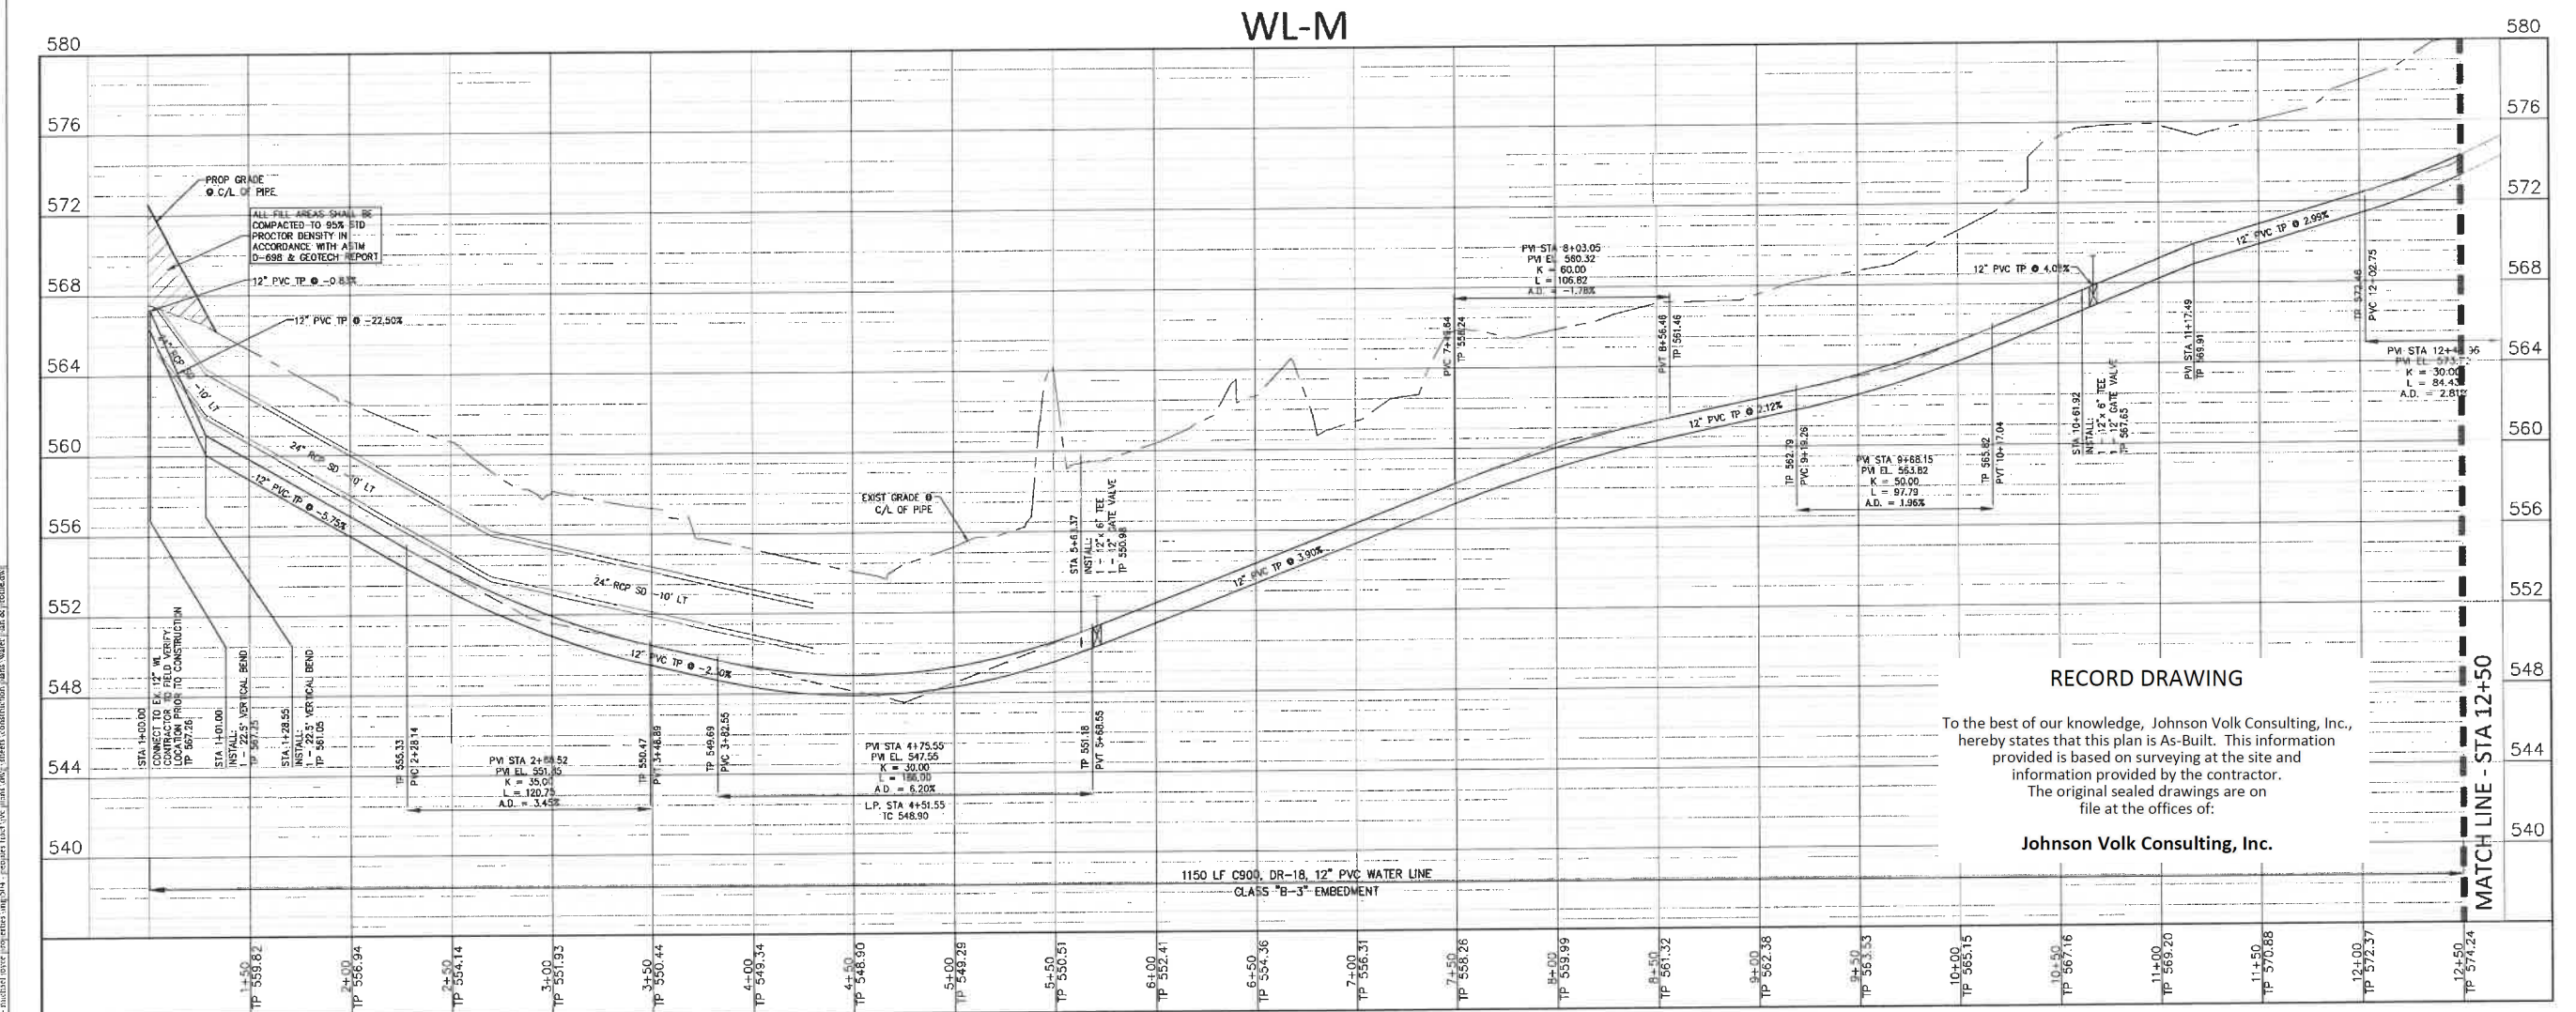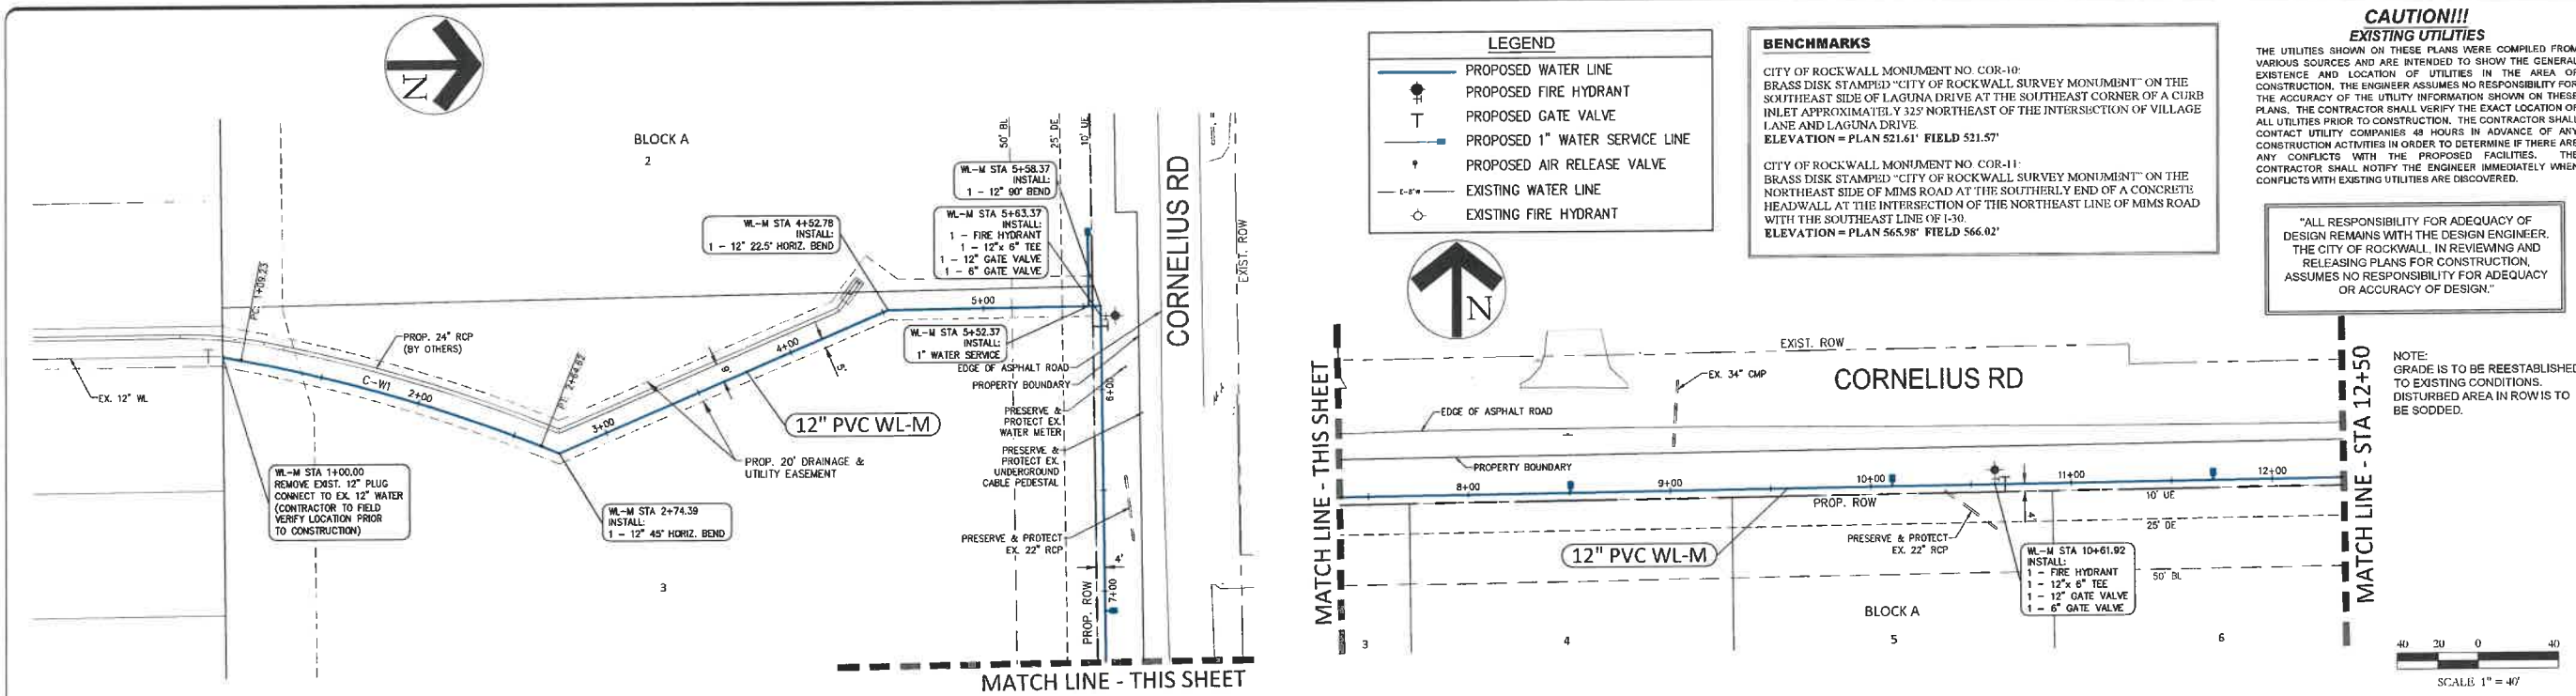

JOHNSON VOLK CONSULTING

PEOPLES TRACT
CITY OF ROCKWALL
ROCKWALL COUNTY, TEXAS

WATER PLAN & PROFILE
STA 1+00 TO 12+50

STATE OF TEXAS
THOMAS K. DAYTON
91751
LICENSED PROFESSIONAL ENGINEER

08/05/2024

JVC No. MJP504

5

LEGEND	
	PROPOSED WATER LINE
	PROPOSED FIRE HYDRANT
	PROPOSED GATE VALVE
	PROPOSED 1" WATER SERVICE LINE
	PROPOSED AIR RELEASE VALVE
	EXISTING WATER LINE
	EXISTING FIRE HYDRANT

BENCHMARKS


CITY OF ROCKWALL MONUMENT NO. COR-10:
BRASS DISK STAMPED "CITY OF ROCKWALL SURVEY MONUMENT" ON THE
SOUTHEAST SIDE OF LAGUNA DRIVE AT THE SOUTHEAST CORNER OF A CURB
INLET APPROXIMATELY 325' NORTHEAST OF THE INTERSECTION OF VILLAGE
LANE AND LAGUNA DRIVE.
ELEVATION = PLAN 521.61' FIELD 521.57'

CITY OF ROCKWALL MONUMENT NO. COR-11:
BRASS DISK STAMPED "CITY OF ROCKWALL SURVEY MONUMENT" ON THE
NORTHEAST SIDE OF MIMS ROAD AT THE SOUTHERLY END OF A CONCRETE
HEADWALL AT THE INTERSECTION OF THE NORTHEAST LINE OF MIMS ROAD
WITH THE SOUTHEAST LINE OF I-30
ELEVATION = PLAN 565.98' FIELD 566.02'



CAUTION!!!
EXISTING UTILITIES

THE UTILITIES SHOWN ON THESE PLANS WERE COMPILED FROM
VARIOUS SOURCES AND ARE INTENDED TO SHOW THE GENERAL
EXISTENCE AND LOCATION OF UTILITIES IN THE AREA OF
CONSTRUCTION. THE ENGINEER ASSUMES NO RESPONSIBILITY FOR
THE ACCURACY OF THE UTILITY INFORMATION SHOWN ON THESE
PLANS. THE CONTRACTOR SHALL VERIFY THE EXACT LOCATION OF
ALL UTILITIES PRIOR TO CONSTRUCTION. THE CONTRACTOR SHALL
CONTACT UTILITY COMPANIES 48 HOURS IN ADVANCE OF ANY
CONSTRUCTION ACTIVITIES IN ORDER TO DETERMINE IF THERE ARE
ANY CONFLICTS WITH THE PROPOSED FACILITIES. THE
CONTRACTOR SHALL NOTIFY THE ENGINEER IMMEDIATELY WHEN
CONFLICTS WITH EXISTING UTILITIES ARE DISCOVERED.

"ALL RESPONSIBILITY FOR ADEQUACY OF
DESIGN REMAINS WITH THE DESIGN ENGINEER.
THE CITY OF ROCKWALL, IN REVIEWING AND
RELEASING PLANS FOR CONSTRUCTION,
ASSUMES NO RESPONSIBILITY FOR ADEQUACY
OR ACCURACY OF DESIGN."

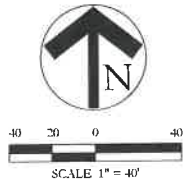

NOTE:
GRADE IS TO BE REESTABLISHED
TO EXISTING CONDITIONS.
DISTURBED AREA IN ROW IS TO
BE SODDIED.

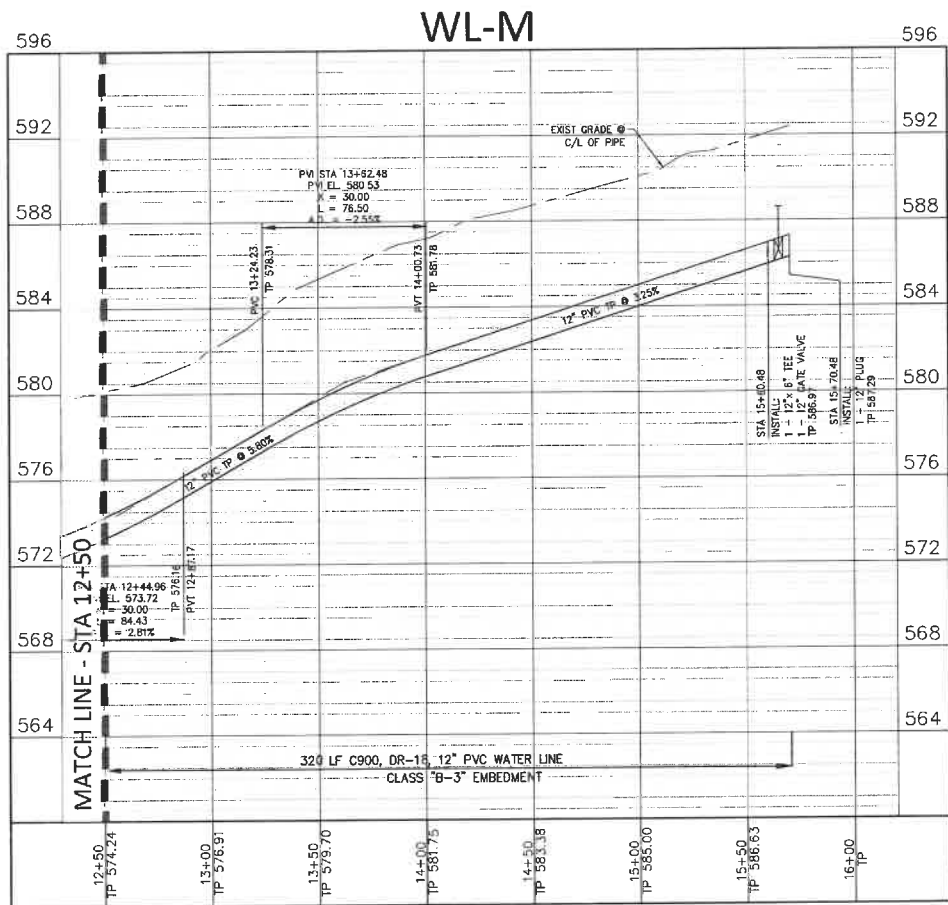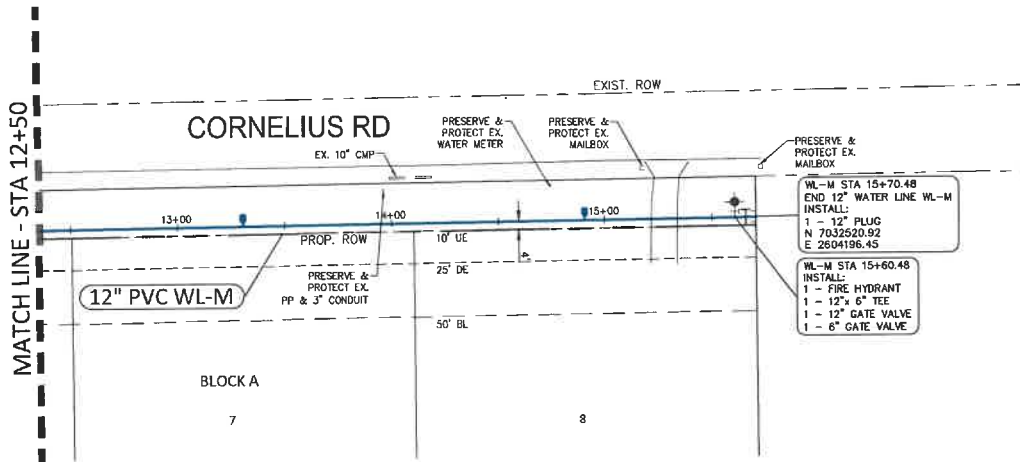

RECORD DRAWING

To the best of our knowledge, Johnson Volk Consulting, Inc.,
hereby states that this plan is As-Built. This information
provided is based on surveying at the site and
information provided by the contractor.
The original sealed drawings are on
file at the offices of:

Johnson Volk Consulting, Inc.

BENCHMARKS


CITY OF ROCKWALL MONUMENT NO. COR-10:
BRASS DISK STAMPED "CITY OF ROCKWALL SURVEY MONUMENT" ON THE
SOUTHEAST SIDE OF LAGUNA DRIVE AT THE SOUTHEAST CORNER OF A CURB
INLET APPROXIMATELY 325' NORTHEAST OF THE INTERSECTION OF VILLAGE
LANE AND LAGUNA DRIVE.
ELEVATION = PLAN 521.61' FIELD 521.57'

CITY OF ROCKWALL MONUMENT NO. COR-11:
BRASS DISK STAMPED "CITY OF ROCKWALL SURVEY MONUMENT" ON THE
NORTHEAST SIDE OF MIMS ROAD AT THE SOUTHERLY END OF A CONCRETE
HEADWALL AT THE INTERSECTION OF THE NORTHEAST LINE OF MIMS ROAD
WITH THE SOUTHEAST LINE OF I-30.
ELEVATION = PLAN 565.98' FIELD 566.02'

RECORD DRAWING

To the best of our knowledge, Johnson Volk Consulting, Inc.,
hereby states that this plan is As-Built. This information
provided is based on surveying at the site and
information provided by the contractor.
The original sealed drawings are on
file at the offices of:


Johnson Volk Consulting, Inc.

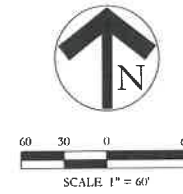

LEGEND	
	SILT FENCE
	STAGED INLET PROTECTION
	ROCK CHECK DAM
	CONSTRUCTION ENTRANCE (30' x 80')
	LIMITS OF DISTURBED AREA
	FLOW ARROW
	EXISTING CONTOUR
	PROPOSED CONTOUR
	EXISTING STORM DRAIN LINE & INLET
	PROPOSED STORM DRAIN LINE & INLET

CAUTION!!!
EXISTING UTILITIES
THE UTILITIES SHOWN ON THESE PLANS WERE COMPILED FROM
VARIOUS SOURCES AND ARE INTENDED TO SHOW THE GENERAL
EXISTENCE AND LOCATION OF UTILITIES IN THE AREA OF
CONSTRUCTION. THE ENGINEER ASSUMES NO RESPONSIBILITY FOR
THE ACCURACY OF THE UTILITY INFORMATION SHOWN ON THESE
PLANS. THE CONTRACTOR SHALL VERIFY THE EXACT LOCATION OF
ALL UTILITIES PRIOR TO CONSTRUCTION. THE CONTRACTOR SHALL
CONTACT UTILITY COMPANIES 48 HOURS IN ADVANCE OF ANY
CONSTRUCTION ACTIVITIES IN ORDER TO DETERMINE IF THERE ARE
ANY CONFLICTS WITH THE PROPOSED FACILITIES. THE
CONTRACTOR SHALL NOTIFY THE ENGINEER IMMEDIATELY WHEN
CONFLICTS WITH EXISTING UTILITIES ARE DISCOVERED.

"ALL RESPONSIBILITY FOR ADEQUACY OF
DESIGN REMAINS WITH THE DESIGN ENGINEER.
THE CITY OF ROCKWALL, IN REVIEWING AND
RELEASING PLANS FOR CONSTRUCTION,
ASSUMES NO RESPONSIBILITY FOR ADEQUACY
OR ACCURACY OF DESIGN."

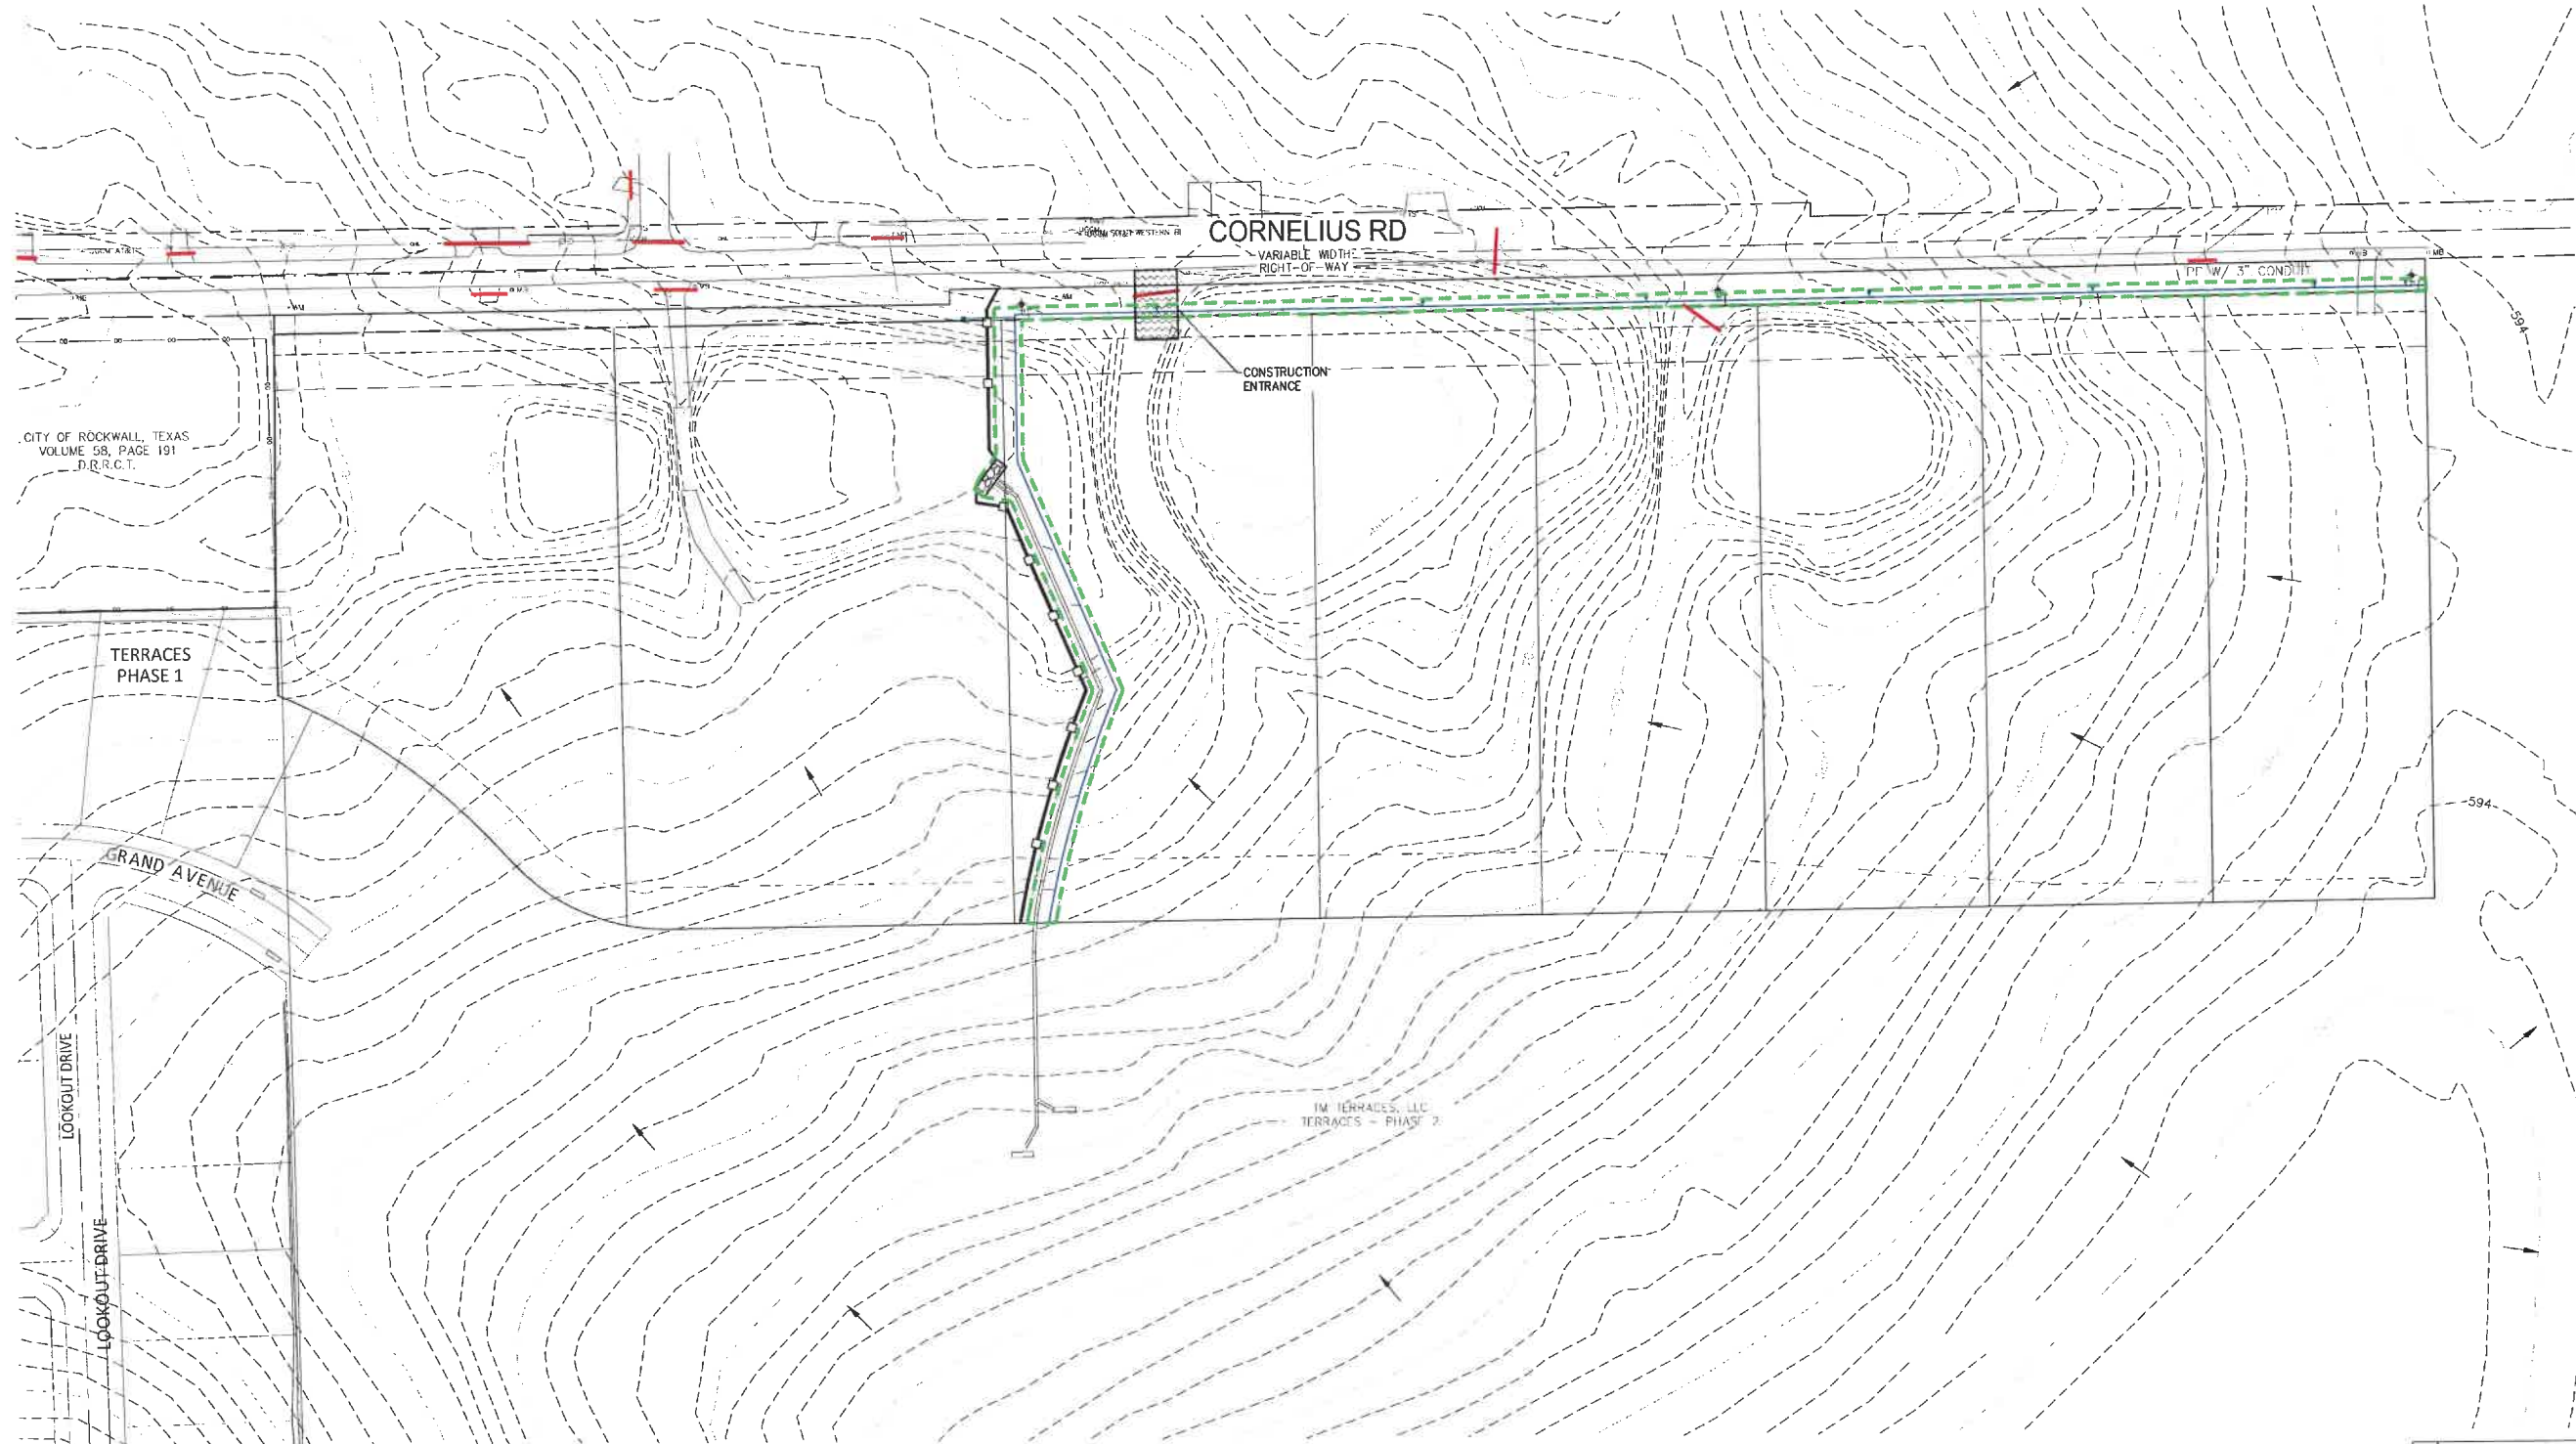


PEOPLES TRACT
CITY OF ROCKWALL
ROCKWALL COUNTY, TEXAS

EROSION CONTROL PLAN



JVC No. MJ/P504

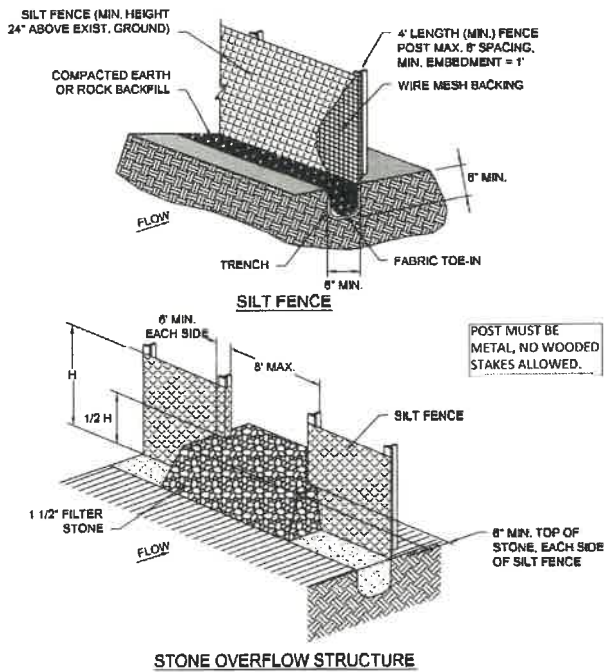

SILT FENCE	CITY OF ROCKWALL	STANDARD SPECIFICATION REFERENCE 202.5 *
		DATE Mar. 2018
		STANDARD DRAWING NO. R-1020A

Page 249

SILT FENCE GENERAL NOTES:

1. POSTS WHICH SUPPORT THE SILT FENCE SHALL BE INSTALLED ON A SLIGHT ANGLE TOWARD THE ANTICIPATED RUNOFF SOURCE. POST MUST BE EMBEDDED A MINIMUM OF ONE FOOT.
2. THE TOE OF THE SILT FENCE SHALL BE TRENCHED IN WITH A SPADE OR MECHANICAL TRENCHER, SO THAT THE DOWNSLOPE FACE OF THE TRENCH IS FLAT AND PERPENDICULAR TO THE LINE OF FLOW. WHERE FENCE CANNOT BE TRENCHED IN (e.g. PAVEMENT), WEIGHT FABRIC FLAP WITH ROCK ON UPHILL SIDE TO PREVENT FLOW FROM SEEPING UNDER FENCE.
3. THE TRENCH MUST BE A MINIMUM OF 6 INCHES DEEP AND 6 INCHES WIDE TO ALLOW FOR THE SILT FENCE FABRIC TO BE LAID IN THE GROUND AND BACKFILLED WITH COMPACTED MATERIAL.
4. SILT FENCE SHOULD BE SECURELY FASTENED TO EACH SUPPORT POST OR TO WIRE BACKING, WHICH IN TURN IS ATTACHED TO THE FENCE POST. THERE SHALL BE A 3 FOOT OVERLAP, SECURELY FASTENED WHERE ENDS OF FABRIC MEET.
5. INSPECTION SHALL BE AS SPECIFIED IN THE SWPPP. REPAIR OR REPLACEMENT SHALL BE MADE PROMPTLY AS NEEDED.
6. SILT FENCE SHALL BE REMOVED WHEN FINAL STABILIZATION IS ACHIEVED OR ANOTHER EROSION OR SEDIMENT CONTROL DEVICE IS EMPLOYED.
7. ACCUMULATED SILT SHALL BE REMOVED WHEN IT REACHES A DEPTH OF HALF THE HEIGHT OF THE FENCE. THE SILT SHALL BE DISPOSED OF AT AN APPROVED SITE AND IN SUCH A MANNER AS TO NOT CONTRIBUTE TO ADDITIONAL SILTATION.
8. FILTER STONE SHALL BE WRAPPED IN FILTER FABRIC AND BURIED SIX (6") INCHES MINIMUM.

SILT FENCE

CITY OF ROCKWALL

STANDARD SPECIFICATION REFERENCE
202.5 *

DATE
Mar. 2018

STANDARD DRAWING NO.
R-1020B

Page 250

ROCK CHECK DAM GENERAL NOTES:

1. STONE SHALL BE WELL GRADED WITH SIZE RANGE FROM 1½ TO 3½ INCHES IN DIAMETER DEPENDING ON EXPECTED FLOWS.
2. THE CHECK DAM SHALL BE INSPECTED AS SPECIFIED IN THE SWPPP AND SHALL BE REPLACED WHEN THE STRUCTURE CEASES TO FUNCTION AS INTENDED DUE TO SILT ACCUMULATION AMONG THE ROCKS, WASHOUT, CONSTRUCTION TRAFFIC DAMAGE, ETC.
3. WHEN SILT REACHES A DEPTH EQUAL TO ONE-THIRD OF THE HEIGHT OF THE CHECK DAM OR ONE FOOT, WHICHEVER IS LESS, THE SILT SHALL BE REMOVED AND DISPOSED OF PROPERLY.
4. WHEN THE SITE HAS ACHIEVED FINAL STABILIZATION OR ANOTHER EROSION OR SEDIMENT CONTROL DEVICE IS EMPLOYED, THE CHECK DAM AND ACCUMULATED SILT SHALL BE REMOVED AND DISPOSED OF IN AN APPROVED MANNER.
5. FILTER STONE SHALL BE WRAPPED IN APPROPRIATE SIZED WIRE MESH TO CONTAIN STONE AND BURIED SIX (6") INCHES MINIMUM.

ROCK CHECK DAM

CITY OF ROCKWALL

STANDARD SPECIFICATION REFERENCE
202.9 *

DATE
Mar. 2018

STANDARD DRAWING NO.
R-1060B

Page 251


CAUTION!!! EXISTING UTILITIES

THE UTILITIES SHOWN ON THESE PLANS WERE COMPILED FROM VARIOUS SOURCES AND ARE INTENDED TO SHOW THE GENERAL EXISTENCE AND LOCATION OF UTILITIES IN THE AREA OF CONSTRUCTION. THE ENGINEER ASSUMES NO RESPONSIBILITY FOR THE ACCURACY OF THE UTILITY INFORMATION SHOWN ON THESE PLANS. THE CONTRACTOR SHALL VERIFY THE EXACT LOCATION OF ALL UTILITIES PRIOR TO CONSTRUCTION. THE CONTRACTOR SHALL CONTACT UTILITY COMPANIES 48 HOURS IN ADVANCE OF ANY CONSTRUCTION ACTIVITIES IN ORDER TO DETERMINE IF THERE ARE ANY CONFLICTS WITH THE PROPOSED FACILITIES. THE CONTRACTOR SHALL NOTIFY THE ENGINEER IMMEDIATELY WHEN CONFLICTS WITH EXISTING UTILITIES ARE DISCOVERED.

"ALL RESPONSIBILITY FOR ADEQUACY OF DESIGN REMAINS WITH THE DESIGN ENGINEER. THE CITY OF ROCKWALL, IN REVIEWING AND RELEASING PLANS FOR CONSTRUCTION, ASSUMES NO RESPONSIBILITY FOR ADEQUACY OR ACCURACY OF DESIGN."

NOTES:


1. SOIL EROSION AND SEDIMENT CONTROL SHALL BE PROVIDED IN ACCORDANCE WITH CITY EROSION REGULATIONS.
2. RESPONSIBILITY FOR INSTALLATION, ROUTINE INSPECTION, AND MAINTENANCE OF EROSION CONTROL SHOULD BE DEFINED AND ASSIGNED TO APPROPRIATE PERSON(S) PRIOR TO COMMENCEMENT OF ANY SOIL DISTURBING ACTIVITY.
3. EROSION CONTROL MEASURES MUST BE CONSTRUCTED AND FUNCTION BEFORE ANY GRADING OR LAND DISTURBANCE TAKES PLACE.
4. TEMPORARY OR PERMANENT SOIL STABILIZATION MUST BE APPLIED TO DISTURBED AREA LEFT DORMANT FOR 14 DAYS.
5. IN THE EVENT THAT MEASURES BEING USED ARE DEEMED TO BE INEFFECTIVE BY CITY INSPECTORS, ADDITIONAL MEASURES OR CHANGES IN THE ORIGINAL PLAN MAY BE REQUIRED BY THE CITY.
6. ALL EROSION CONTROL DEVICES SHALL BE INSPECTED BY THE SITE FOREMAN DAILY. ANY STRUCTURE OR CONTROL DEVICES WHICH ARE DAMAGED OR INOPERATIVE, WILL BE REPAIRED OR REPLACED IMMEDIATELY.
7. SANITARY FACILITIES SHALL BE PROVIDED ON THE SITE & REGULARLY SERVICED AS RECOMMENDED BY THE SUPPLIER. TRASH & DEBRIS SHALL BE STORED IN COVERED BINS OR ENCLOSURES.
8. CONSTRUCTION ENTRANCES/EXITS SHOULD BE LIMITED AND PROTECTION PROVIDED TO PREVENT TRACKING OF SOILS ONTO CITY STREETS.
9. REMOVE SILT OR SEDIMENTS FROM STREETS, CURBS, GUTTERS, FLUMES, HANDICAP ACCESS RAMPS, CURB INLETS, STORM DRAINS, AND ANY OTHER PUBLIC DRAINAGE FACILITIES DAILY OR AS ACCUMULATION OCCURS.
10. EROSION CONTROL SHOULD BE EVALUATED TO DETERMINE THE EFFECTIVENESS OF THOSE DEVICES BY THE PERSON ASSIGNED TO INSPECT EROSION CONTROL DEVICES, AND CHANGES MADE IF NECESSARY.
11. SOIL TRACKED ONTO PUBLIC ROADS SHALL BE REMOVED DAILY IF FEASIBLE, OR WHEN VISIBLY ACCUMULATED SEDIMENT HAS BEEN DEPOSITED. DISCHARGED SEDIMENT SHALL BE REMOVED AS SOON AS POSSIBLE.
12. USING WASH WATER TO WASH SEDIMENT FROM STREETS IS PROHIBITED.
13. ALL EROSION CONTROL SHALL BE IN PLACE AND INSPECTED PRIOR TO BEGINNING CONSTRUCTION.

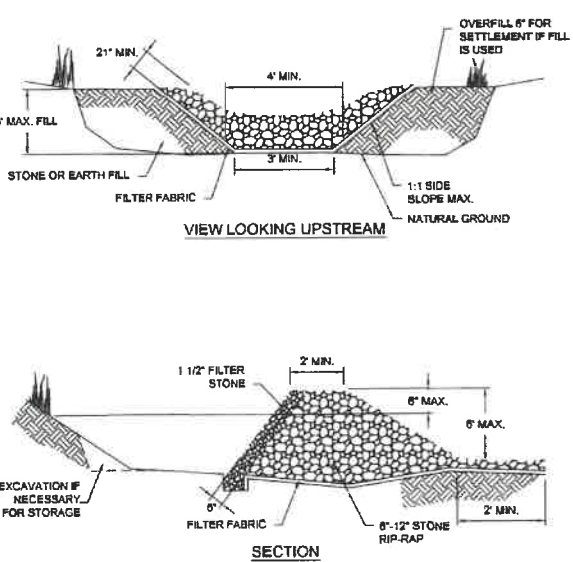


NOTE: FILTER STONE SHALL BE WRAPPED IN APPROPRIATE SIZED WIRE MESH TO CONTAIN STONE.

STONE OUTLET SEDIMENT TRAP	CITY OF ROCKWALL	STANDARD SPECIFICATION REFERENCE 202.12 *
		DATE Mar. 2018
		STANDARD DRAWING NO. R-1090

Page 254

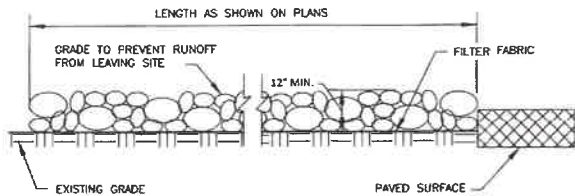

PROFILE VIEW
N.T.S.

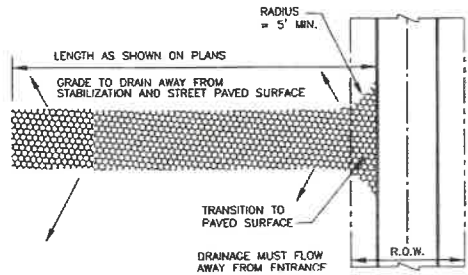

PLAN VIEW
N.T.S.

Note: No crushed concrete or recycled concrete allowed.

STABILIZED CONSTRUCTION ENTRANCE	CITY OF ROCKWALL	STANDARD SPECIFICATION REFERENCE 202.11 *
		DATE Mar. 2018
		STANDARD DRAWING NO. R-1070A

Page 252

STABILIZED CONSTRUCTION ENTRANCE GENERAL NOTES:

1. STONE SHALL BE 4 TO 6 INCH DIAMETER COARSE AGGREGATE.
2. MINIMUM LENGTH SHALL BE 50 FEET AND WIDTH SHALL BE 20 FEET.
3. THE THICKNESS SHALL NOT BE LESS THAN 12 INCHES.
4. THE WIDTH SHALL BE NO LESS THAN THE FULL WIDTH OF ALL POINTS OF INGRESS OR EGRESS.
5. WHEN NECESSARY, VEHICLES SHALL BE CLEANED TO REMOVE SEDIMENT PRIOR TO ENTRANCE ONTO A PUBLIC ROADWAY. WHEN WASHING IS REQUIRED, IT SHALL BE DONE ON AN AREA STABILIZED WITH CRUSHED STONE WITH DRAINAGE FLOWING AWAY FROM BOTH THE STREET AND THE STABILIZED ENTRANCE. ALL SEDIMENT SHALL BE PREVENTED FROM ENTERING ANY STORM DRAIN, DITCH OR WATERCOURSE USING APPROVED METHODS.
6. THE ENTRANCE SHALL BE MAINTAINED IN A CONDITION WHICH WILL PREVENT TRACKING OR FLOWING OF SEDIMENT ONTO PAVED SURFACES. THIS MAY REQUIRE PERIODIC TOP DRESSING WITH ADDITIONAL STONE AS CONDITIONS DEMAND. ALL SEDIMENT SPILLED, DROPPED, WASHED, OR TRACKED ONTO PAVED SURFACES MUST BE REMOVED IMMEDIATELY.
7. THE ENTRANCE MUST BE PROPERLY GRADED OR INCORPORATE A DRAINAGE SWALE TO PREVENT RUNOFF FROM LEAVING THE CONSTRUCTION SITE.
8. PREVENT SHORTCUTTING OF THE FULL LENGTH OF THE CONSTRUCTION ENTRANCE BY INSTALLING BARRIERS AS NECESSARY.
9. INSPECTION SHALL BE AS SPECIFIED IN THE SWPPP.
10. NO CRUSHED OR RECYCLED CONCRETE ALLOWED.

STABILIZED CONSTRUCTION ENTRANCE

CITY OF ROCKWALL

STANDARD SPECIFICATION REFERENCE
202.11 *

DATE
Mar. 2018





STANDARD DRAWING NO.
R-1070B

Page 253

RECORD DRAWING

To the best of our knowledge, Johnson Volk Consulting, Inc., hereby states that this plan is As-Built. This information provided is based on surveying at the site and information provided by the contractor.
The original sealed drawings are on file at the offices of:

Johnson Volk Consulting, Inc.

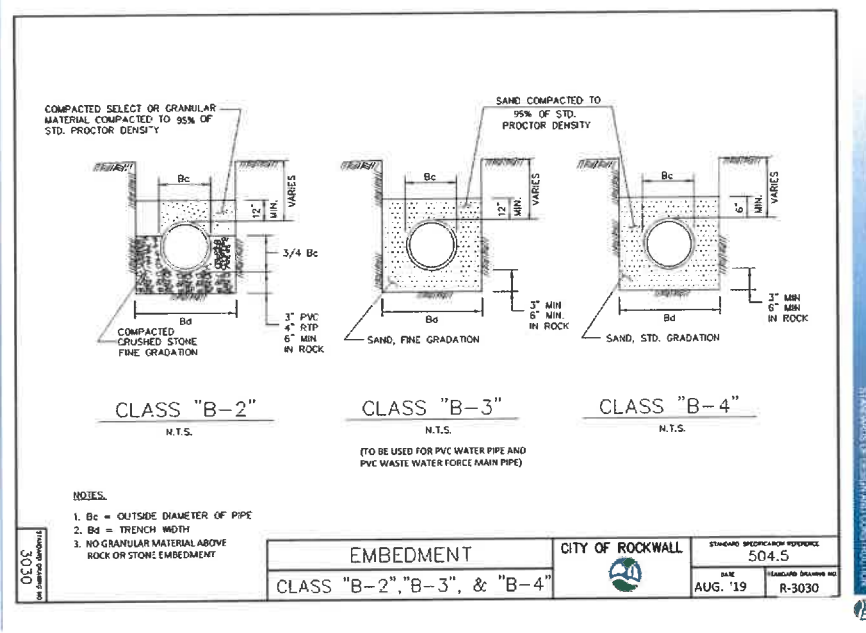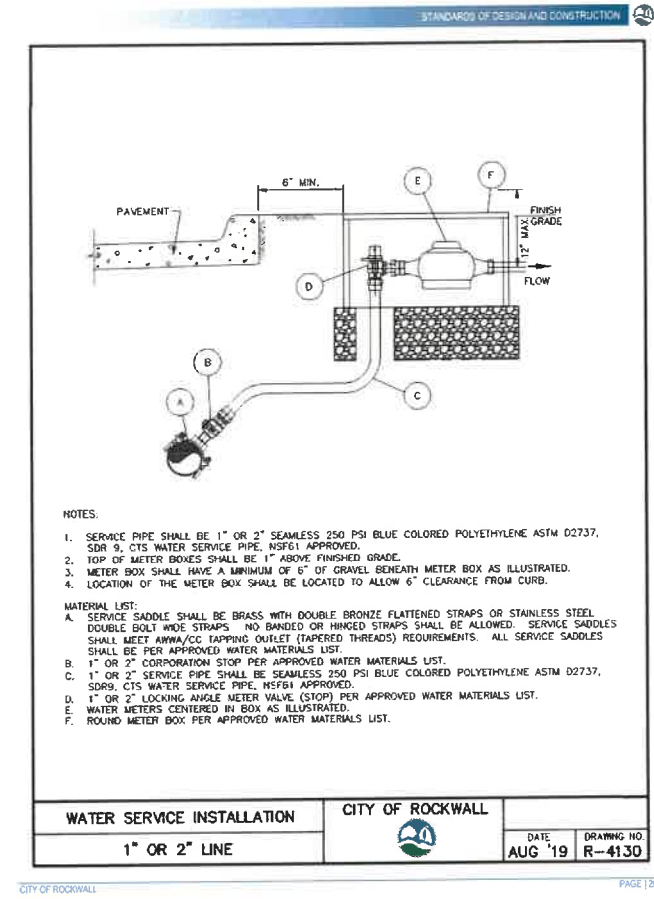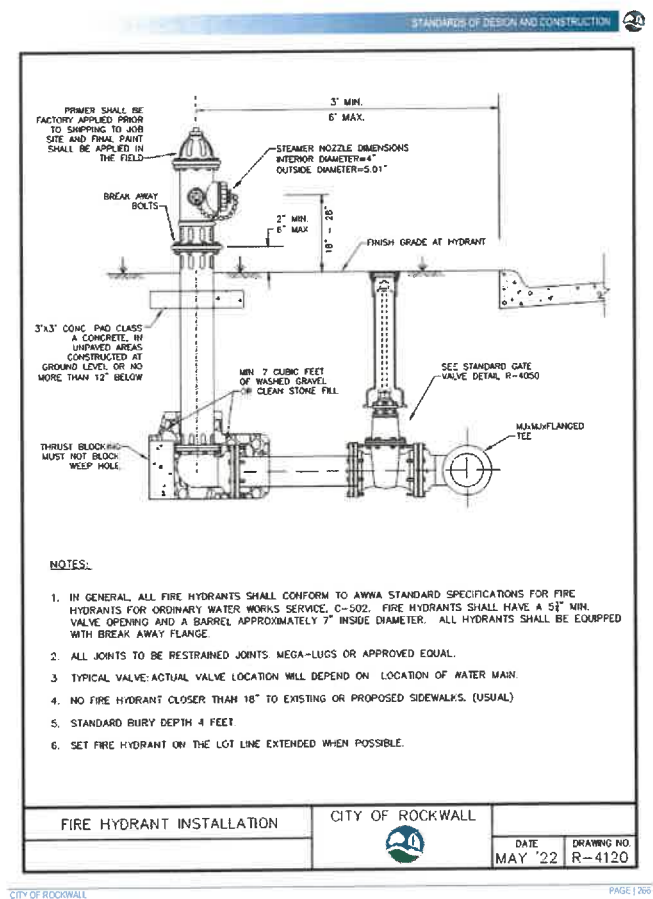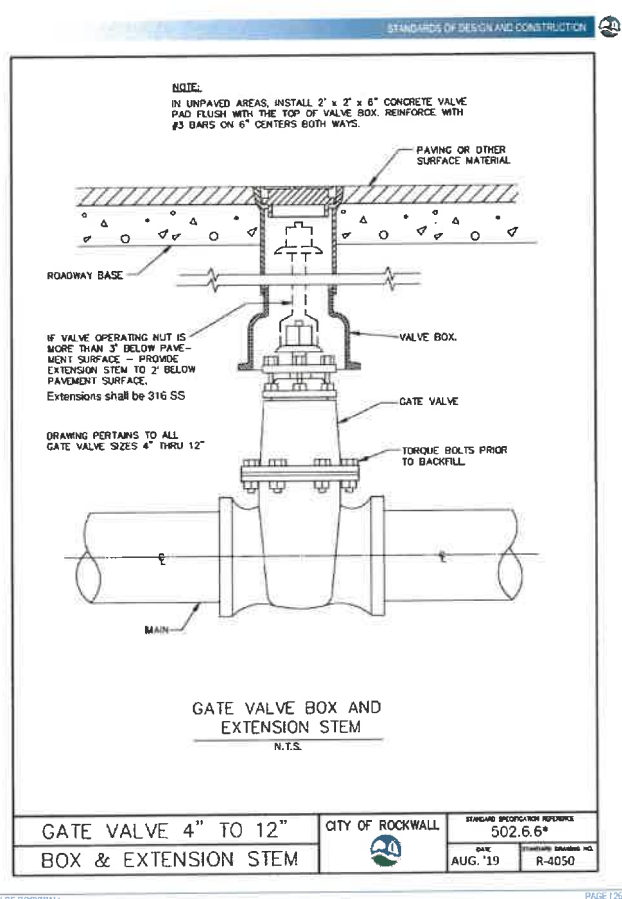

RECORD DRAWING

To the best of our knowledge, Johnson Volk Consulting, Inc., hereby states that this plan is As-Built. This information provided is based on surveying at the site and information provided by the contractor. The original sealed drawings are on file at the offices of:

Johnson Volk Consulting, Inc.