

VICINITY MAP N.T.S.

PFEFFER/INMAN ADDITION

2 LOTS - 1.6989 ACRES
J.D. McFARLAND SURVEY,
ABSTRACT NO. 145
CITY OF ROCKWALL,
ROCKWALL COUNTY, TEXAS

CONTACT INFORMATION:

Owner: Rockwall Salons, LLC, dba Salons Elite
P.O. Box 846, Seagoville, TX 75159
c/o Carol Inman (972) 768-4345

Contractor: Jackson Hunter, Inc, dba Parkview Homes
503 Stonebridge Dr., Rockwall, TX 75087
c/o Tommy Satterfield (972) 226-7489

Architect: LKS Designs Woods-Stovall
2201 Dottie Lynn Pkwy., Ste. 145,
Fort Worth, TX 76120
c/o Lance Stovall (817) 548-8714

Landscape Architect: T.H. Pritchett / Associates
1218 Camino Lago, Irving, TX 75039
c/o Tom Pritchett (972) 869-3535

Geotechnical Engineer: Hooper Group Consultants, Ltd
5729 Palo Pinto Ave., Dallas, TX 75206
c/o David Hooper (214) 824-1932

Surveyor: TerraCorp Associates, LLC
3960 Broadway Blvd., Ste. 236
Garland, TX 75043
c/o Ryan Alspaugh (972) 658-7008


Civil Engineer: Weldon Brown Engineering, LC
297 Waterford Way, Montgomery, TX 77356
c/o Reese Brown (832) 691-1581

CIVIL ENGINEERING PLAN SHEET INDEX:

PLT	FINAL PLAT
C-1	SITE PLAN
C-2	DRAINAGE AREA MAP
C-3	DIMENSION & PAVING PLAN
C-4	GRADING PLAN
C-5	STORM SEWER PROFILE
C-6	SANITARY & SWALE PROFILES
C-7	WATERLINE LAYOUT MAP

**WELDON BROWN
ENGINEERING, LC**

TBPE #10477
297 WATERFORD WAY
MONTGOMERY
TEXAS 77356
(832) 691-1581

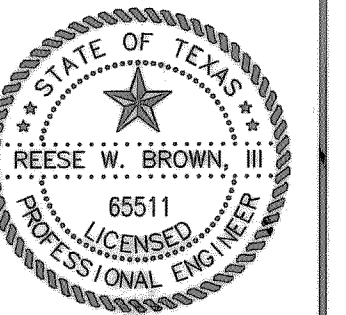

Reese W. Brown, III

THE SEAL AND SIGNATURE
APPEARING ON THIS
DOCUMENT WAS
AUTHORIZED BY
REESE W. BROWN, III, P.E.
TBPE #65511 ON
11-13-12

OWNER:
**ROCKWALL
SALONS, LLC
dba SALONS
ELITE**
P.O. BOX 846
SEAGOVILLE, TX
75159

TO THE BEST OF OUR KNOWLEDGE
WELDON BROWN ENGINEERING, LC
HEREBY STATES THAT THIS PLAN IS
AS-BUILT. THIS INFORMATION
PROVIDED IS BASED ON SURVEYING
AT THE SITE AND INFORMATION
PROVIDED BY THE CONTRACTOR.

PFEFFER/INMAN ADDITION
2 LOTS - 1.6989 ACRES
J.D. McFARLAND SURVEY, ABSTRACT NO. 145
CITY OF ROCKWALL, ROCKWALL COUNTY, TEXAS

SHEET TITLE:

AS-BUILT

DATE: 11/13/12