


Harold L. Evans
Rev. 5-17-11

BENCHMARK:
Top-of-Curb at the Northwest corner of the
existing paving on Highview Lane
Elevation 521.21

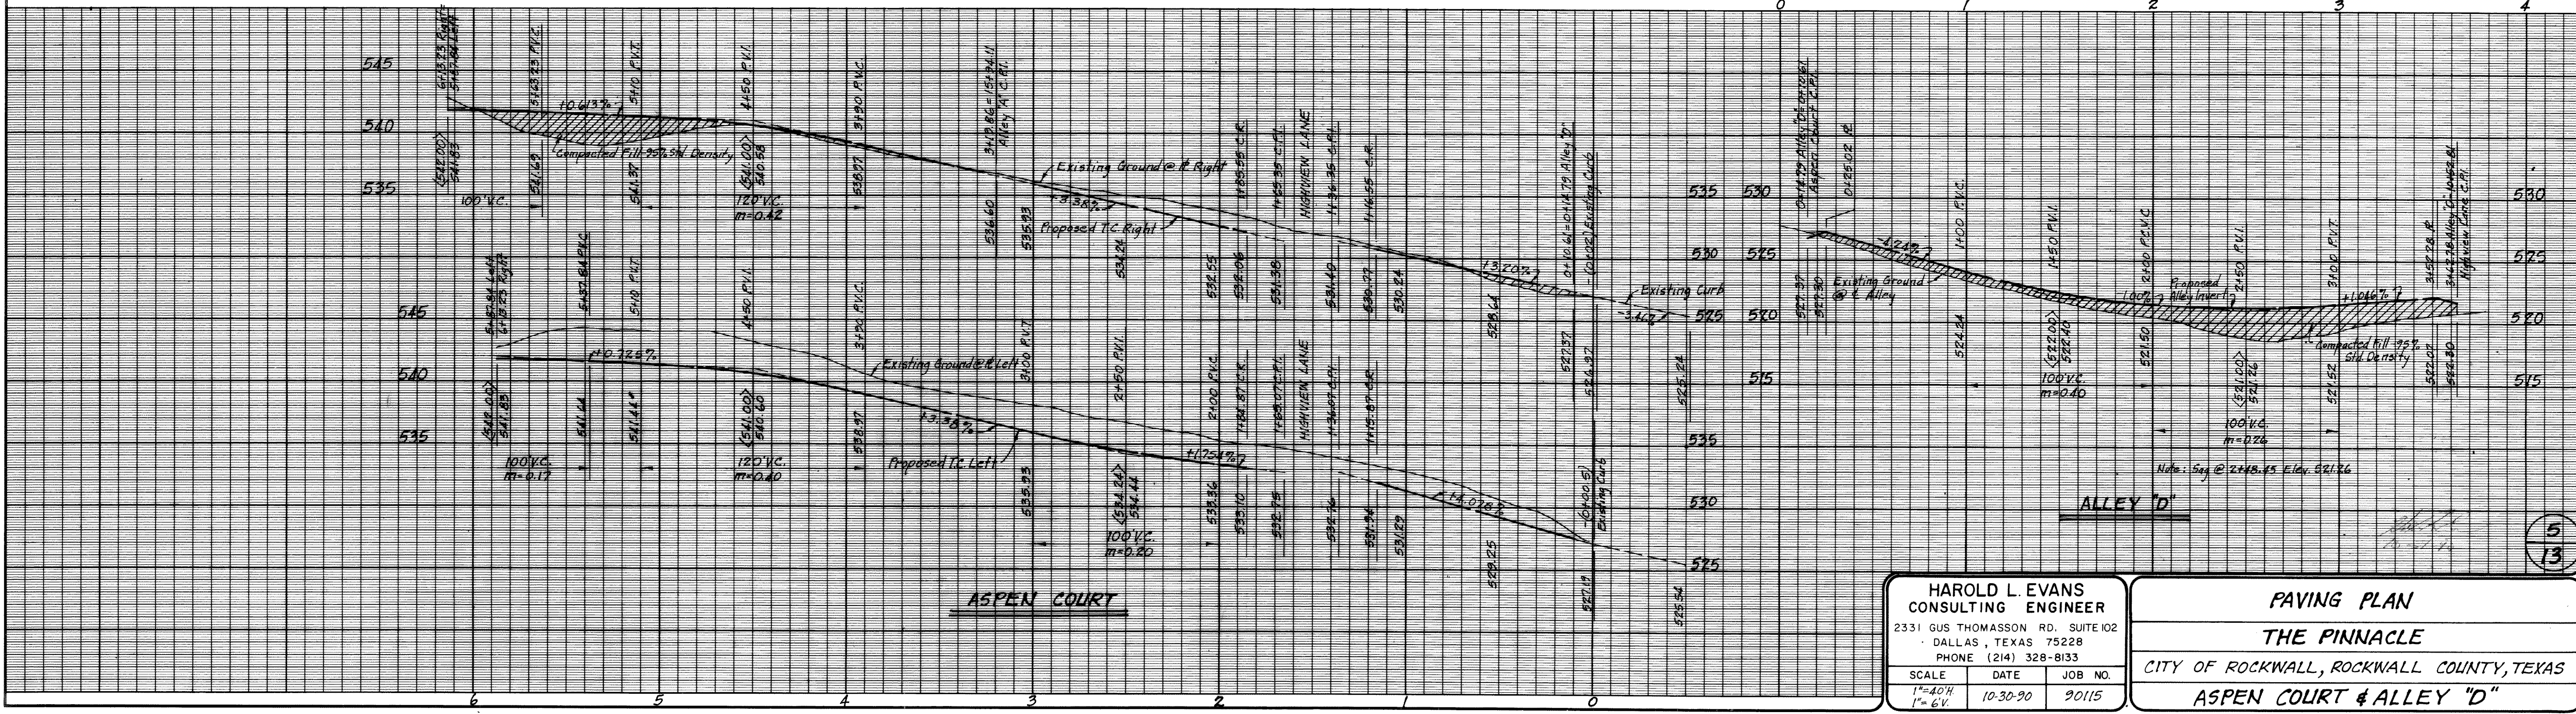

HAROLD L. EVANS CONSULTING ENGINEER 2331 GUS THOMASSON RD. SUITE 102 DALLAS, TEXAS 75228 PHONE (214) 328-8133		PAVING PLAN THE PINNACLE CITY OF ROCKWALL, ROCKWALL COUNTY, TEXAS ASPEN COURT & ALLEY "D"	
SCALE	DATE	JOB NO.	
1"=40'	10-30-90	20115	
1"=6V			