



24 L.F. Cross-tie
Wall 2' high

AS-BUILT



REV. 5-14-91

12
13

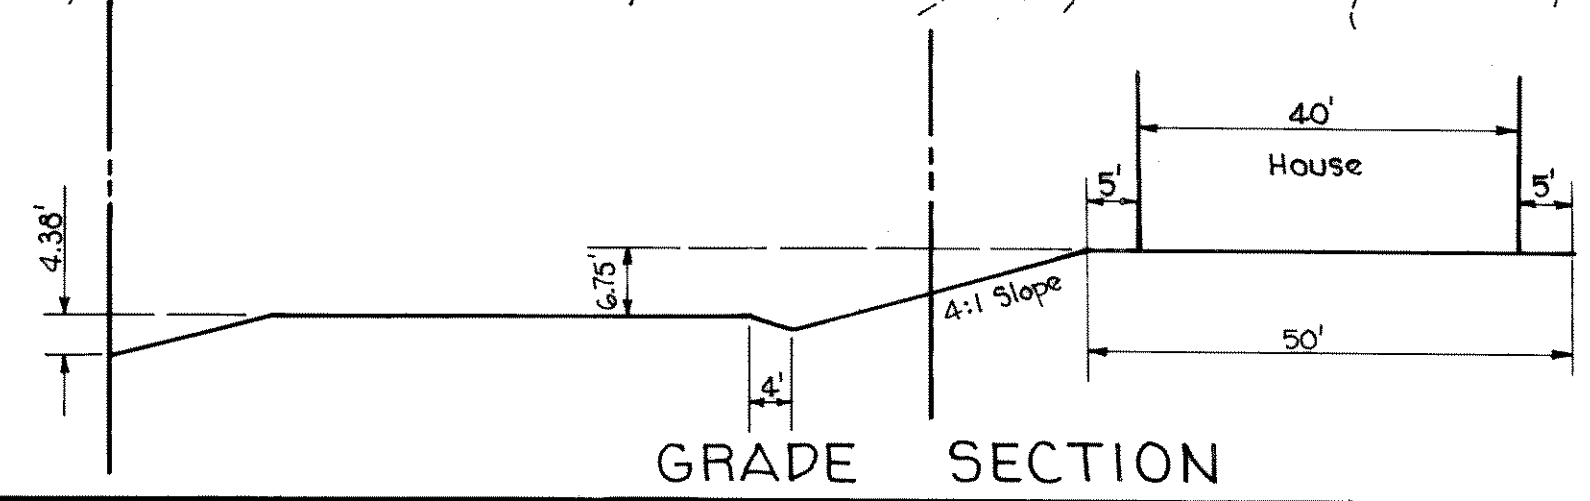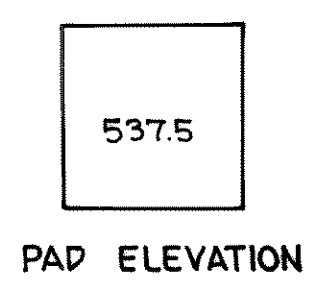

HAROLD L. EVANS
CONSULTING ENGINEER
2331 GUS THOMASSON RD. SUITE 102
DALLAS, TEXAS 75228
PHONE (214) 328-8133
SCALE DATE JOB NO.
1" = 40' 10-31-90 90115

GRADING PLAN
THE PINNACLE
CITY OF ROCKWALL, ROCKWALL CO., TEXAS