


**GRADING PLAN**  
**THE PINNACLE**  
 CITY OF ROCKWALL, ROCKWALL CO., TEXAS


HAROLD L. EVANS  
 CONSULTING ENGINEER  
 2331 GUS THOMASSON RD., SUITE 102  
 DALLAS, TEXAS 75228  
 PHONE (214) 328-8133

SCALE 1"=40'  
 DATE 10-31-90  
 JOB NO. 90115


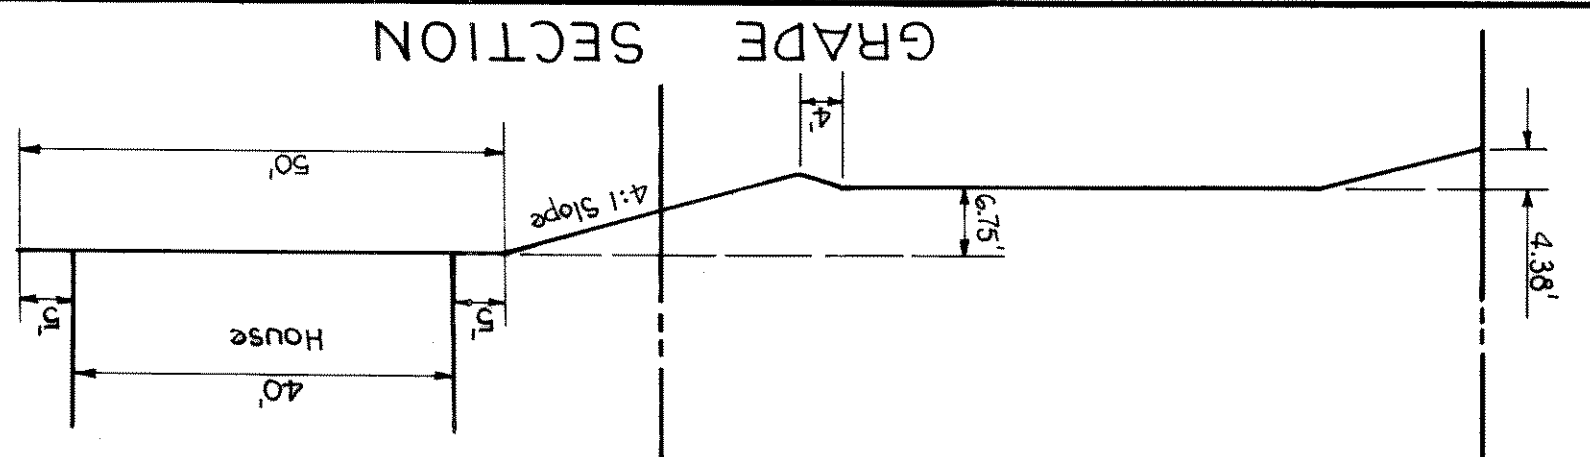


PAD ELEVATION  
 537.5

12  
 13

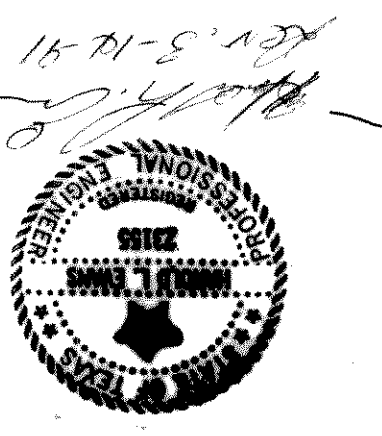

AS-BUILT

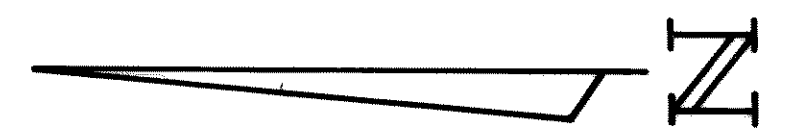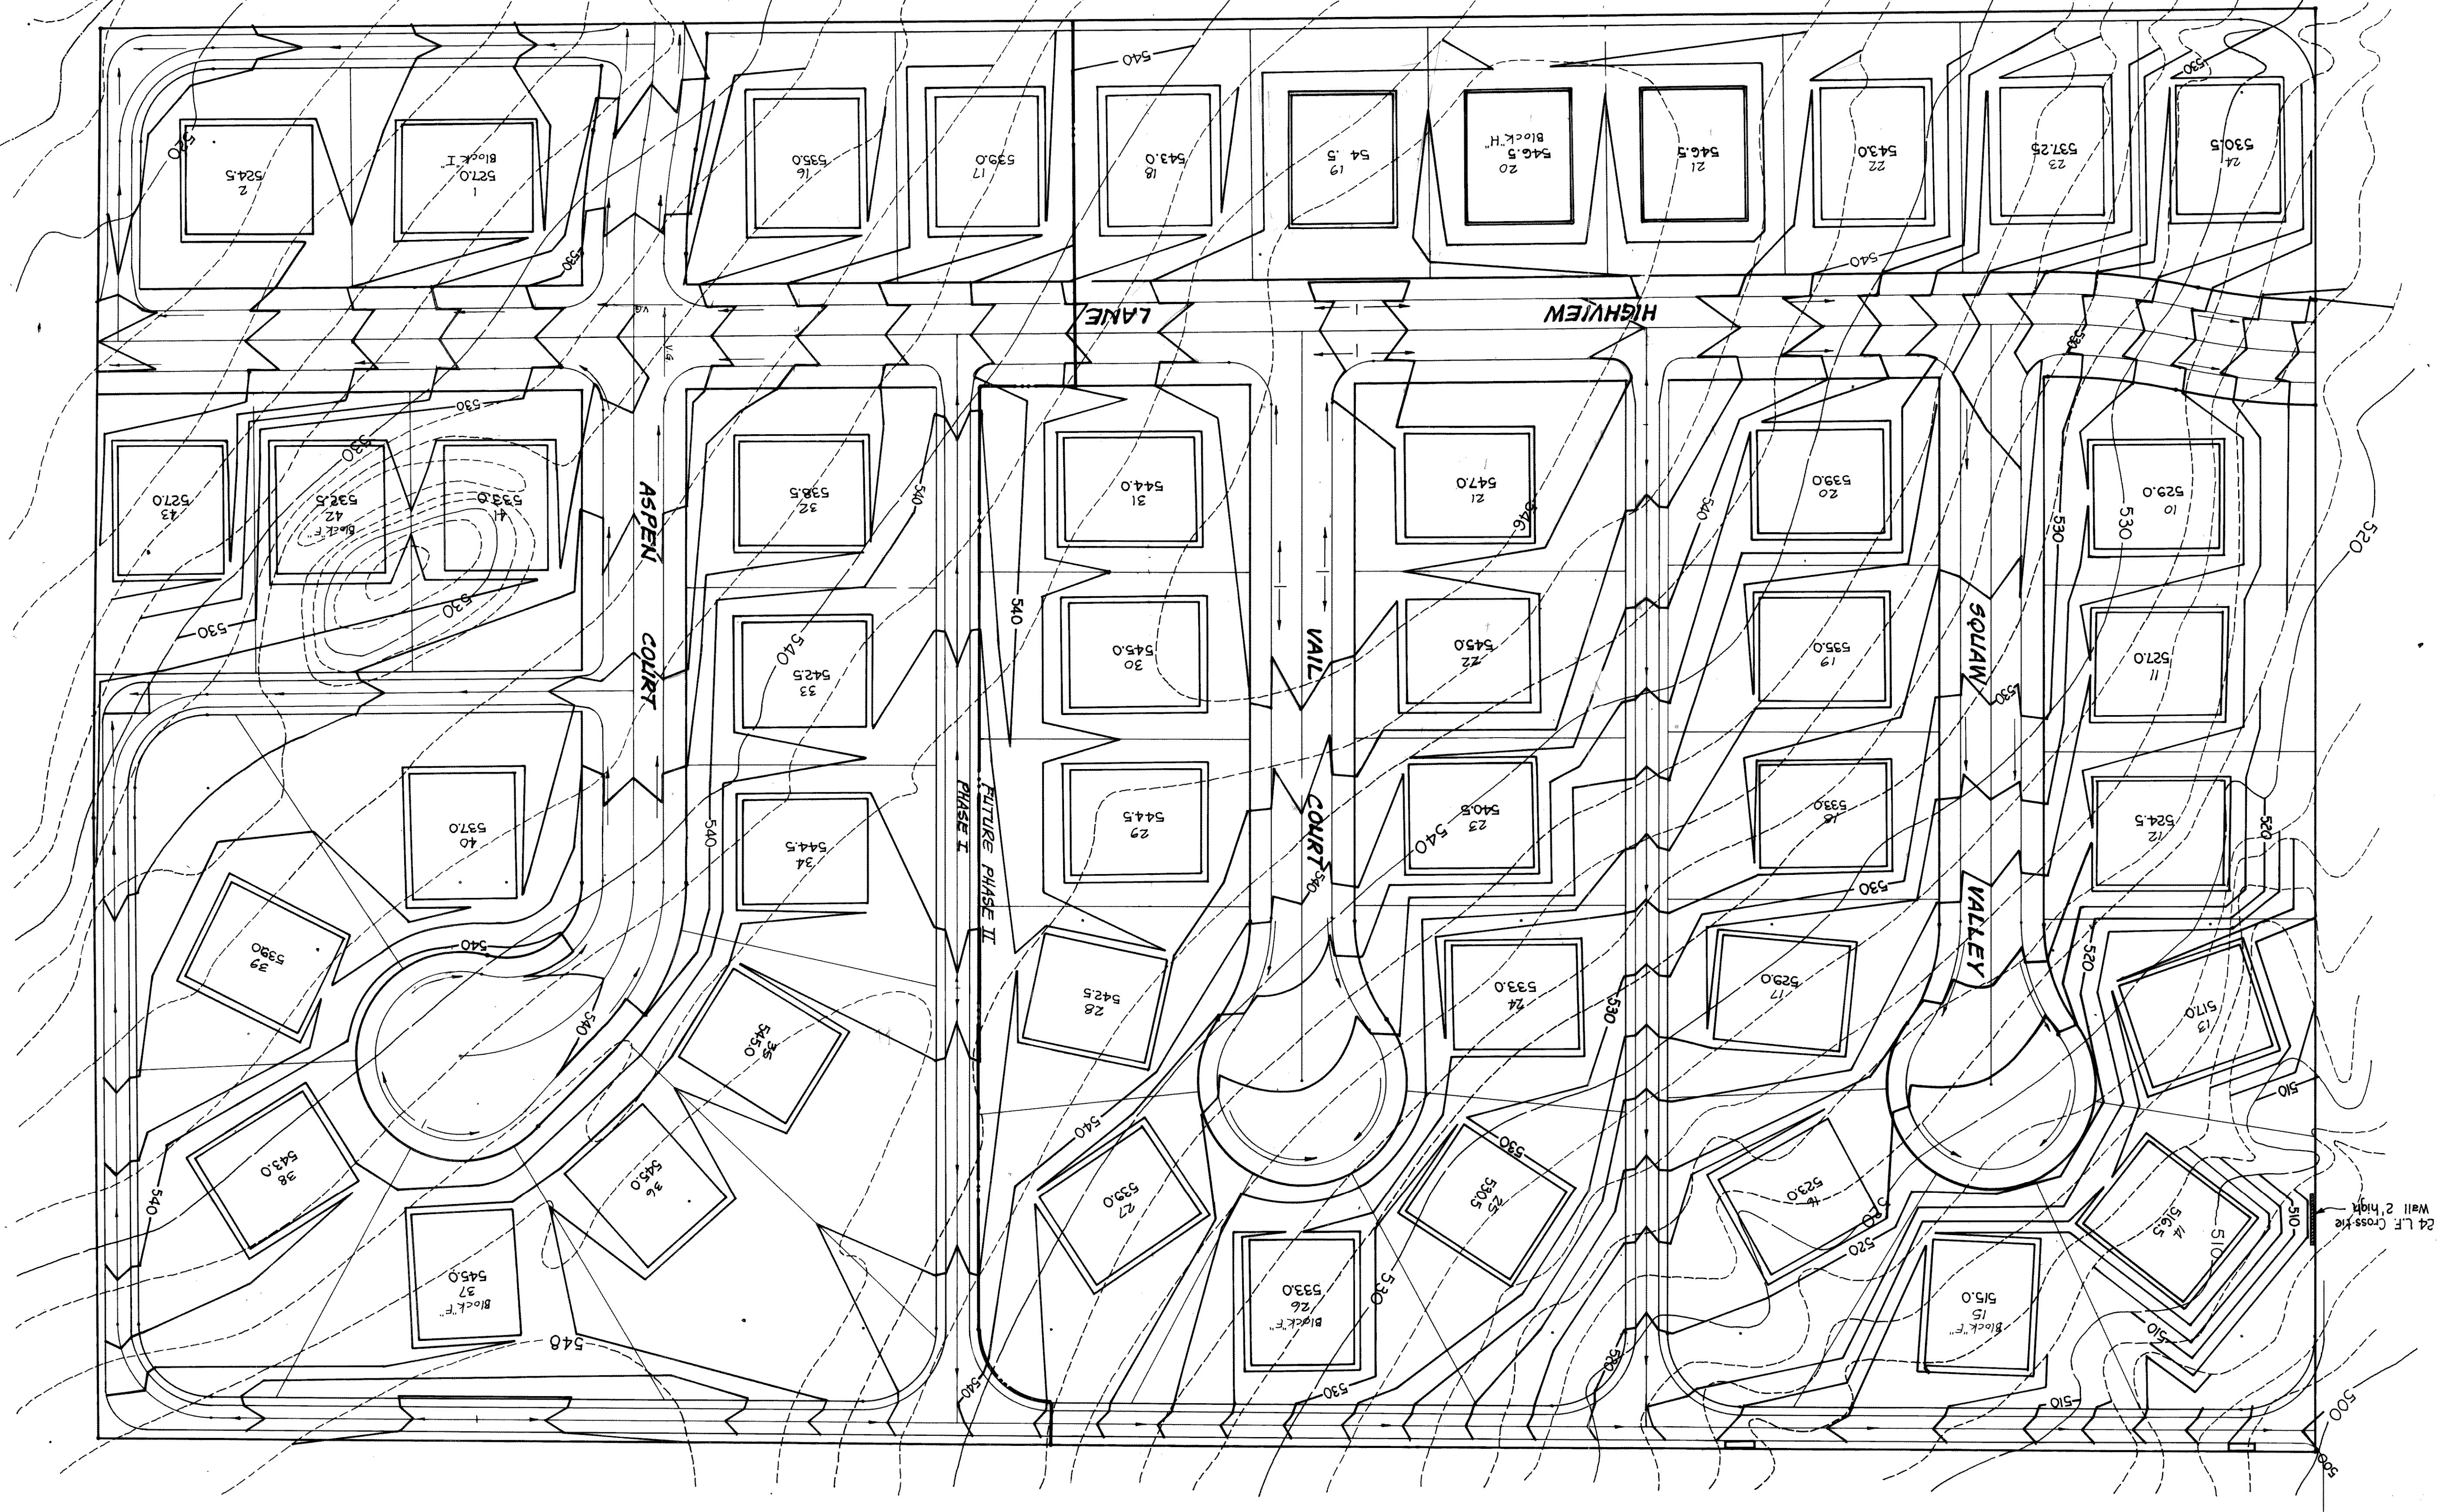

24" L.F. Cross-tie  
 Wall 2' high