



ALLEYS "B" & "C"
 CITY OF ROCKWALL, ROCKWALL COUNTY, TEXAS
 THE PINNACLE
 PAVING PLAN

HAROLD L. EVANS
 CONSULTING ENGINEER
 2331 GUS THOMASSON RD., SUITE 102
 DALLAS, TEXAS 75228
 PHONE (214) 328-8133
 SCALE 1"=40'
 DATE 10-29-90
 JOB NO. 90115
 Rev. 3-13-91

7
 13

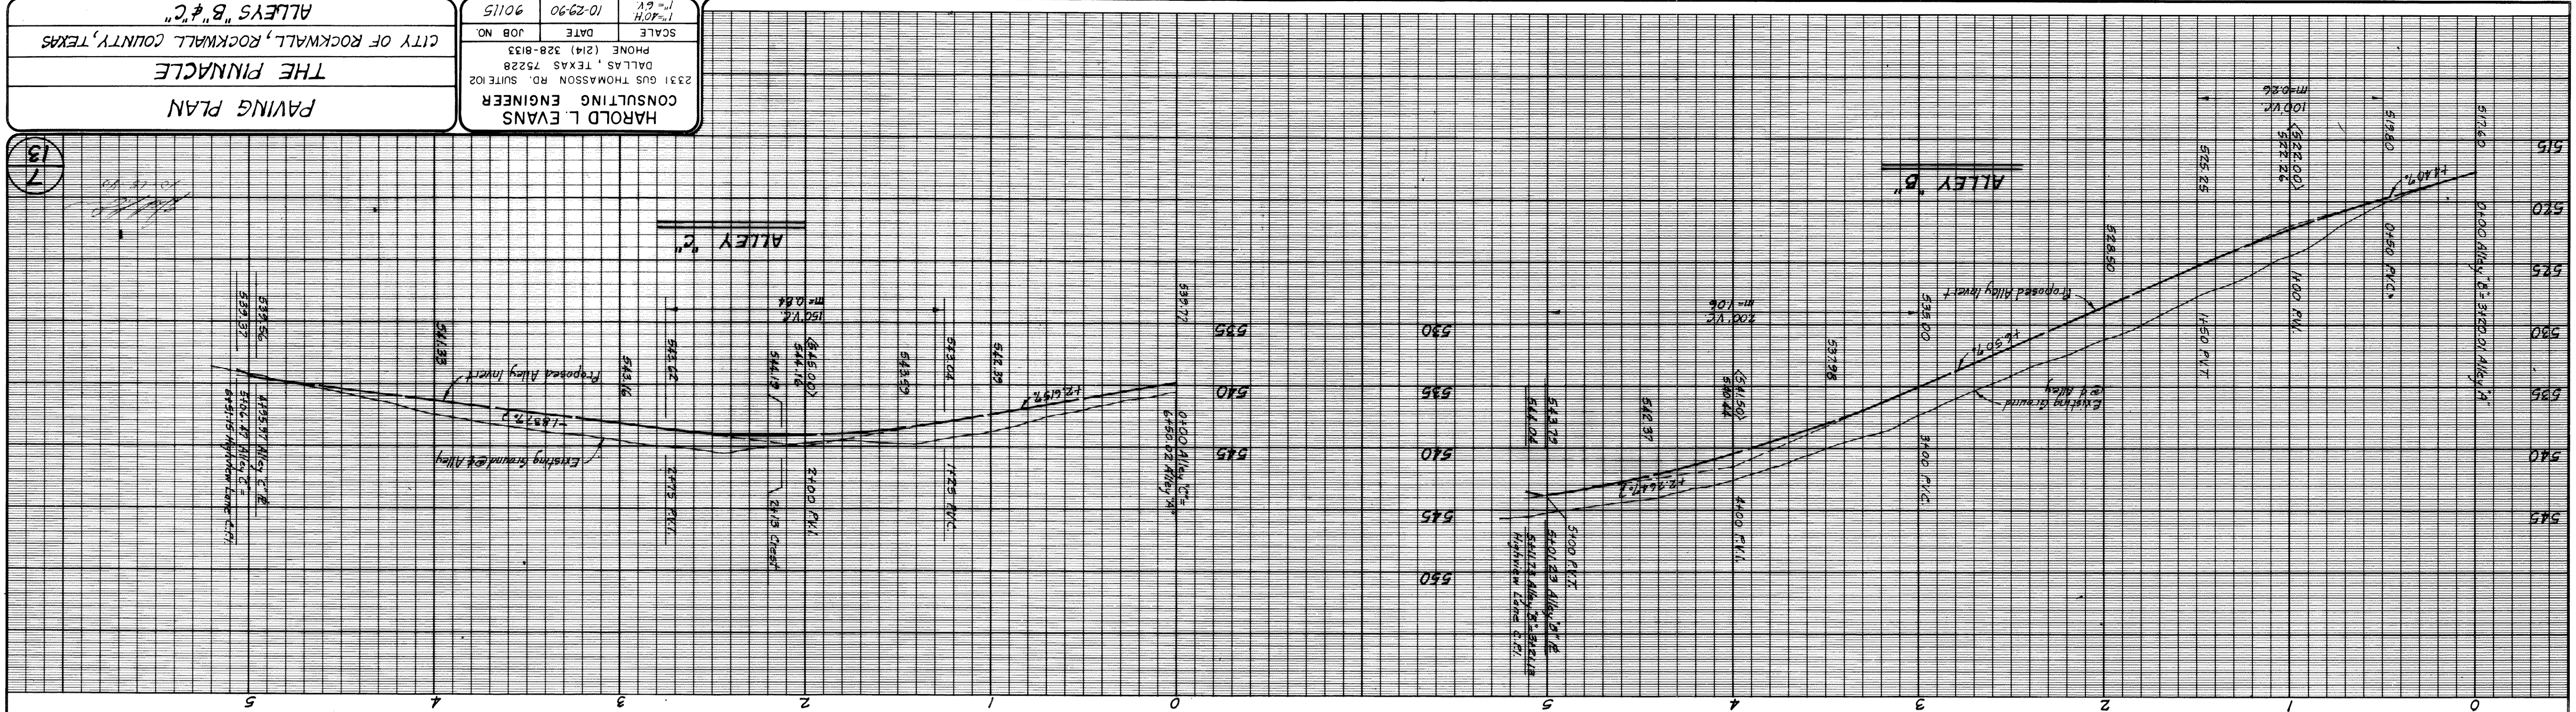

BENCHMARK:
 Top-of-Curb at the Northwest corner of the
 existing paving on Highway Lane
 Elevation 521.21

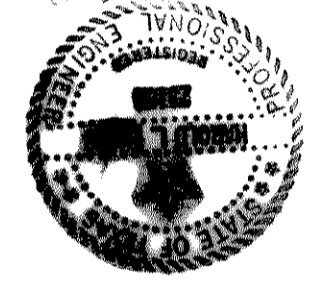

ALLEY "C"
 PHASE I

ALLEY "B"
 PHASE II

