


SANITARY SEWER PROFILE
THE PINNACLE
 CITY OF ROCKWALL, ROCKWALL CO., TEXAS
 LINES A, B, C, D, E

HAROLD L. EVANS
 CONSULTING ENGINEER
 2331 GUS THOMASSON RD., SUITE 102
 DALLAS, TEXAS 75228
 PHONE (214) 328-8133
 SCALE DATE JOB NO.
 1"=40' Horiz. 10-31-90 90115

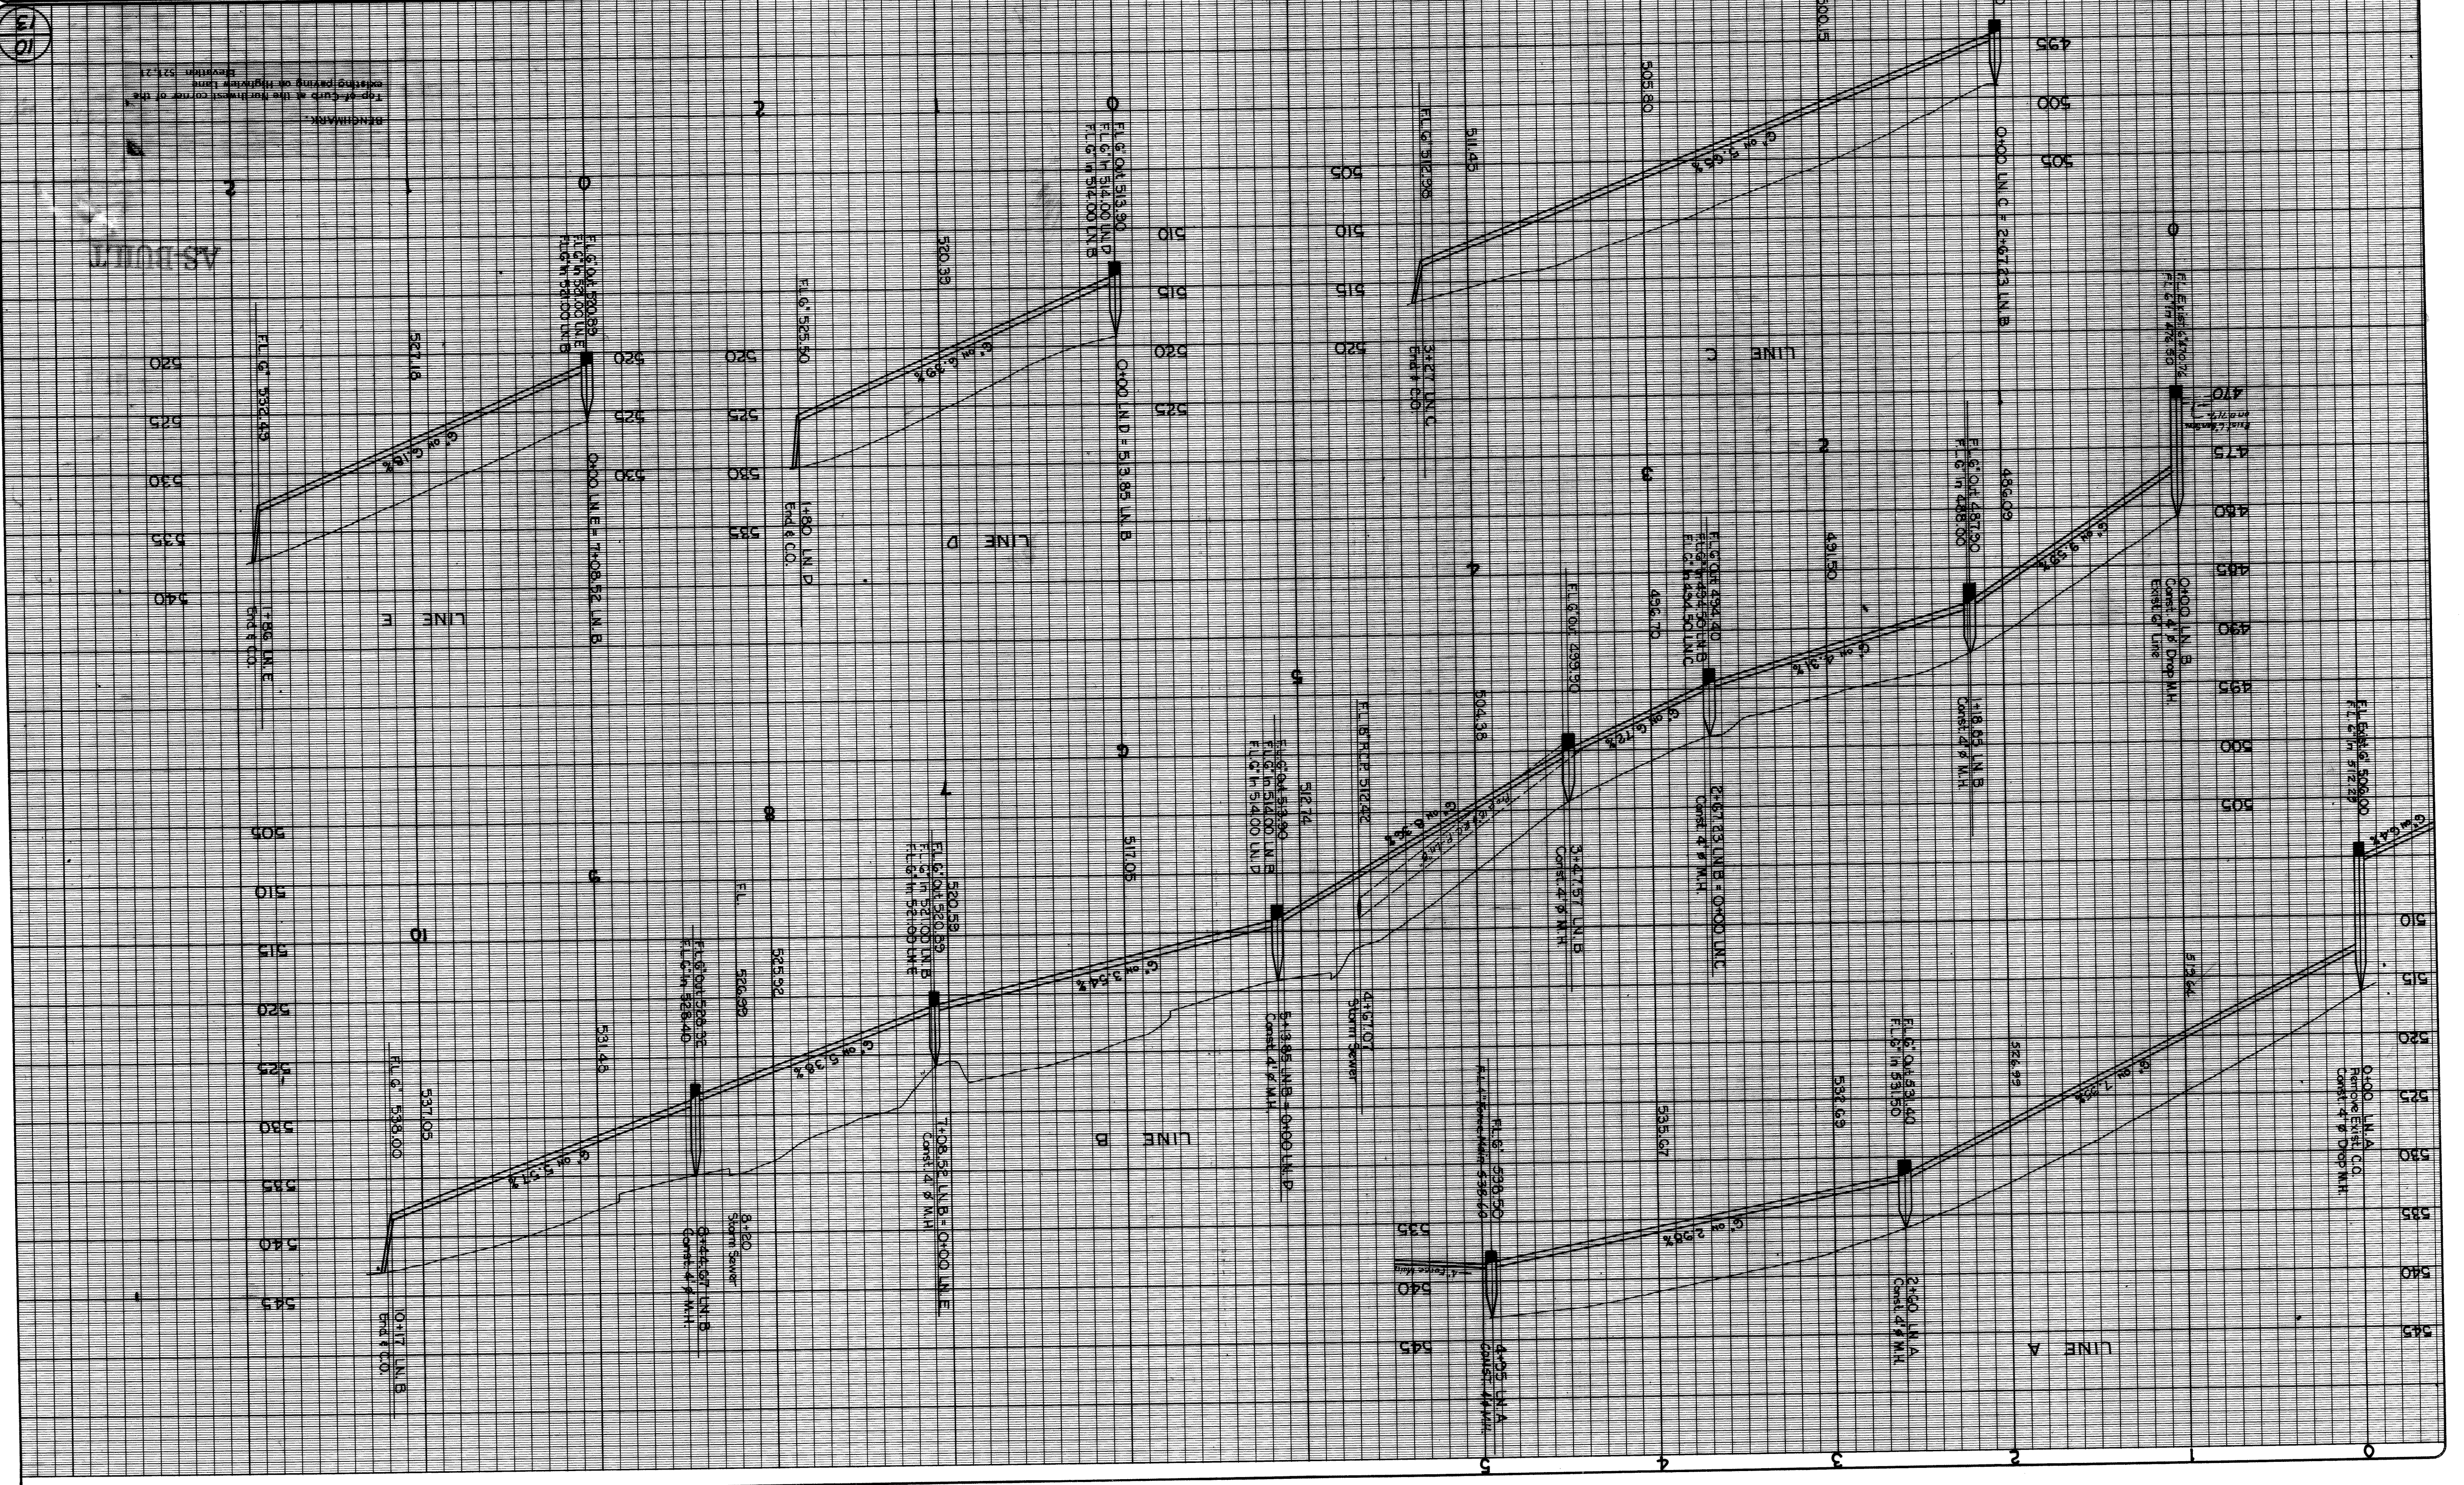

10
 13

BENCHMARK
 Top of curb at the Northwest corner of the
 existing parking on Highway 140
 Elevation: 527.21