


AS-BUILT

BENCHMARK:
Top-of-Curb at the Northwest corner of the existing paving on Highview Lane
Elevation 521.21

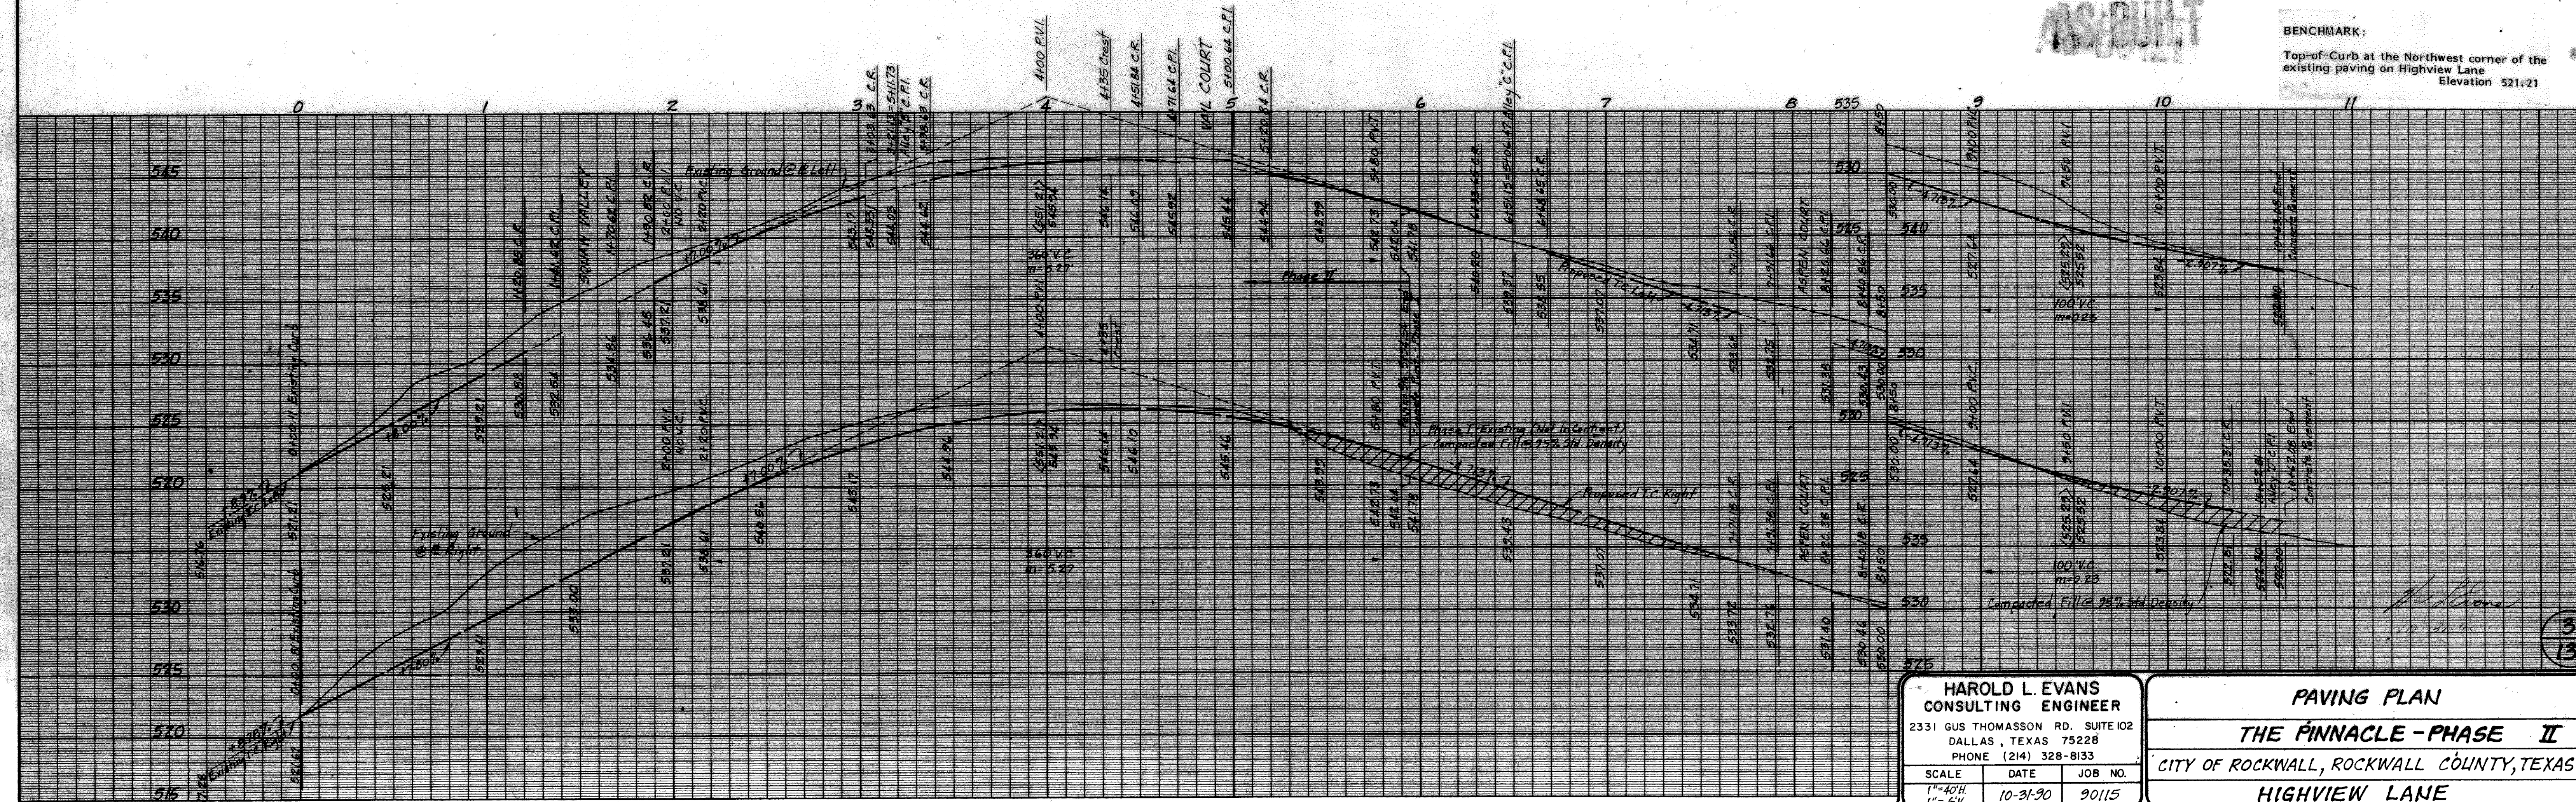

| | | | | | |
|--|----------|---------|--|--|--|
| HAROLD L. EVANS CONSULTING ENGINEER 2331 GUS THOMASSON RD. SUITE 102 DALLAS, TEXAS 75228 PHONE (214) 328-8133 | | | PAVING PLAN THE PINNACLE - PHASE II CITY OF ROCKWALL, ROCKWALL COUNTY, TEXAS HIGHVIEW LANE | | |
| SCALE | DATE | JOB NO. | | | |
| 1"=40' | 10-31-90 | 90115 | | | |

Rev. 3-13-91
Rev. 1-10-99