


**AS BUILT**

BENCHMARK:  
Top-of-Curb at the Northwest corner of the existing paving on Highview Lane  
Elevation 521.21

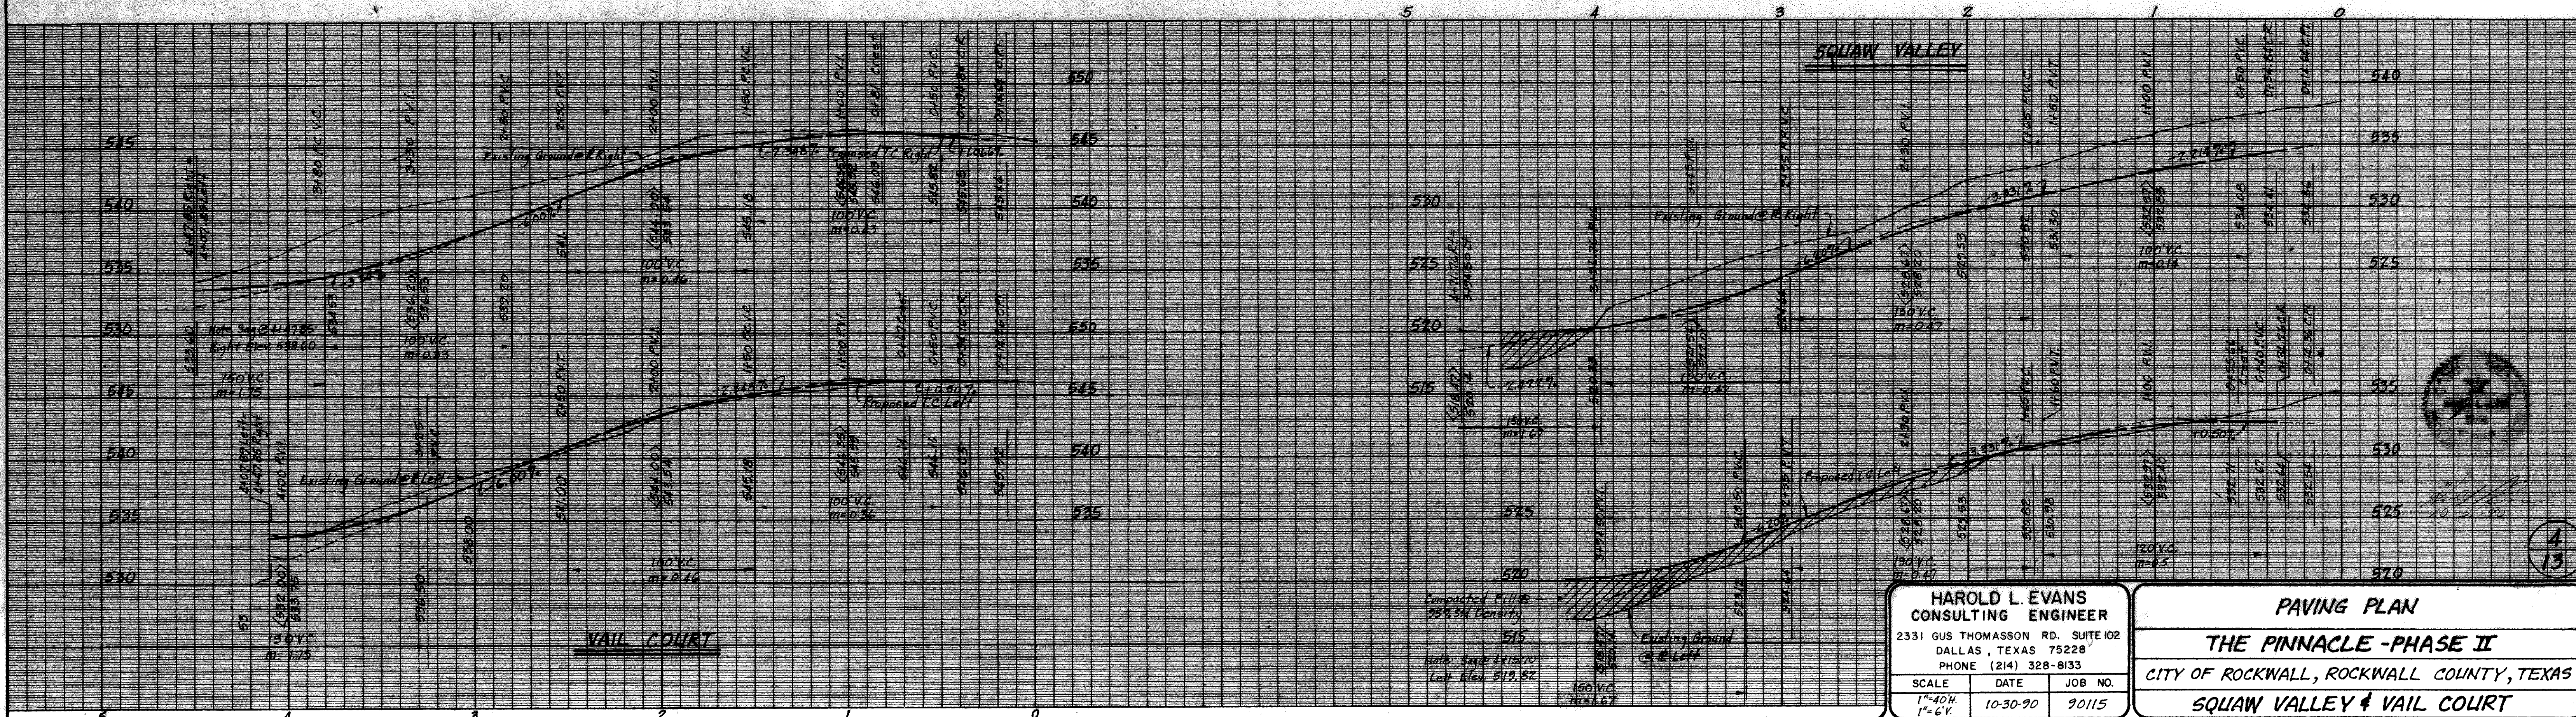

**HAROLD L. EVANS**  
CONSULTING ENGINEER  
2331 GUS THOMASSON RD. SUITE 102  
DALLAS, TEXAS 75228  
PHONE (214) 328-8133

**PAVING PLAN**  
**THE PINNACLE - PHASE II**  
CITY OF ROCKWALL, ROCKWALL COUNTY, TEXAS  
**SQUAW VALLEY & VAIL COURT**

SCALE: 1"=40'H  
1"=6'V  
DATE: 10-30-90  
JOB NO.: 90115

Rev. 1-30-92

4  
13