
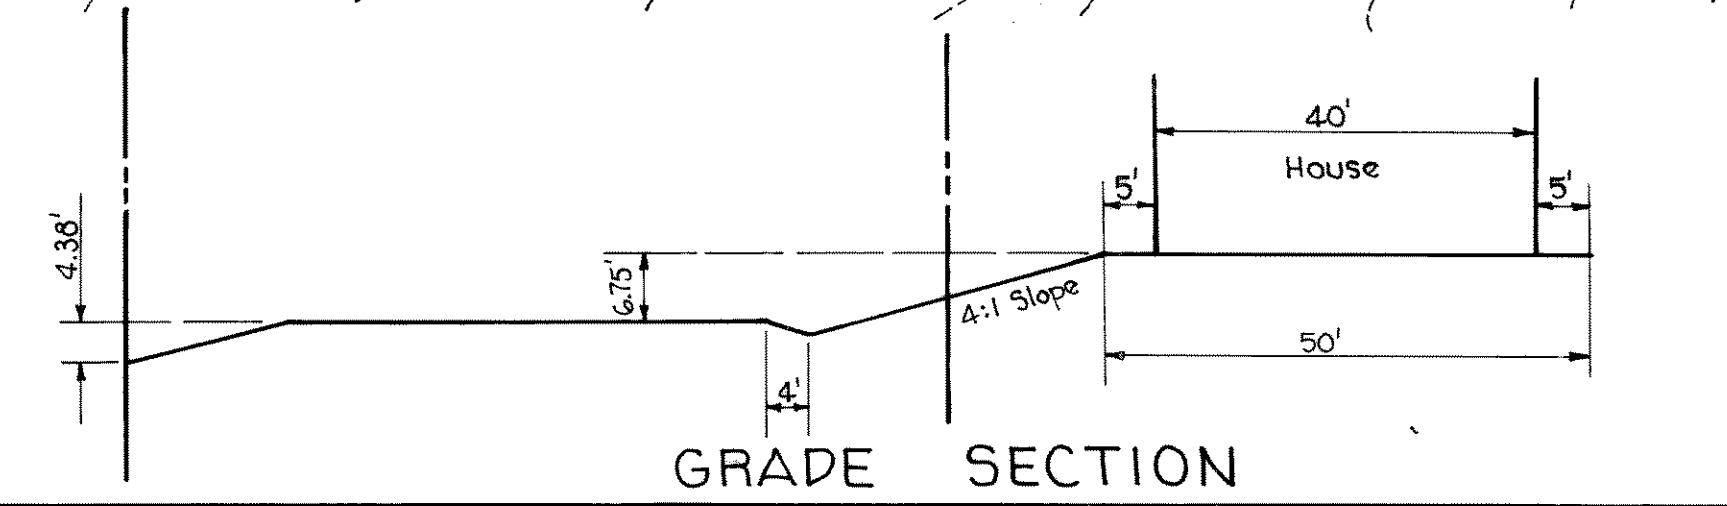
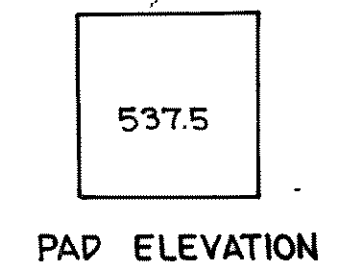
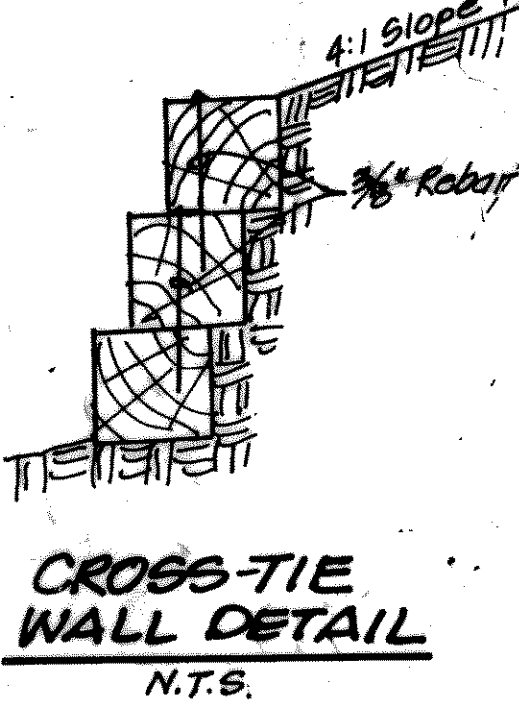



Straw bale dike
EROSION CONTROL
DETAIL

EROSION CONTROL
PER DETAIL

EROSION CONTROL
PER DETAIL

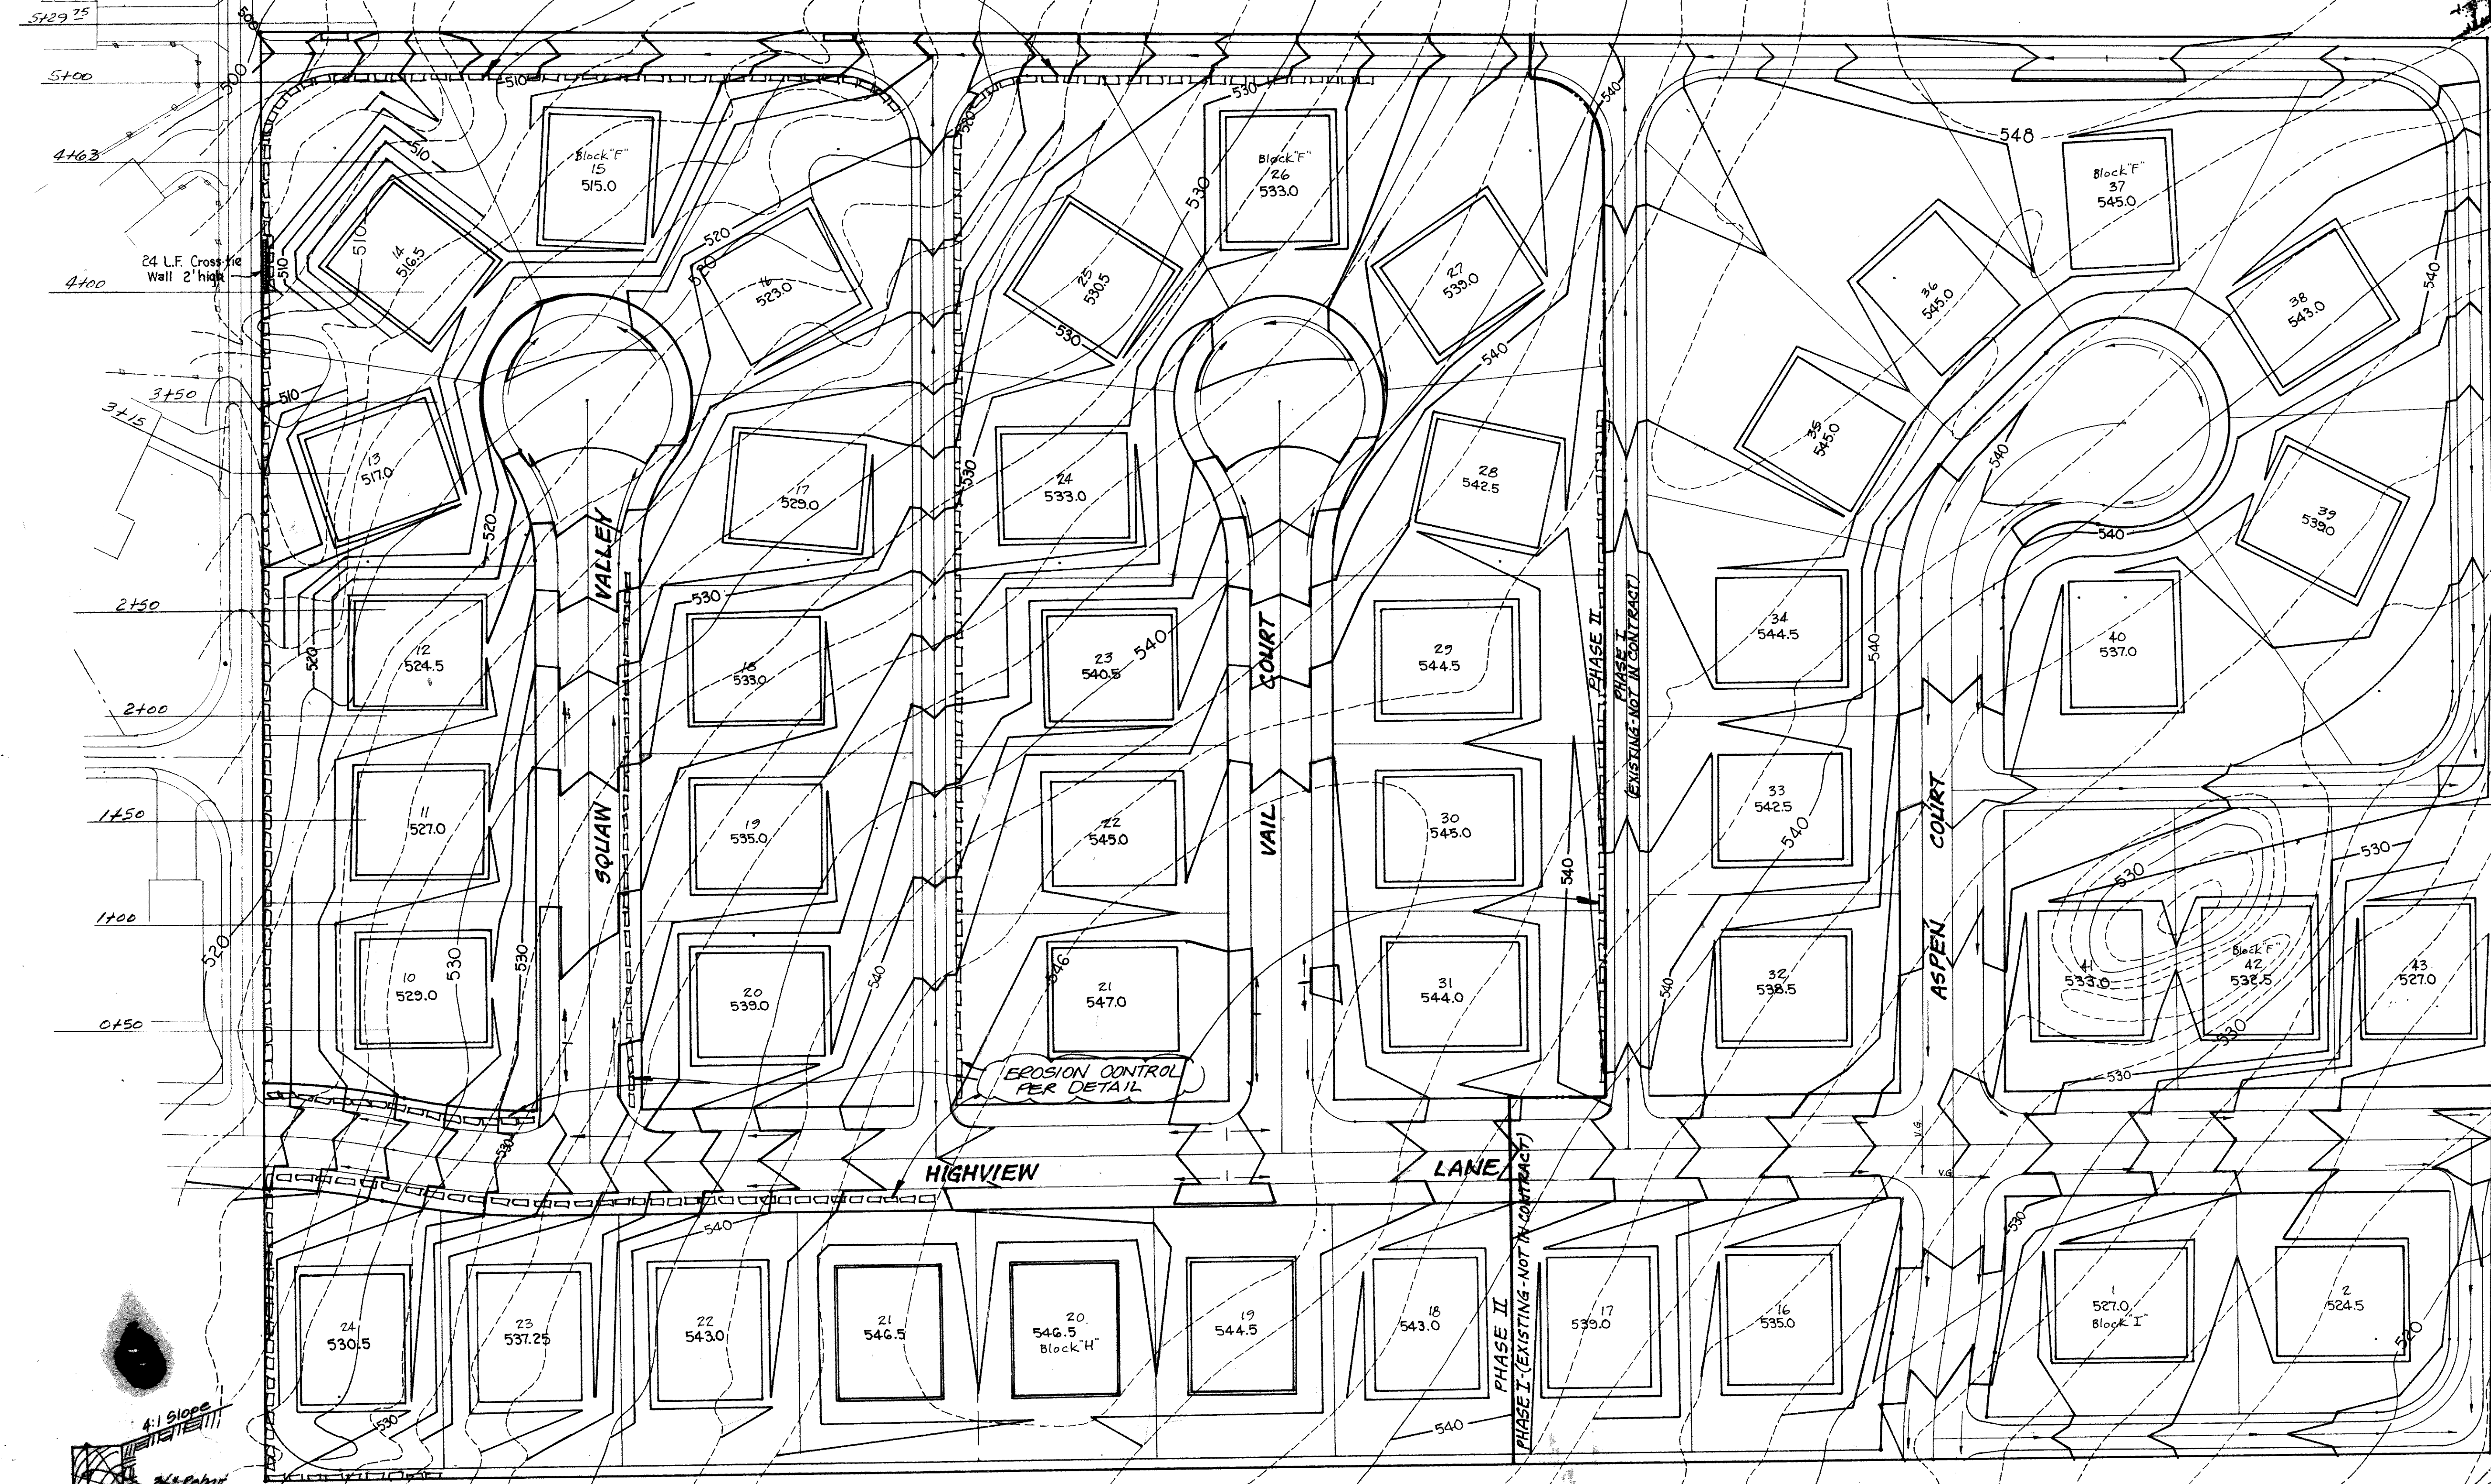

BENCHMARK:
Top of Curb at the Northwest corner
of the existing paving on Highview Lane
Elev. 521.21

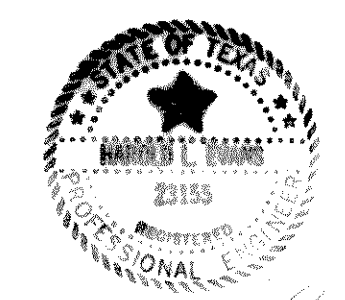

Rev. 5-11-91

AS BUILT

12
13

HAROLD L. EVANS
CONSULTING ENGINEER
2331 GUS THOMASSON RD. SUITE 102
DALLAS, TEXAS 75228
PHONE (214) 328-8133
SCALE DATE JOB NO.
1" = 40' 10-31-90 90115

GRADING PLAN
THE PINNACLE - PHASE I & II
CITY OF ROCKWALL, ROCKWALL CO., TEXAS

Rev. 1-10-92