
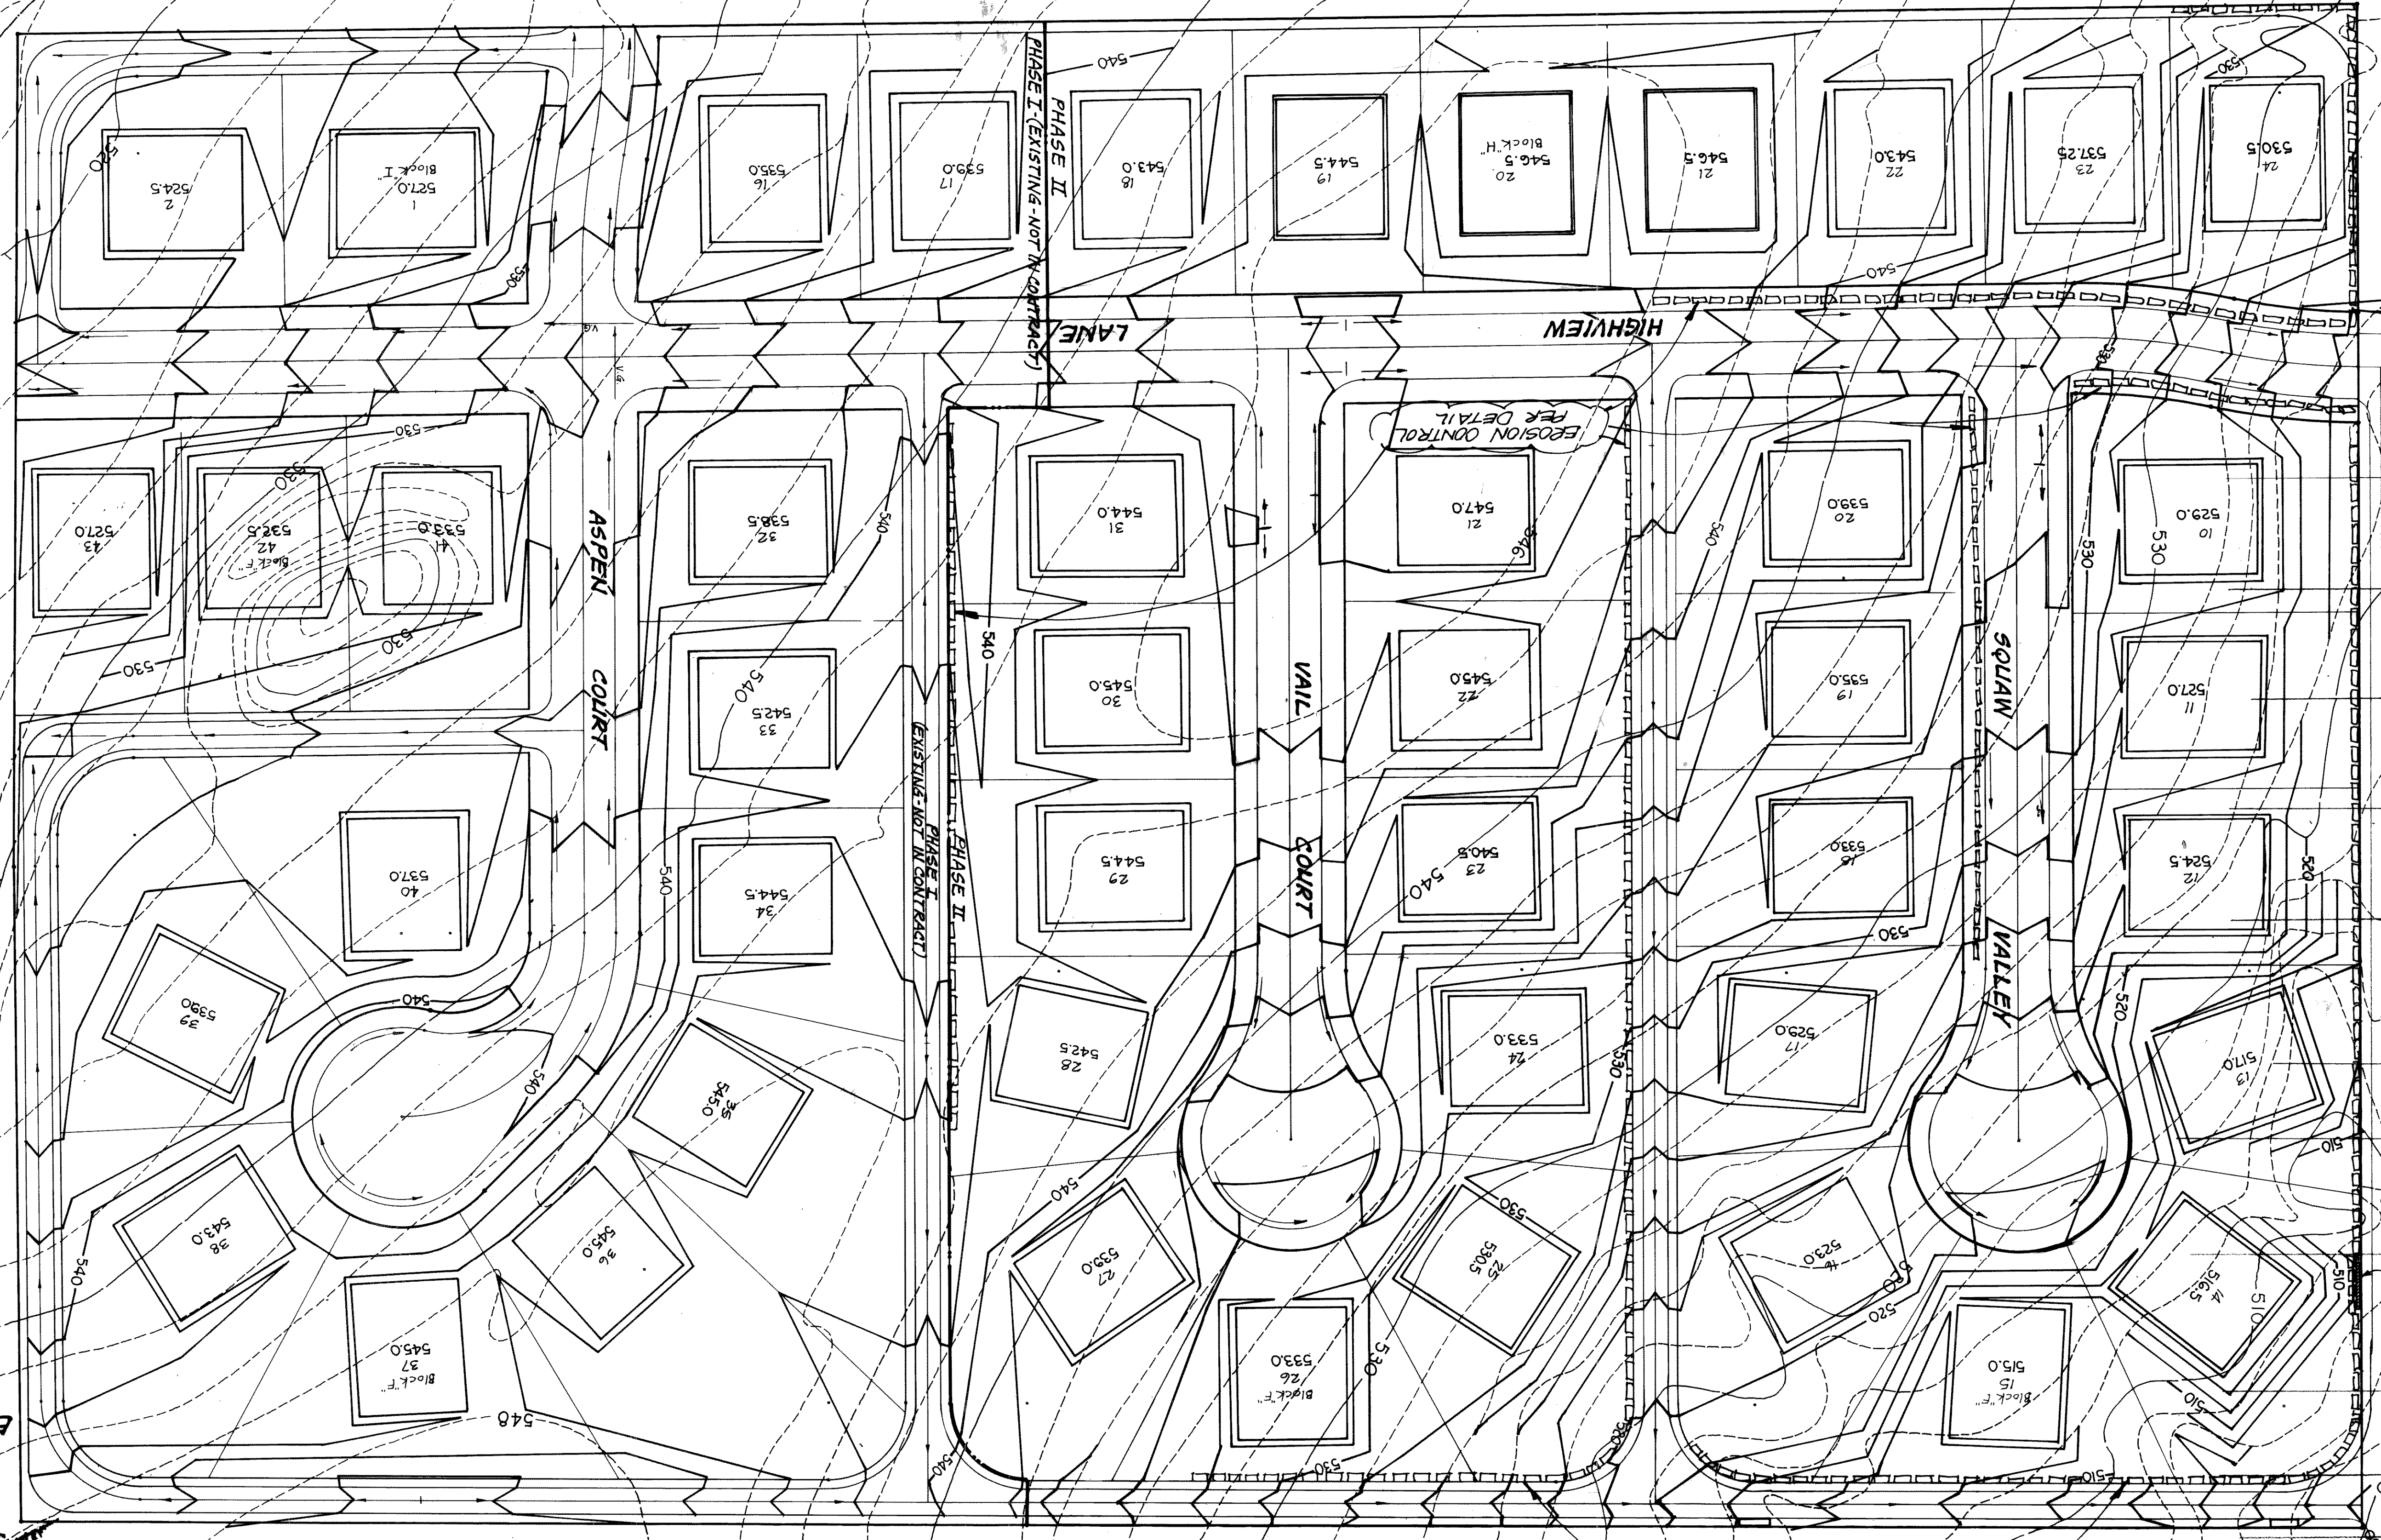
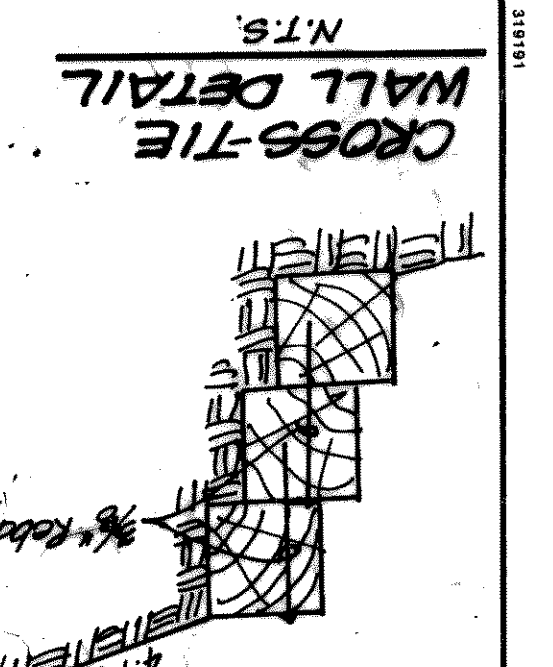
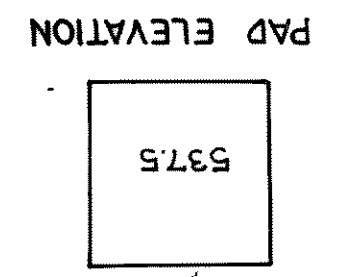


HAROLD L. EVANS
CONSULTING ENGINEER
231 GUS THOMASSON RD., SUITE 102
DALLAS, TEXAS 75228
PHONE (214) 328-8133
DATE 10-31-90
JOB NO. 90115
SCALE 1"=40'

GRADING PLAN
THE PINNACLE-PHASE I & II
CITY OF ROCKWALL, ROCKWALL CO., TEXAS


12
13

AS BUILT


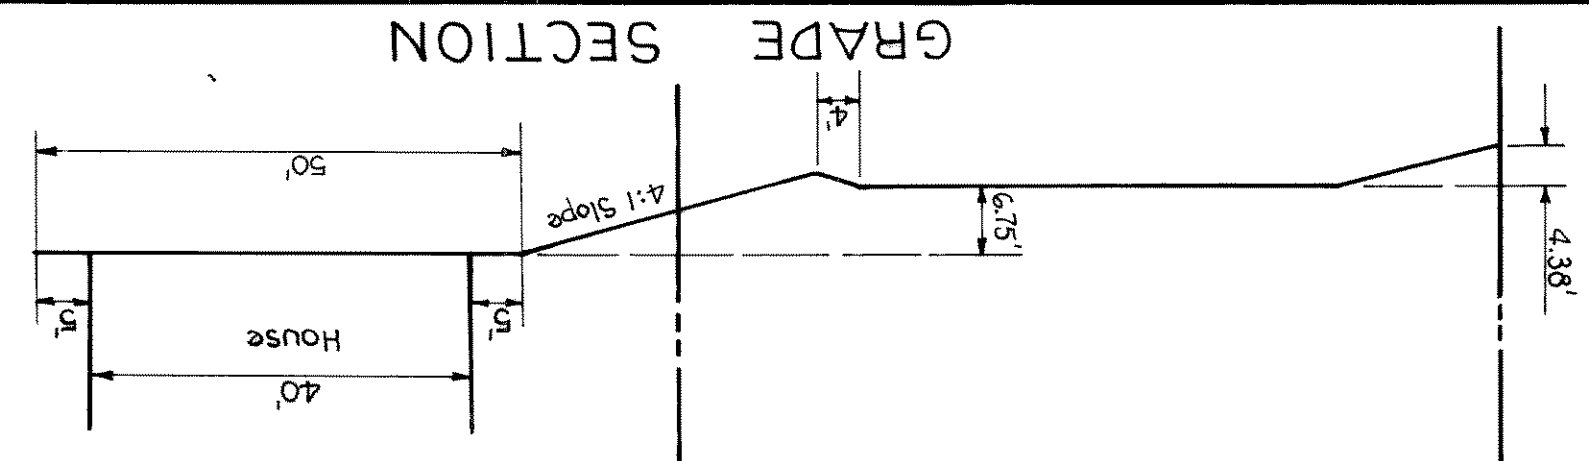


BENCHMARK:
TOP OF CURB OF THE EXISTING PAVING ON HIGHVIEW LANE
BY: 521.21

EROSION CONTROL
DETAIL
Straw bale dike

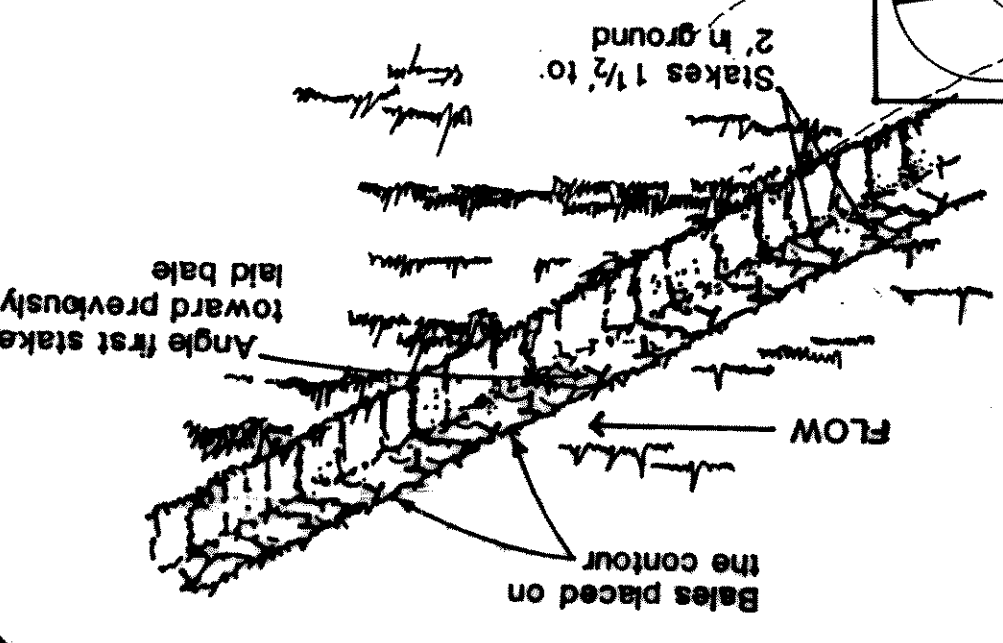

EROSION CONTROL
DETAIL
PER DETAIL

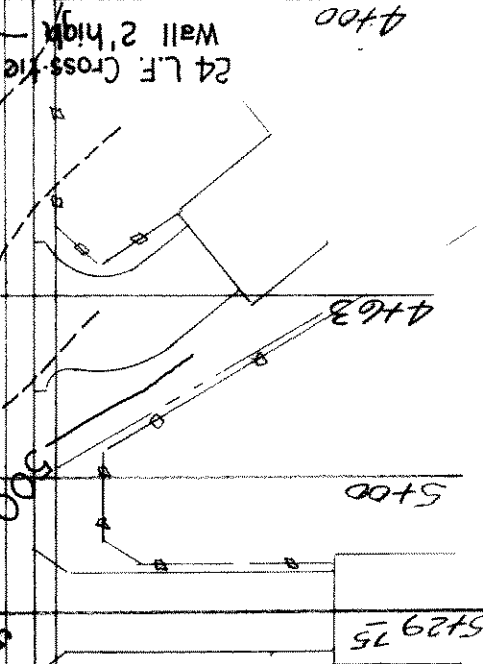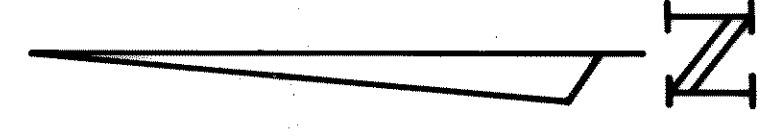

M.T.S.