


HAROLD L EVANS
 CONSULTING ENGINEER
 2331 GUS THOMASSON RD, SUITE 102
 DALLAS, TEXAS 75228
 PHONE (214) 328-8133

SCALE 1"=40'
 DATE 10-31-90
 JOB NO. 90115

REV. 3-13-91
 M. L. 10-22
 1"=40'
 10-31-90

THE PINNACLE - PHASE II
 PAVING PLAN
 CITY OF ROCKWALL, ROCKWALL COUNTY, TEXAS
 HIGHVIEW LANE

13
 3

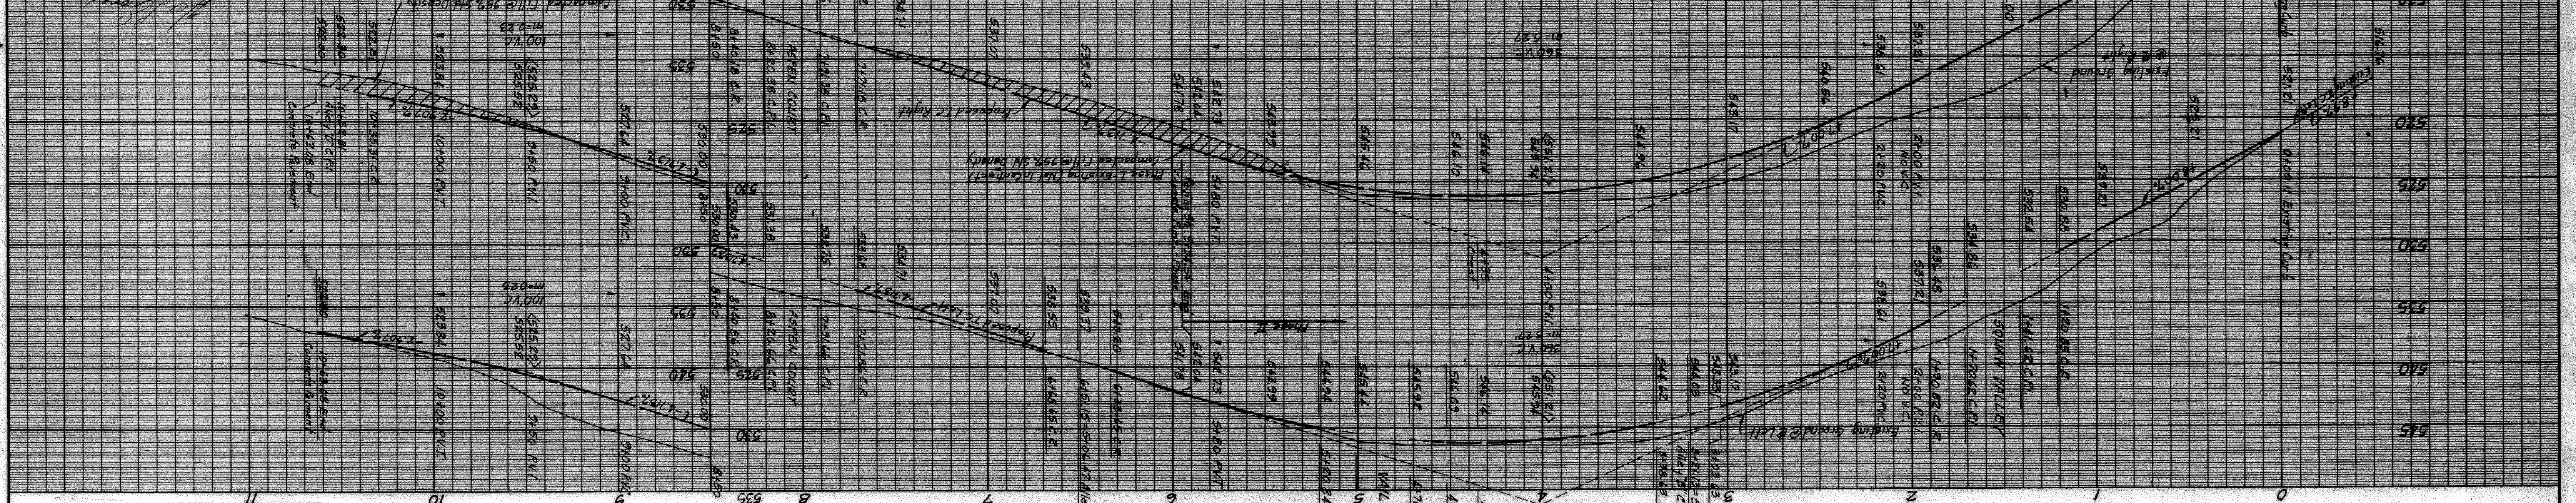

BENCHMARK:
 Top-of-Curb at the Northwest corner of the
 existing paving on Highview Lane
 Elevation 521.21

ASPHALT

