
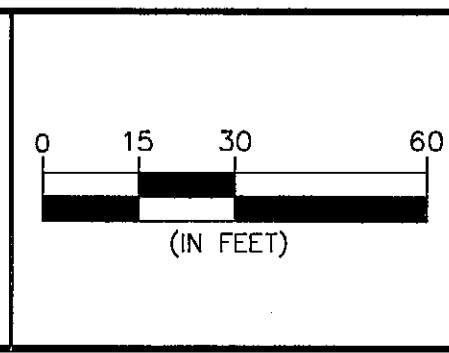



- GENERAL NOTES:
1. DECELERATION LANE TO BE 8" REINFORCED 3600 PSI CONCRETE WITH 6" LIME STABILIZED SUBGRADE
  2. DIMENSIONS ARE FACE TO FACE
  3. FIRELINE PAVEMENT IS 3,600 PSI MINIMUM, WITH A 6 SACK MIN REQUIREMENT FOR MACHINE PLACEMENT, OR A 6.5 SACK MIN FOR HAND PLACEMENT.
  4. NO SAND ALLOWED UNDER PAVEMENT

**DISCLAIMER**  
 TO THE BEST OF OUR KNOWLEDGE, THE WALLACE GROUP, INC. HEREBY STATES THAT THIS PLAN IS AS-BUILT/RECORD DRAWINGS. THE INFORMATION PROVIDED IS BASED ON SURVEYING CONDUCTED AT THE SITE AND INFORMATION PROVIDED BY THE CONTRACTOR.

REV	DATE	BY	DESCRIPTION
1	3-19-07	MM	ADDED HATCHING FOR PAVEMENT SECTIONS
2	3-4-07	RS	Revised Building 20-2R Footprint
3	2-9-07	RS	Revised Staples building footprint (Bldg. 4)
4	2-4-07	RS	Revised Dicks building footprint (Bldg. 5)

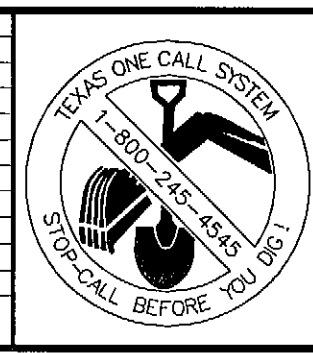

DESIGNED: \_\_\_\_\_  
 DRAWN: \_\_\_\_\_  
 CHECKED: \_\_\_\_\_

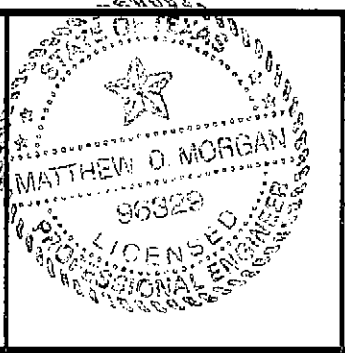

"THE SEAL APPEARING ON THIS DOCUMENT WAS AUTHORIZED BY MATTHEW O. MORGAN, P.E. # 86922 ON THE DATE SHOWN ON THE DATESAMP. ALTERATION OF A SEALED DOCUMENT WITHOUT PROPER NOTIFICATION TO THE RESPONSIBLE ENGINEER IS AN OFFENSE UNDER THE TEXAS ENGINEERING PRACTICE ACT"

3/20/08 *Matthew O. Morgan*  
 DATE NAME

ENGINEERS ARCHITECTS

**THE WALLACE GROUP INC.**

SURVEYORS PLANNERS

THE WOODMONT COMPANY  
 PLAZA AT ROCKWALL  
 OVERALL SITE PLAN

SHEET 15  
**C3.0**  
 OF 56 SHEETS

C:\projects\15523\dwg\AS-BUILT\C3.0-PLAZA SITE.DWG, 0:00:00 (C3.0), 3/20/08, 11:54:25 AM, 1933, ACAD, Rymal, 15523, 1:1