
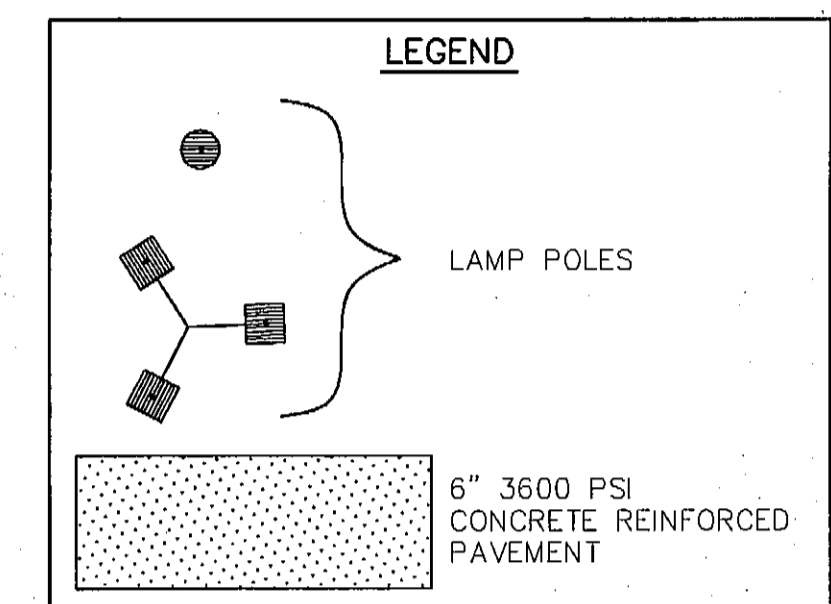
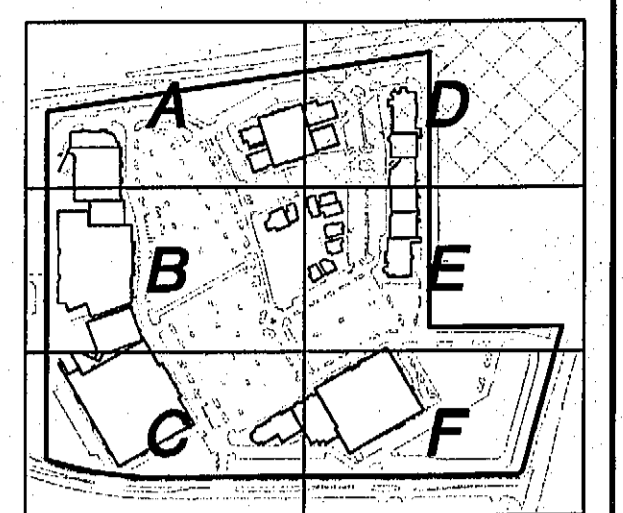



MATCHLINE A SEE SH C3.1

MATCHLINE E SEE SH C3.5

- GENERAL NOTES:
1. DECELERATION LANE TO BE 8" REINFORCED 3600 PSI CONCRETE WITH 6" LIME STABILIZED SUBGRADE
  2. DIMENSIONS ARE FACE TO FACE


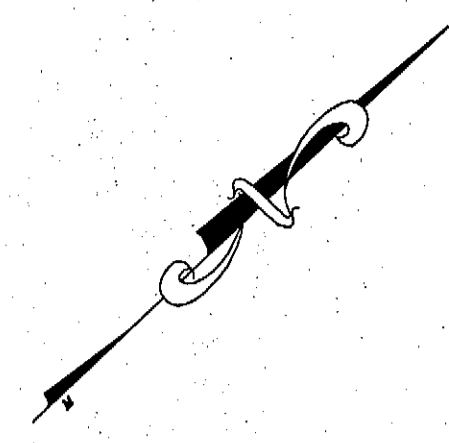


NOTE:  
ALL OTHER PAVEMENT, EXCLUDING BUILDING LOADING AREAS, TO BE 5"-3000 PSI REINFORCED CONCRETE

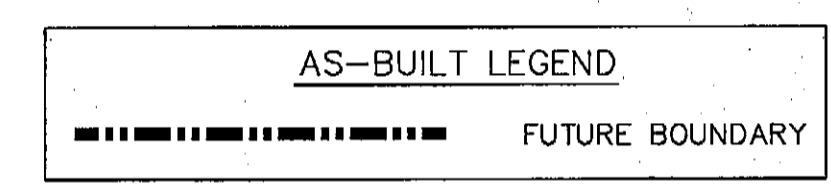

**DISCLAIMER**  
TO THE BEST OF OUR KNOWLEDGE, THE WALLACE GROUP, INC. HEREBY STATES THAT THIS PLAN IS AS-BUILT/RECORD DRAWINGS. THE INFORMATION PROVIDED IS BASED ON SURVEYING CONDUCTED AT THE SITE AND INFORMATION PROVIDED BY THE CONTRACTOR.

REV	DATE	BY	DESCRIPTION
1	5-18-07	MM	REVISED RADIUS CALL OUTS FOR ENTRY DRIVE
2	4-16-07	MM	REVISED VARIOUS DIMENSION CALLOUT AT ENTRIES AND BUILDINGS
3	3-19-07	MM	ADDED HATCHING FOR PAVEMENT SECTIONS

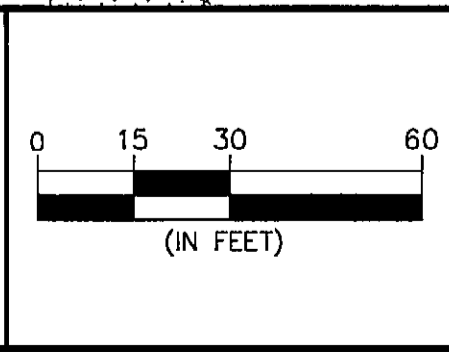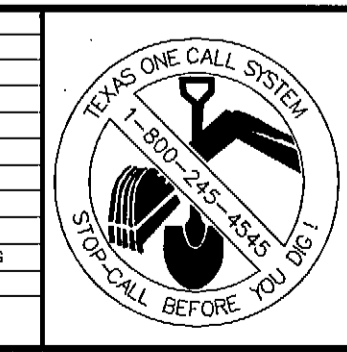

DESIGNED:  
DRAWN:  
CHECKED:



"THE SEAL APPEARING ON THIS DOCUMENT WAS AUTHORIZED BY MATTHEW D. MORGAN, P.E. # 96329 ON THE DATE SHOWN ON THE DAYSTAMP. ALTERATION OF A SEALED DOCUMENT WITHOUT PROPER NOTIFICATION TO THE RESPONSIBLE ENGINEER IS AN OFFENSE UNDER THE TEXAS ENGINEERING PRACTICE ACT"

3/25/08 *Matthew D. Morgan*  
DATE NAME

ENGINEERS ARCHITECTS

**THE WALLACE GROUP INC.**

SURVEYORS PLANNERS

THE WOODMONT COMPANY  
PLAZA AT ROCKWALL  
**SITE PLAN D**

SHEET 18  
**C3.4**  
OF 56 SHEETS

C:\Projects\18558\WMS-BUILD\18558-AB-C3.4-C3.5-SITE.DWG, SITE D (C3.4), 3/25/2008 9:03:45 AM, mfg, Xtrac\_Mfg1.pcb, 1:1