



NOTE: THERE ARE THREE SHARED SIX INCH FIRE LINES TO SERVE BUILDINGS 9, 10, 13, 14, 15 & 16. SPRINKLER CONTRACTOR TO PROVIDE ISOLATION VALVES FOR SPRINKLER SYSTEMS OF EACH BUILDING AT THE FIRE RATED SEPARATION PER CITY OF ROCKWALL FIRE MARSHALL.

NOTE: THE FOLLOWING BUILDINGS 9, 10, 13, 14, 15 & 16 SHARE COMMON WATER AND WASTEWATER SERVICES. THE WASTEWATER FLOW IS PICKED UP AT THE CLEANOUT ON THE SOUTH WEST SIDE OF BUILDING 9. THE WATER CONNECTION IS ON THE SOUTH SIDE OF BUILDING 9 & 13.

- GENERAL NOTES:
1. LINES TO BE CLASS 200
  2. INSTALL BLUE EMS DISK ON WATER LINE AT EVERY CHANGE IN DIRECTION (BENDS, TEES, VALVES, FH & SERVICES)
  3. INSTALL GREEN EMS DISK ON SANITARY SEWER LINE AT EVERY CHANGE IN DIRECTION (MANHOLE, CLEANOUT & SERVICE)
  4. ALL FIRE HYDRANTS TO HAVE 5' CLEARANCE AROUND (NOT INCLUDING ADDITIONAL 2' CLEARANCE AT 18" PARKING SPACES)

**DISCLAIMER**  
 TO THE BEST OF OUR KNOWLEDGE, THE WALLACE GROUP, INC. HAS REVIEWED THE INFORMATION PROVIDED BY THE CONTRACTOR AND HAS FOUND IT TO BE ACCURATE. HOWEVER, THE INFORMATION PROVIDED IS BASED ON SURVEYING CONDUCTED AT THE SITE AND INFORMATION PROVIDED BY THE CONTRACTOR.

NO.	REVISION	DATE	BY	DESCRIPTION
1	ISSUED FOR PERMIT	2-18-07	MS	ISSUED FOR PERMIT
2	ISSUED FOR PERMIT	2-18-07	MS	ISSUED FOR PERMIT

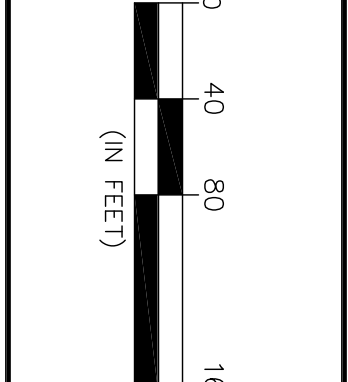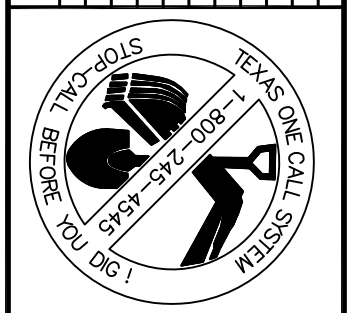

DESIGNED: \_\_\_\_\_  
 DRAWN: \_\_\_\_\_  
 CHECKED: \_\_\_\_\_

THE SCALE SHOWN ON THIS DOCUMENT HAS AUTHORITY BY THE ENGINEER'S SIGNATURE AND SEAL. THE ENGINEER'S SIGNATURE AND SEAL ARE REQUIRED FOR THE DOCUMENT TO BE VALID. THE ENGINEER'S SIGNATURE AND SEAL ARE REQUIRED FOR THE DOCUMENT TO BE VALID.

ENGINEERS  
 ARCHITECTS  
**THE WALLACE GROUP INC.**  
 SURVEYORS  
 PLANNERS

THE WOODMONT COMPANY  
 PLAZA AT ROCKWALL  
**OVERALL UTILITY PLAN**  
 SHEET 21  
 C4.0  
 OF 56 SHEETS