



G:\Projects\1835\1835-AS-BUILT\1835-AB-C4.62-WATER-PROF.DWG, W-1 (C4.62), 2/25/2008 3:27:28 PM, nrs, Xerox, Mylar, lpc3, 1:1

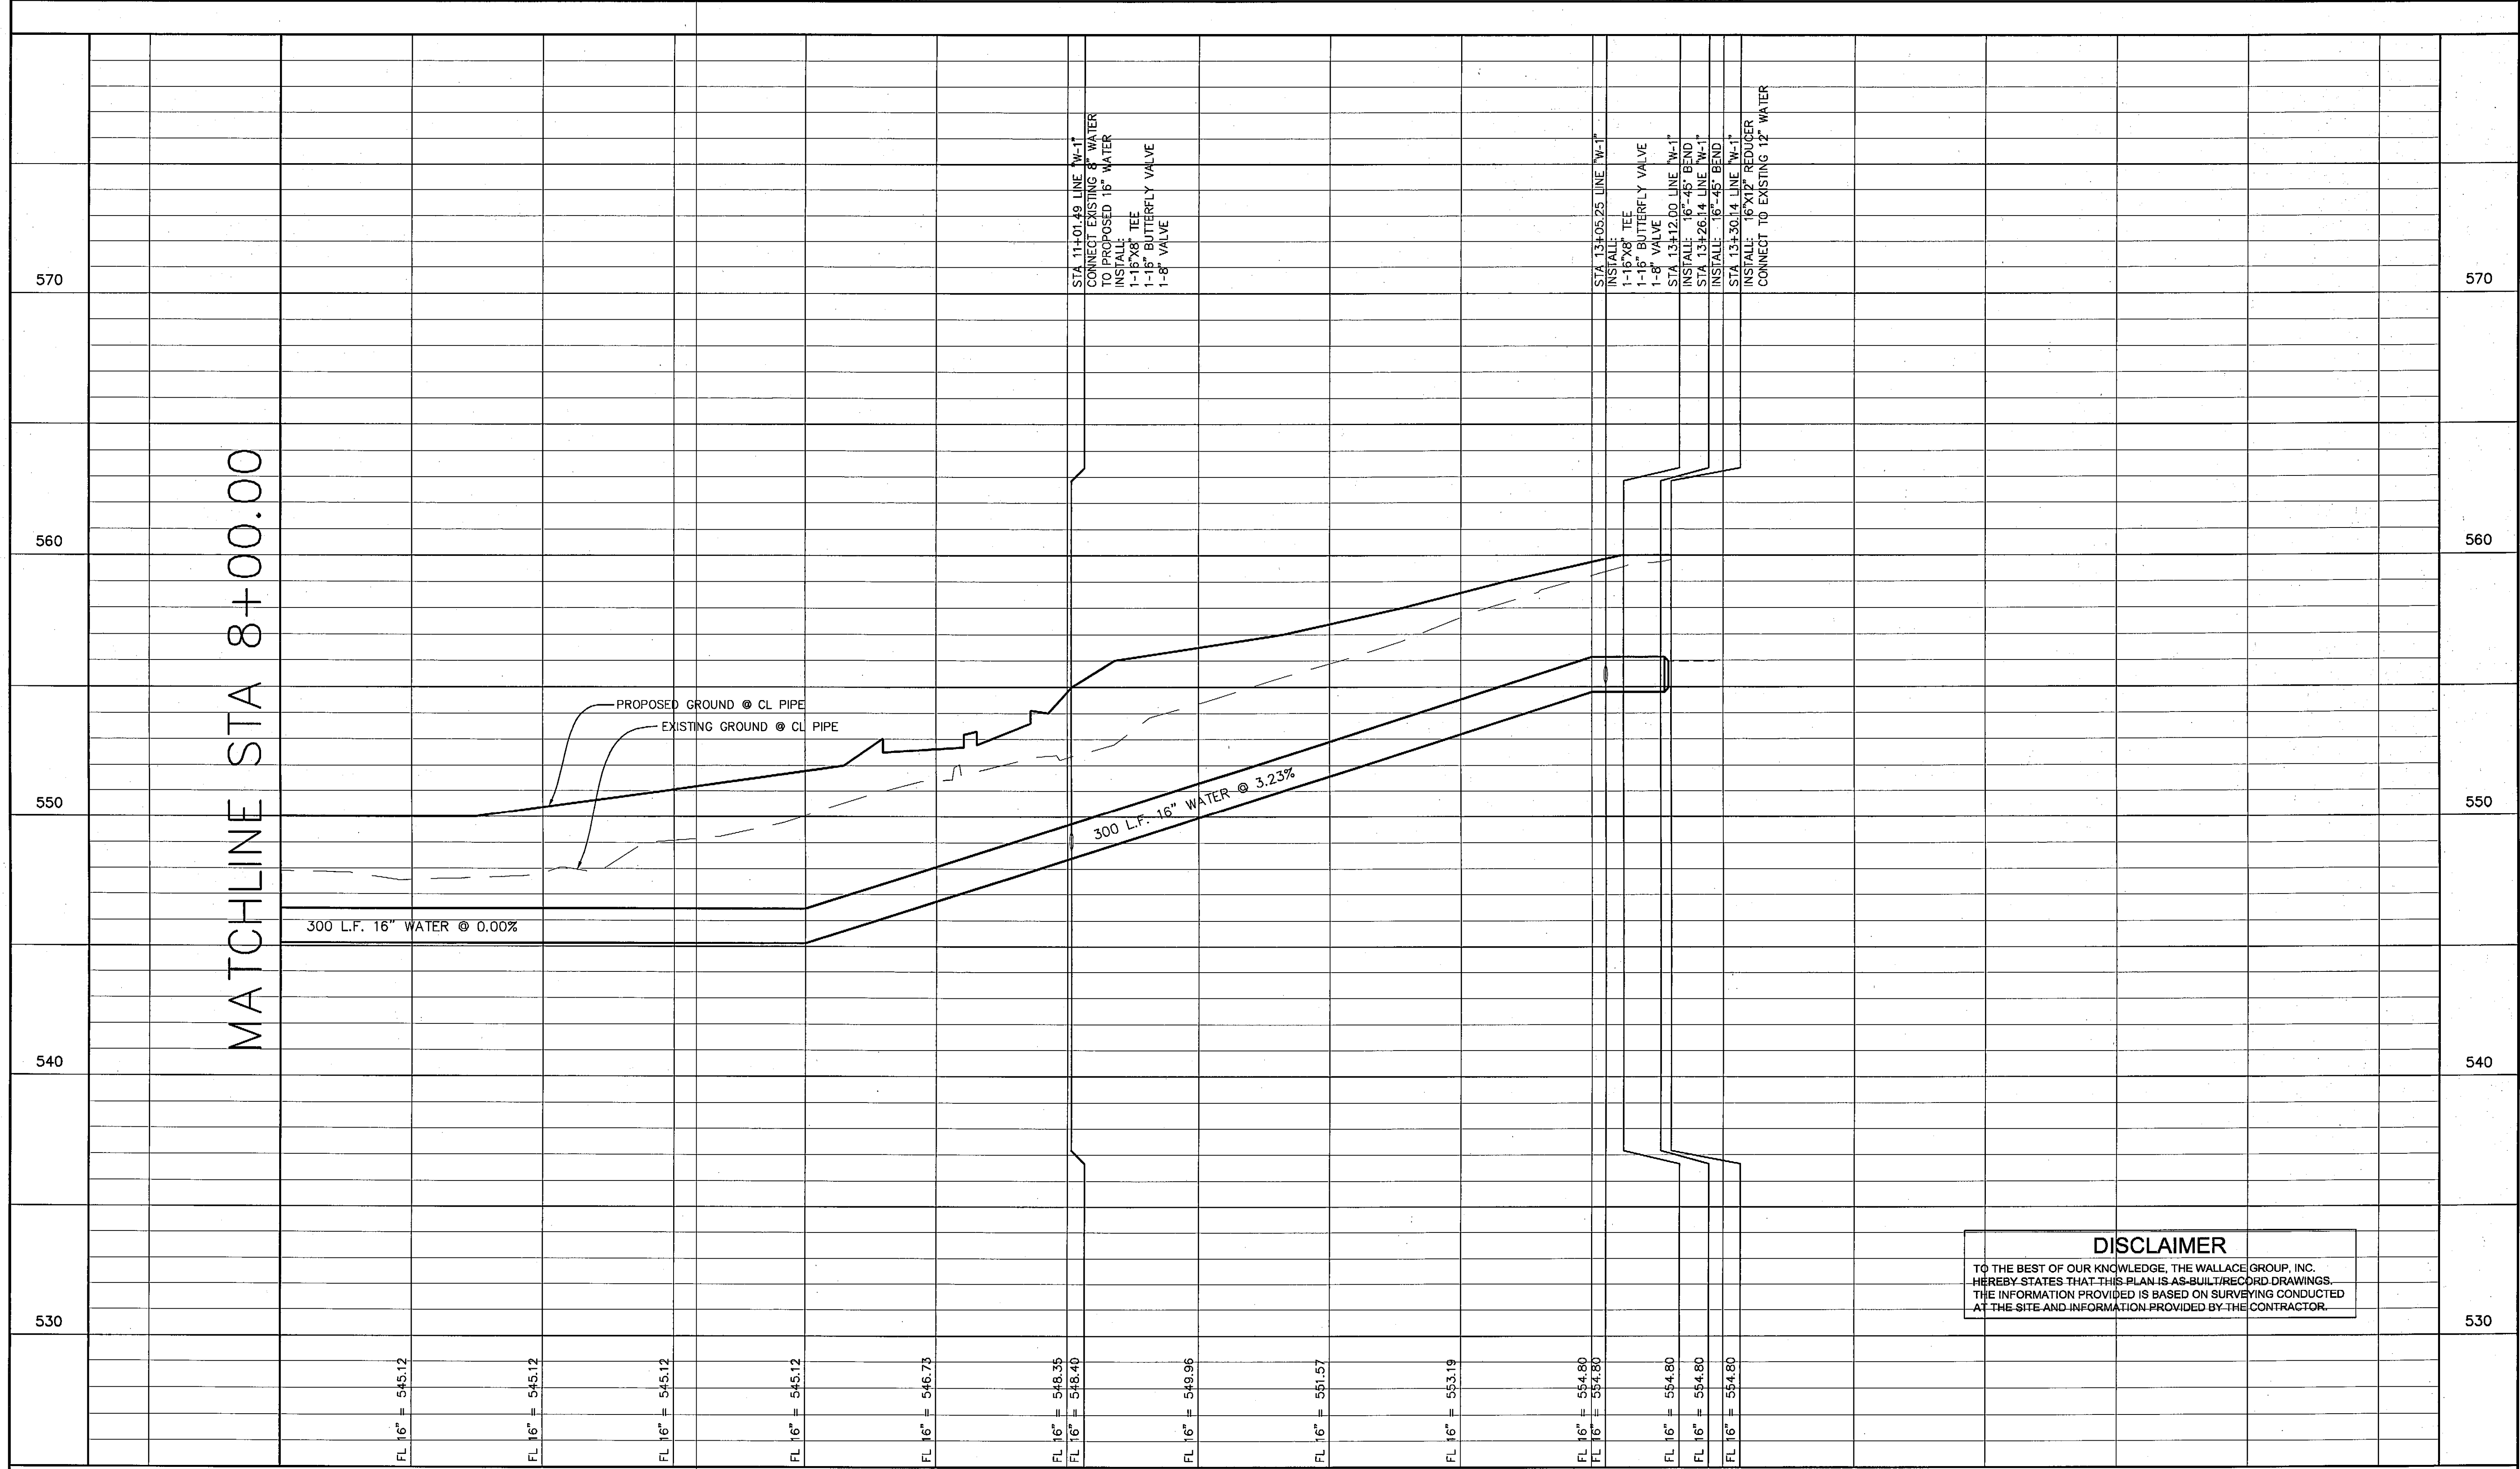


MATCHLINE STA 8+00.00

DISCLAIMER
 TO THE BEST OF OUR KNOWLEDGE, THE WALLACE GROUP, INC. HEREBY STATES THAT THIS PLAN IS AS-BUILT/RECORD DRAWINGS. THE INFORMATION PROVIDED IS BASED ON SURVEYING CONDUCTED AT THE SITE AND INFORMATION PROVIDED BY THE CONTRACTOR.

REV	DATE	BY	DESCRIPTION

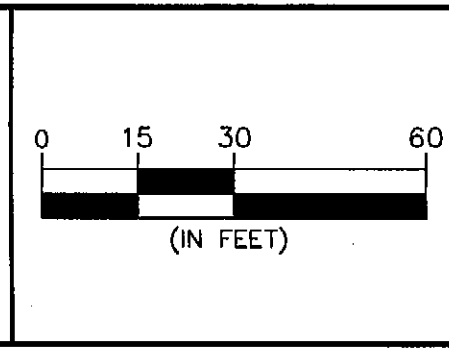

DESIGNED: _____
 DRAWN: _____
 CHECKED: _____

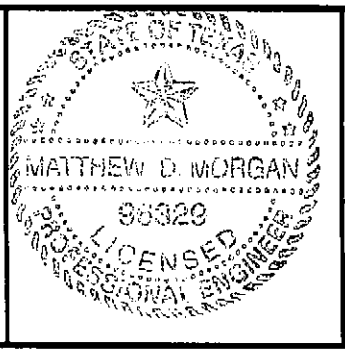

"THE SEAL APPEARING ON THIS DOCUMENT WAS AUTHORIZED BY MATTHEW D. MORGAN, P.E. # 89320 ON THE DATE SHOWN ON THE DAYSTAMP. ALTERATION OF A SEALED DOCUMENT WITHOUT PROPER NOTIFICATION TO THE RESPONSIBLE ENGINEER IS AN OFFENSE UNDER THE TEXAS ENGINEERING PRACTICE ACT"

3/25/08 *Matthew D. Morgan*
 DATE NAME

ENGINEERS ARCHITECTS

THE WALLACE GROUP INC.

SURVEYORS PLANNERS

THE WOODMONT COMPANY
 PLAZA AT ROCKWALL
WATER PROFILE
LINE "W-1"

SHEET 44
C4.62
 OF 56 SHEETS