


DISCLAIMER
 TO THE BEST OF OUR KNOWLEDGE, THE WALLACE GROUP, INC. HEREBY STATES THAT THIS PLAN IS AS-BUILT RECORD DRAWINGS. THE INFORMATION PROVIDED IS BASED ON SURVEYING CONDUCTED AT THE SITE AND INFORMATION PROVIDED BY THE CONTRACTOR.

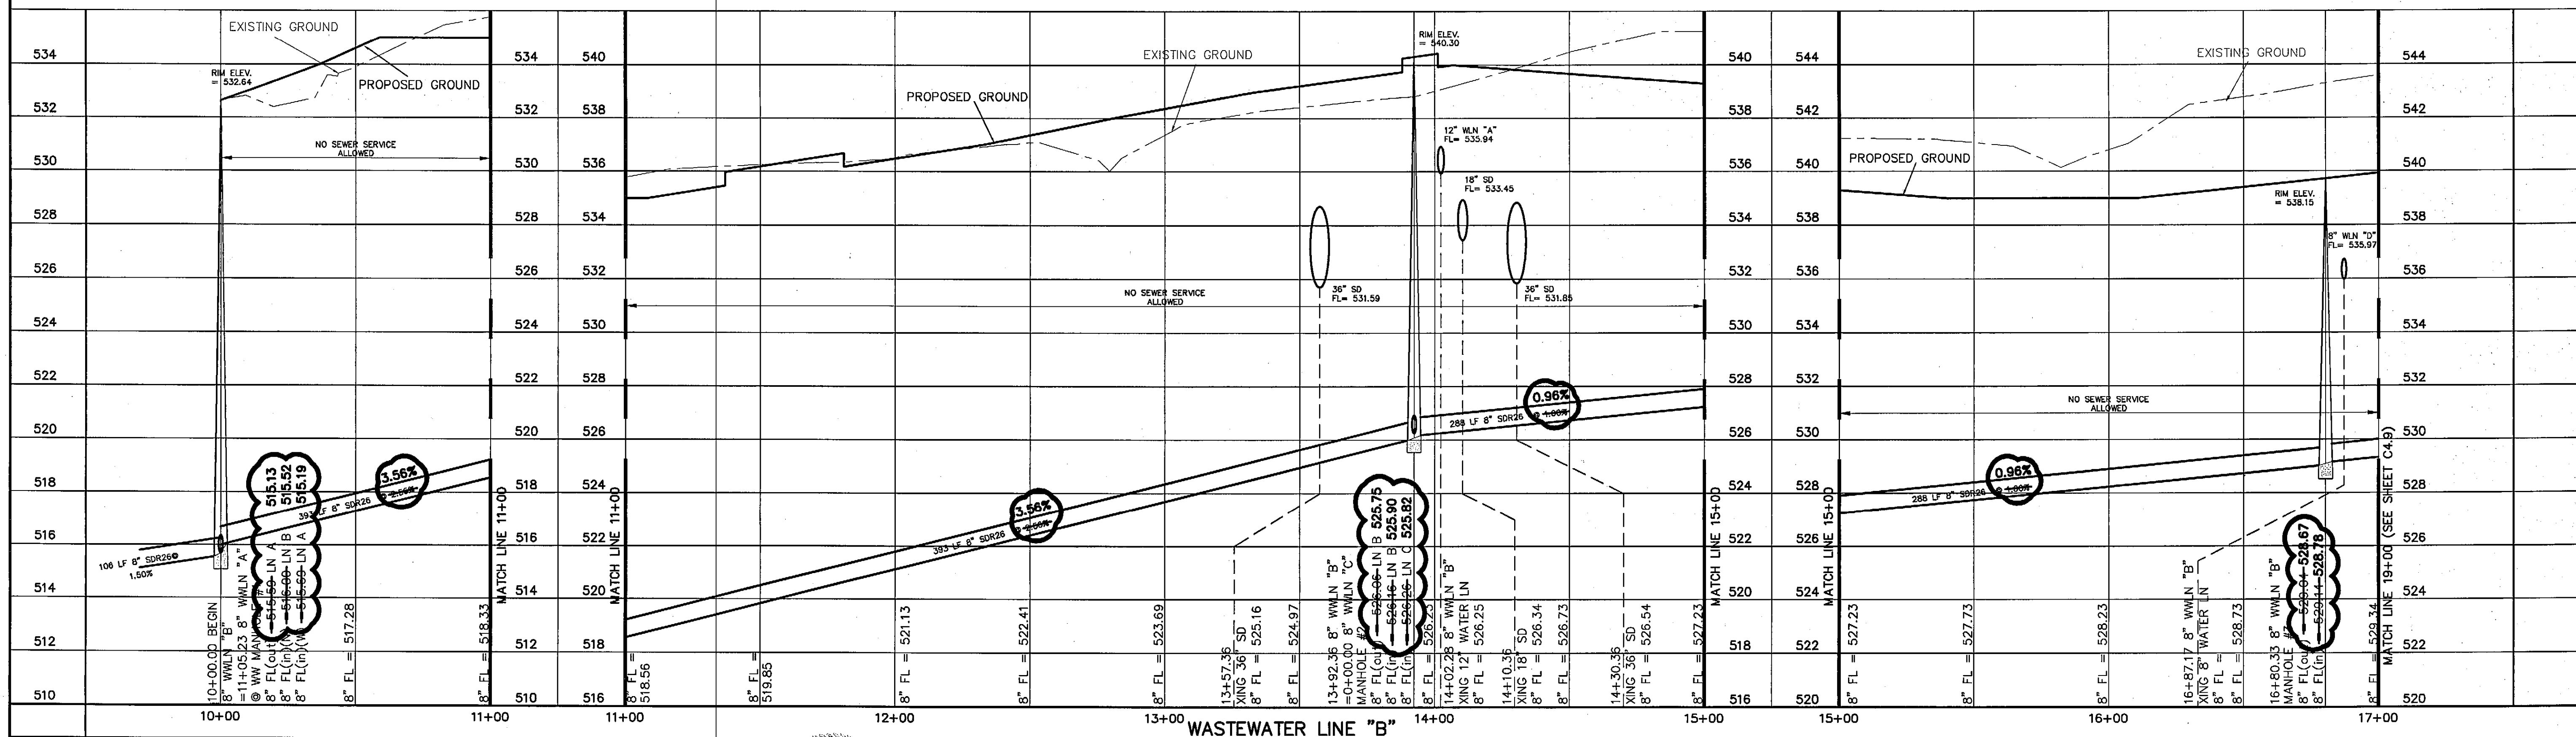

		DESIGNED: RDC DRAWN: FM CHECKED: RS		THE WALLACE GROUP INC. ENGINEERS ARCHITECTS SURVEYORS PLANNERS	THE WOODMONT COMPANY PLAZA AT ROCKWALL WASTEWATER PROFILE LINE "A & B"	SHEET 29 C4.8 OF 56 SHEETS
		"THE SEAL APPEARING ON THIS DOCUMENT WAS AUTHORIZED BY MATTHEW D. MORGAN, P.E. # 90326 ON THE DATE SHOWN ON THE GASTAMP. ALTERATION OF A SEALED DOCUMENT WITHOUT PROPER NOTIFICATION TO THE RESPONSIBLE ENGINEER IS AN OFFENSE UNDER THE TEXAS ENGINEERING PRACTICE ACT"			DATE: 3/25/08 NAME: Matthew D. Morgan	

REV	DATE	BY	DESCRIPTION