
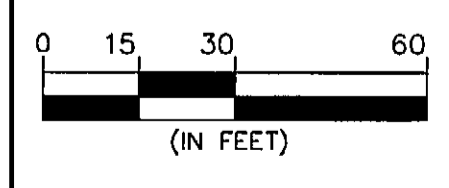


**DISCLAIMER**  
 TO THE BEST OF OUR KNOWLEDGE, THE WALLACE GROUP, INC. HEREBY STATES THAT THIS PLAN IS AS-BUILT/RECORD DRAWINGS. THE INFORMATION PROVIDED IS BASED ON SURVEYING CONDUCTED AT THE SITE AND INFORMATION PROVIDED BY THE CONTRACTOR.

REV	DATE	BY	DESCRIPTION
8-29-07		MM	Revised Pond A side slopes to 1.5:1; revised W.S.E.L. Line G
3-7-07		RSS	Add profile for Storm Lines I & J
3-5-07		RSS	Connect existing 24\"/>

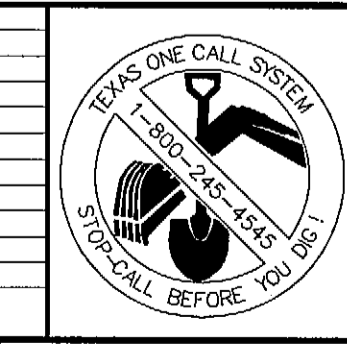

DESIGNED: \_\_\_\_\_  
 DRAWN: \_\_\_\_\_  
 CHECKED: \_\_\_\_\_

THE SEAL APPEARING ON THIS DOCUMENT WAS AUTHORIZED BY MATTHEW D. MORGAN, P.E. # 96329 ON THE DATE SHOWN ON THE DAYSTAMP. ALIENATION OF A SEALED DOCUMENT WITHOUT PROPER NOTIFICATION TO THE RESPONSIBLE ENGINEER IS AN OFFENSE UNDER THE TEXAS ENGINEERING PRACTICE ACT.

3/25/08 *Matthew D. Morgan*  
 DATE NAME

ENGINEERS ARCHITECTS SURVEYORS PLANNERS

THE WOODMONT COMPANY  
 PLAZA AT ROCKWALL  
 STORM LINES G-H

G:\Projects\18358\dwg\AS-BUILT\18358-AG\_C518-STORM-DWG\_STORM G-H (C5.18).DWG, 2/28/2008 4:10:01 PM, rrs, Xerox\_MyArt\_Lpd3\_11