


PLAZA AT ROCKWALL

PHASE II

ROCKWALL, TEXAS

RE--PLAT LOT __, BLOCK __ OF ROCKWALL CROSSING

PROJECT LOCATION MAP

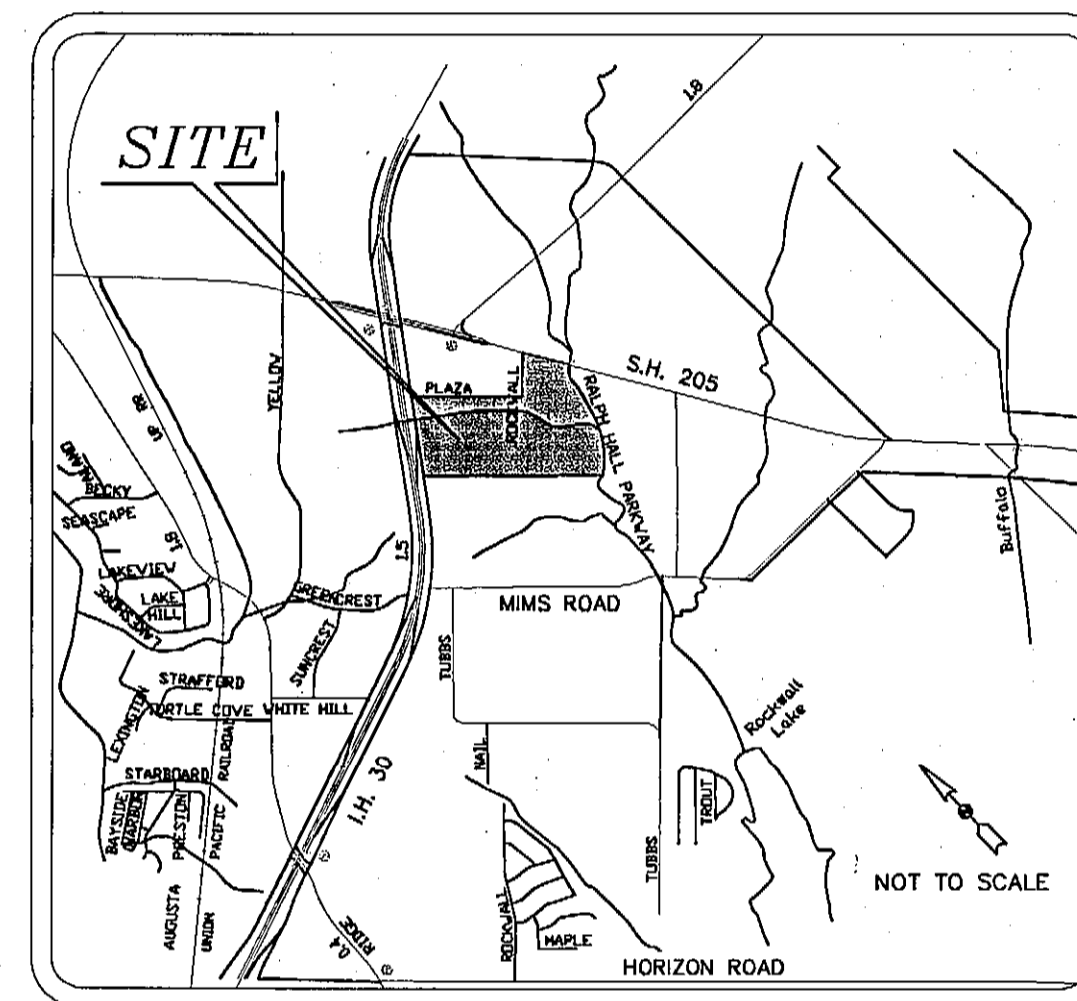

SHEET INDEX

SHEET #	DESCRIPTION
C1.0	COVER SHEET
C2.0-C2.0D	PLAT
C3.0	OVERALL SITE PLAN
C3.1-C3.6	SITE & DIMENSION CONTROL PLAN
C4.0	OVERALL UTILITY PLAN
C4.1-C4.6	UTILITY PLAN
C4.61-C4.62	16" WATER LINE PROFILE "W-1"
C4.7-4.9	WASTEWATER PROFILES "A, B & C"
C5.0	EXISTING DRAINAGE AREA MAP
C5.1	OFFSITE DRAINAGE AREA MAP
C5.2	PROPOSED DRAINAGE AREA MAP
C5.3	OVERALL GRADING PLAN
C5.4-C5.9	GRADING PLAN
C5.10-C5.12	DETENTION PONDS "A, B & C"
C5.13-C5.18	STORM DRAIN PROFILE
C5.19-C5.20	STORM SEWER NETWORK PLAN & HYDRAULIC DATA

OWNER/DEVELOPER:
 ROCKWALL CROSSING LTD.
 2100 WEST 7TH STREET
 FORT WORTH, TEXAS 76107
 PHONE: (817) 377-7736
 FAX: (817) 735-4738
 CONTACT: DON DALTON

CIVIL ENGINEER:
 THE WALLACE GROUP, INC.
 1825 MARKET CENTER BLVD., SUITE 210
 DALLAS, TEXAS 75207
 PHONE: (214) 747-3733
 FAX: (214) 747-7331
 CONTACT: MATTHEW D. MORGAN, P.E.

ARCHITECT:
 RUNYON ARCHITECTS
 2508 HIGHLANDER WAY, SUITE 210
 CARROLTON, TEXAS 75006
 PHONE: (972) 233-7705
 FAX: (972) 387-2553
 CONTACT: ROBERT RUNYON, A.I.A.

GEOTECHNICAL ENGINEER:
 REED ENGINEERING GROUP
 2424 STUTZ DRIVE, SUITE 400
 DALLAS, TEXAS 75235
 PHONE: (214) 350-5600
 FAX: (214) 350-0019
 CONTACT: RONALD F. REED, P.E.

DISCLAIMER

TO THE BEST OF OUR KNOWLEDGE, THE WALLACE GROUP, INC. HEREBY STATES THAT THIS PLAN IS AS-BUILT/RECORD DRAWINGS. THE INFORMATION PROVIDED IS BASED ON SURVEYING CONDUCTED AT THE SITE AND INFORMATION PROVIDED BY THE CONTRACTOR.

SUBMITTED BY:


Matthew D. Morgan
 MATTHEW D. MORGAN, P.E. #96329
 THE WALLACE GROUP, INC.

3/29/08
 DATE



Engineers ■ Architects ■ Planners ■ Surveyors

- WATER/WASTEWATER
- ENVIRONMENTAL
- STREETS/DRAINAGE
- BUILDING DESIGN
- FACILITIES MANAGEMENT

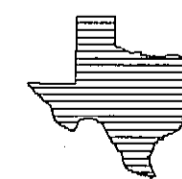

- MECHANICAL
- ELECTRICAL
- STRUCTURAL
- CADD
- GIS

3636 EXECUTIVE CENTER DRIVE, SUITE 210, AUSTIN, TEXAS 78731 PH: (512) 833-6828 FAX: (512) 833-3811

CONTRACTOR SHALL CALL 1-800-DIG-TESS FOR UTILITY LOCATIONS PRIOR TO ANY WORK IN EASEMENTS OR RIGHT-OF-WAY

