



REV	DATE	BY	DESCRIPTION
2-29-07	MM	MM	Revised Pond A side slopes to 1.5:1 changed HGL Line A1
4-12-07	MM	MM	Added 8\"/>
1-10-07	MM	MM	Revised Storm Connection for Staples and Inlet 7A to connect to 60\"/>

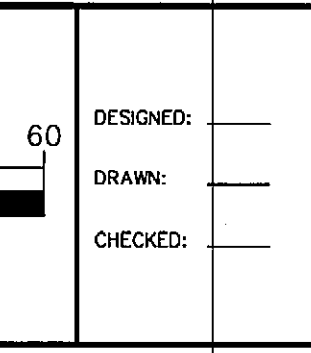

DESIGNED: _____
 DRAWN: _____
 CHECKED: _____

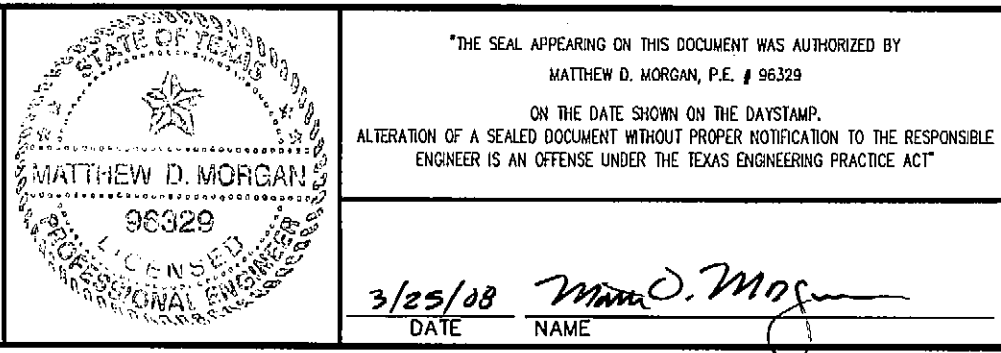

THE SEAL APPEARING ON THIS DOCUMENT WAS AUTHORIZED BY MATTHEW D. MORGAN, P.E. # 96928 ON THE DATE SHOWN ON THE DAYSTAMP. ALTERATION OF A SEALED DOCUMENT WITHOUT PROPER NOTIFICATION TO THE RESPONSIBLE ENGINEER IS AN OFFENSE UNDER THE TEXAS ENGINEERING PRACTICE ACT.

3/05/08 *Matthew D. Morgan*
 DATE NAME

ENGINEERS ARCHITECTS

THE WALLACE GROUP INC.

SURVEYORS PLANNERS

THE WOODMONT COMPANY

PLAZA AT ROCKWALL

STORM PROFILE LINE "A1 & A2"