

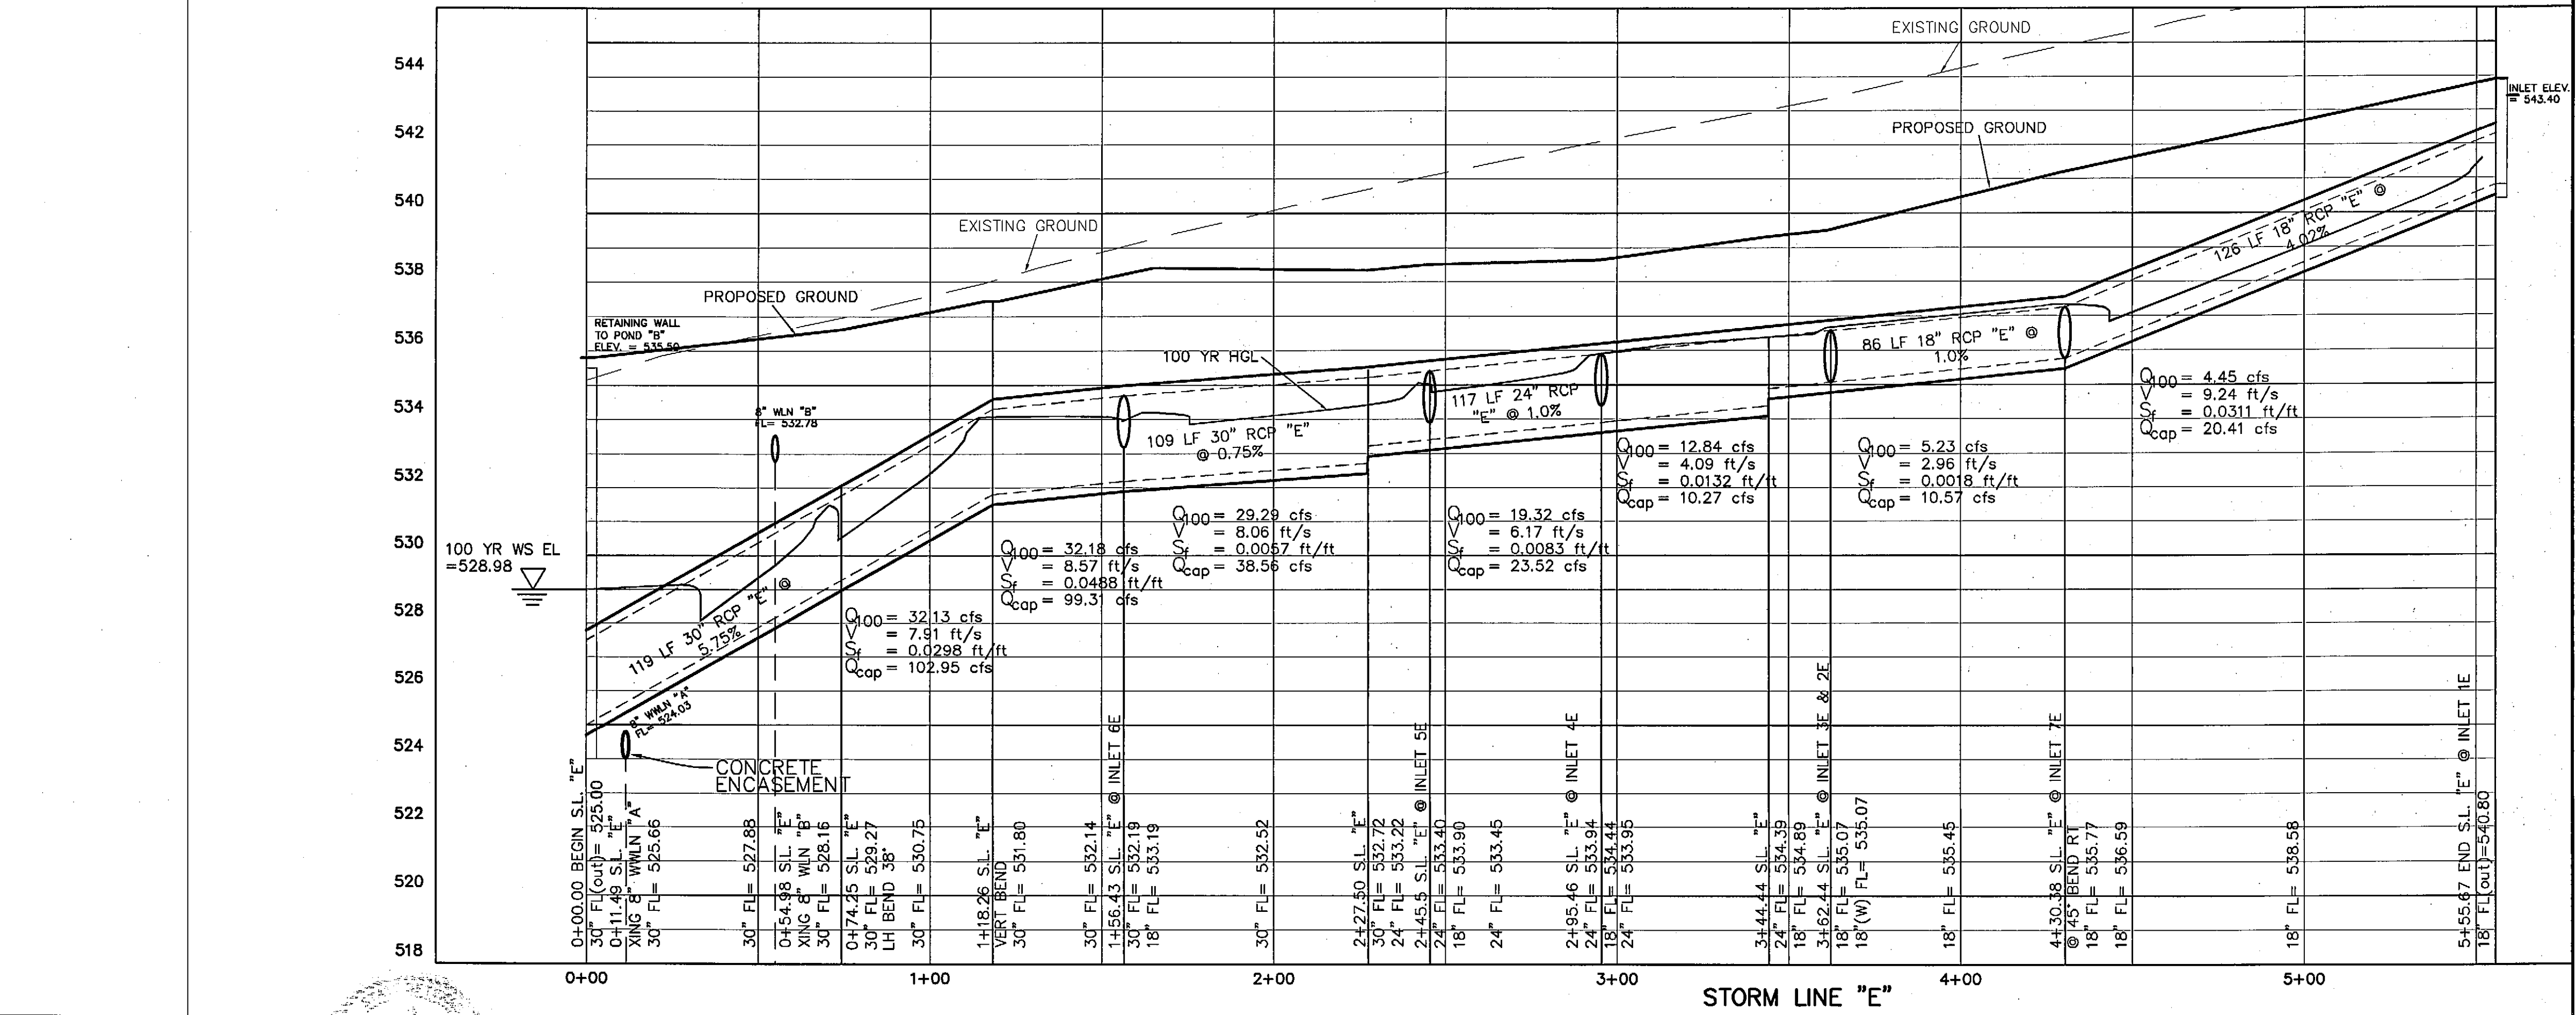
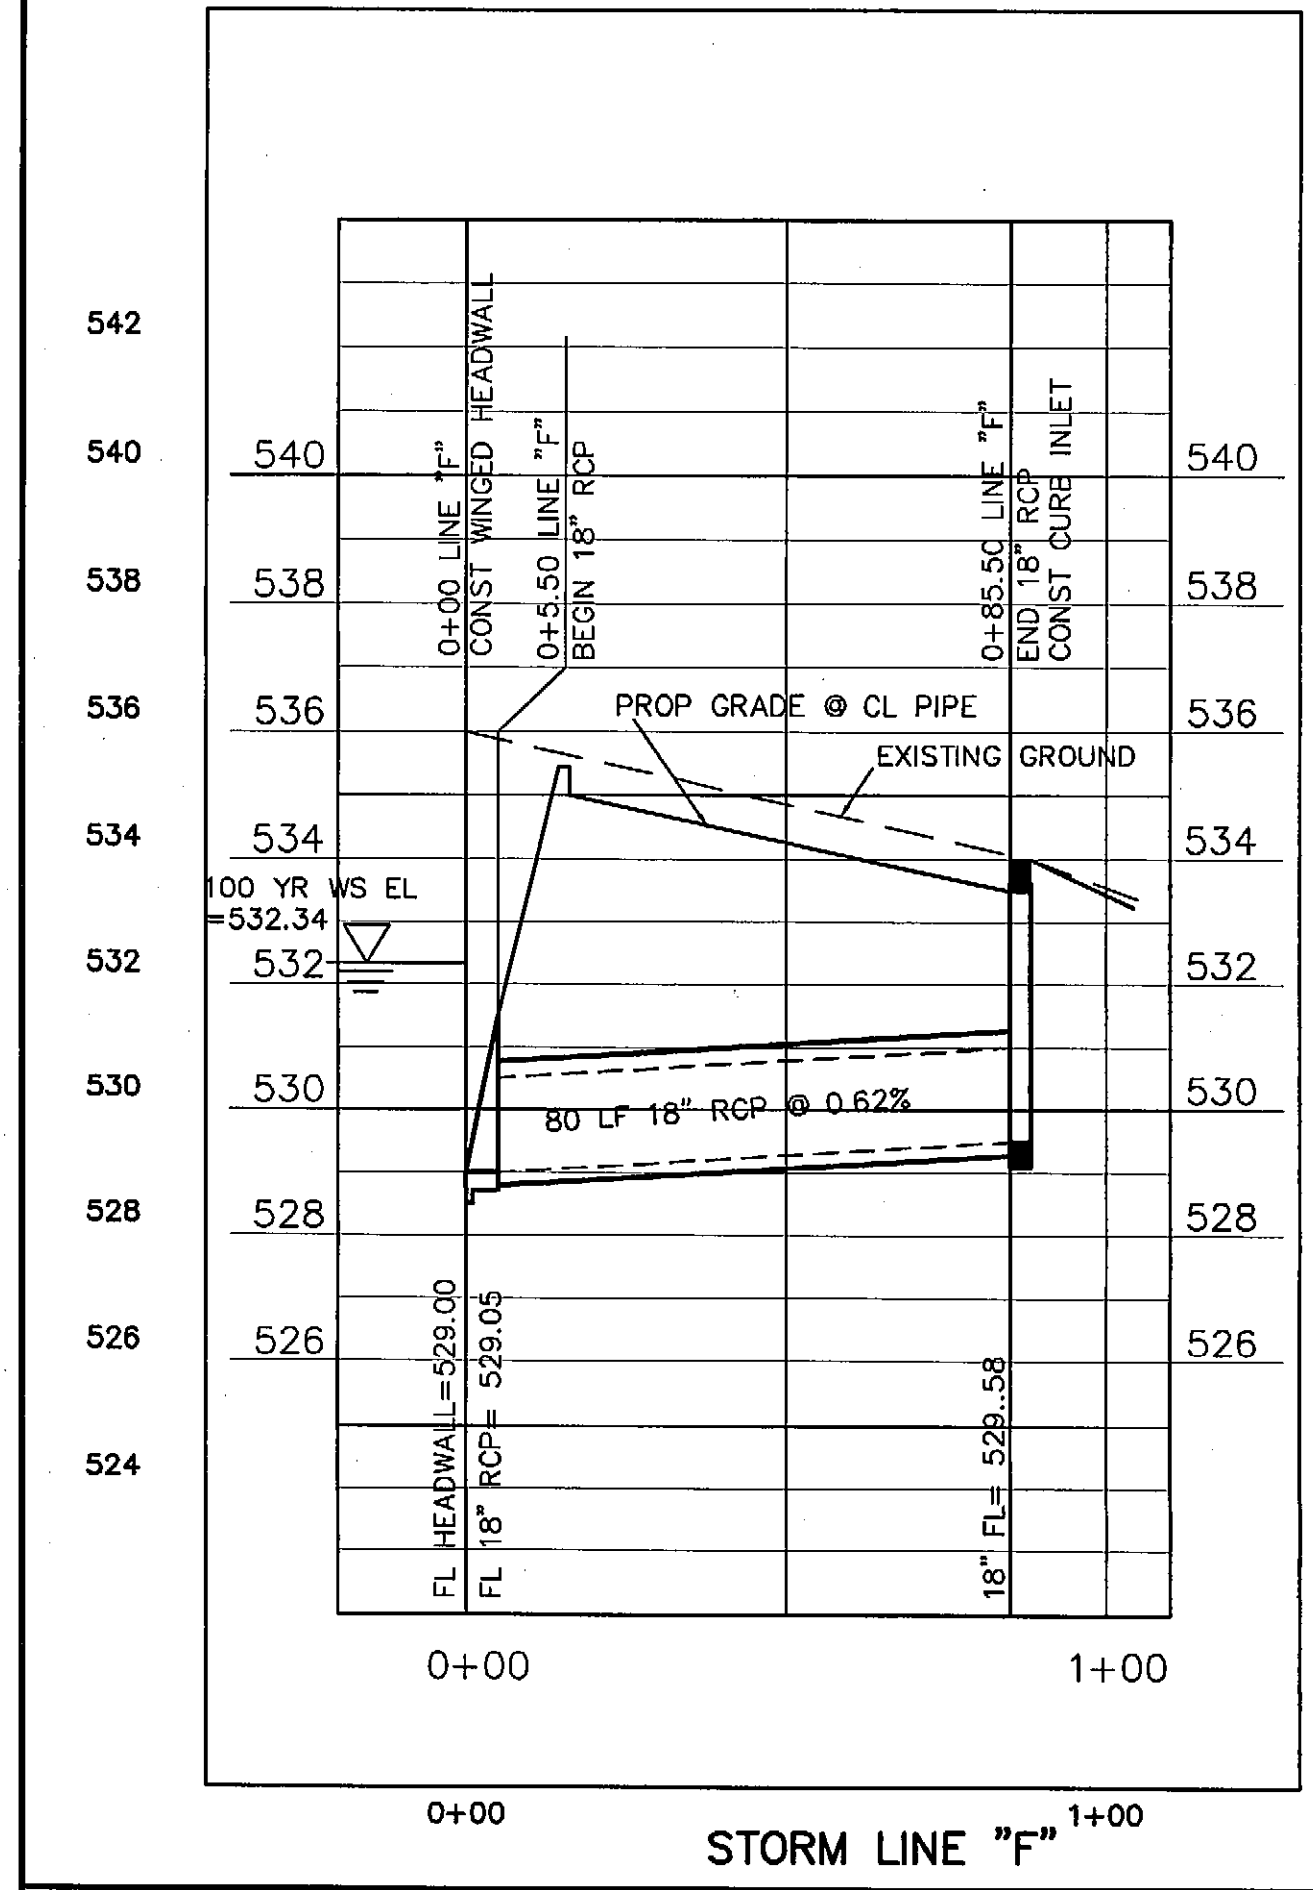


DISCLAIMER
 TO THE BEST OF OUR KNOWLEDGE, THE WALLACE GROUP, INC. HEREBY STATES THAT THIS PLAN IS AS-BUILT/RECORD DRAWINGS. THE INFORMATION PROVIDED IS BASED ON SURVEYING CONDUCTED AT THE SITE AND INFORMATION PROVIDED BY THE CONTRACTOR.

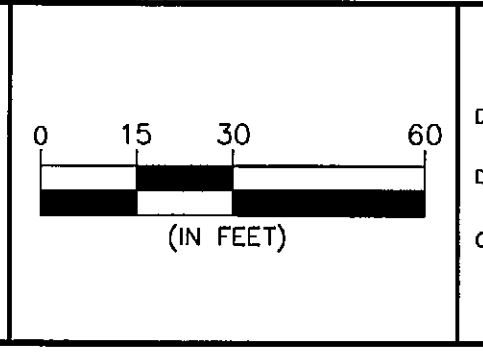

REV	DATE	BY	DESCRIPTION
1	1-12-07	MM	LOWRED SLOPE FOR FUTURE LOADING DOCK

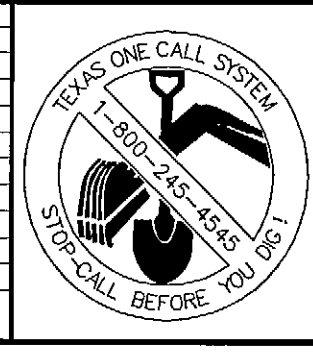

DESIGNED: _____
 DRAWN: _____
 CHECKED: _____

THE SEAL APPEARING ON THIS DOCUMENT WAS AUTHORIZED BY MATTHEW D. WOODMONT, P.E. # 96329 ON THE DATE SHOWN ON THE DAYSTAMP. CALIBRATION OF A SEALED DOCUMENT WITHOUT PROPER NOTIFICATION TO THE RESPONSIBLE ENGINEER IS AN OFFENSE UNDER THE TEXAS ENGINEERING PRACTICE ACT.

3/25/08 *Matthew D. Woodmont*
 DATE NAME

ENGINEERS ARCHITECTS

THE WALLACE GROUP INC.

SURVEYORS PLANNERS

THE WOODMONT COMPANY

PLAZA AT ROCKWALL

STORM PROFILE LINE "B4, C, D, E & F"

SHEET 48

C5.17

OF 56 SHEETS