

NOTE: INFORMATION ON THIS SHEET AND OTHER SHEETS THROUGHOUT THIS PLAN SET IS PART OF A UNIFIED DESIGN. THE CONTRACTOR SHALL NOT SEPERATE DRAWINGS FROM THE SET FOR DISTRIBUTION TO SPECIFIC DISCIPLINES. EACH SUBCONTRACTOR SHALL BE PROVIDED WITH ALL SHEETS WITHIN THIS PLAN SET.

CIVIL CONSTRUCTION PLANS


FOR

10,650 SQ. FT. RETAIL BUILDING PLAZA AT ROCKWALL SHOPPING CENTER

LOT 10

ROCKWALL BUSINESS PARK EAST SUBDIVISION


PLAZA AT ROCKWALL SHOPPING CENTER
ROCKWALL, TEXAS

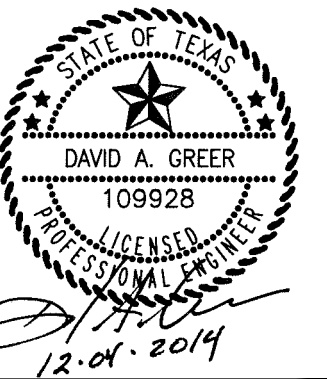

Design and construction documents as instruments of service are given in confidence and remain the property of Herschman Architects. The use of this design and these construction documents for purposes other than the specific project named herein is strictly prohibited without expressed written consent of Herschman Architects, Incorporated.

Date	Issue
9-26-2014	• BID/PERMIT
11-07-2014	• CITY COMMENTS
12-04-2014	• CITY COMMENTS
•	
•	
Drawn By:
Project No.: 14389

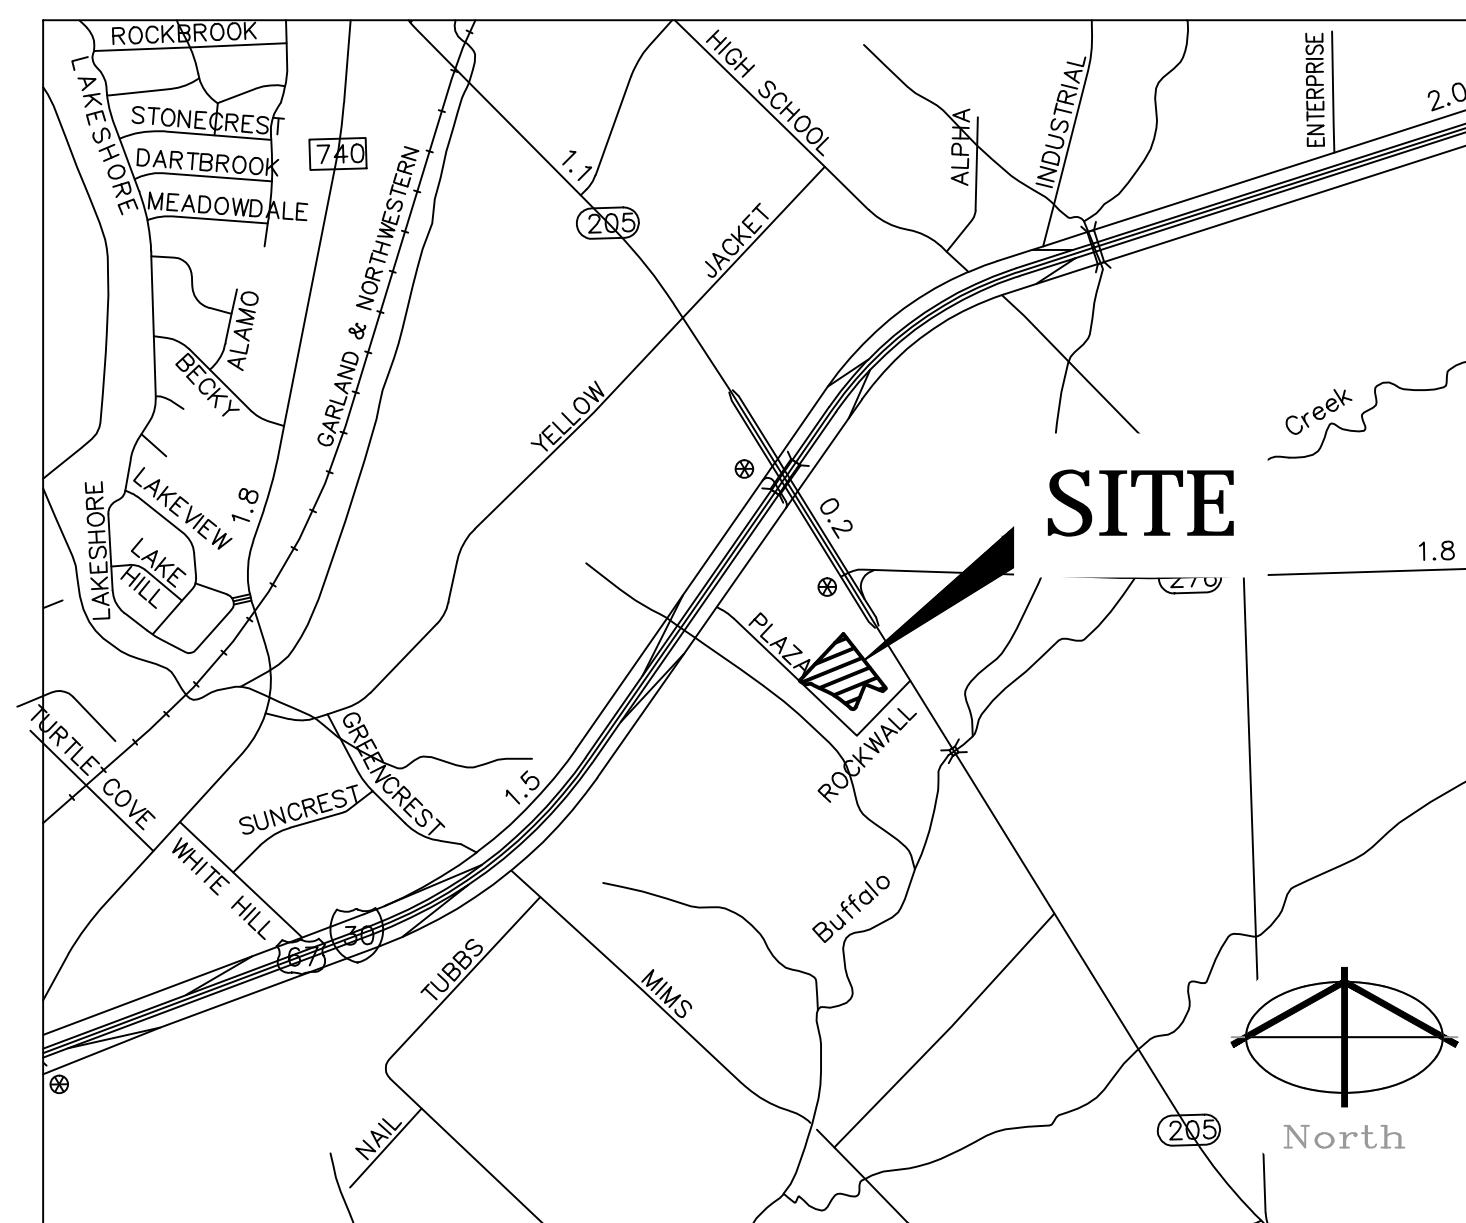

VICINITY MAP
N.T.S.

CITY OF ROCKWALL ROCKWALL COUNTY, TEXAS

DEVELOPER:
THE WOODMONT COMPANY
CONTACT: KAREN JONES
2100 W. 7TH STREET
FT. WORTH, TX
PH. (817) 732-4000
FAX. (817) 735-4738

PREPARED BY:
BANNISTER
ENGINEERING
1696 Country Club Drive | Mansfield, TX 76063 | 817.842.2094 | 817.842.2095 fax
REGISTRATION # F-10599 (TEXAS)

RECORD DRAWINGS
SEPTEMBER 2015

SHEET INDEX	
SHEET NO.	SHEET TITLE
C-0	COVER SHEET
C-0.1	PLAT
C-1.0	SITE PLAN
C-1.1	GENERAL NOTES
C-1.2	DEMOLITION PLAN
C-2.1	PAVING PLAN
C-3.1	GRADING PLAN
C-4.1	EXISTING DRAINAGE AREA MAP
C-4.2	EXISTING DRAINAGE AREA MAP
C-4.3	PROPOSED DRAINAGE AREA MAP
C-4.4	STORM DRAINAGE PLAN
C-4.5	STORM DRAINAGE DETAILS
C-5.1	WATER & SEWER PLAN
C-6.1	EROSION CONTROL PLAN
C-6.2	EROSION CONTROL DETAILS
C-7.1	CONSTRUCTION DETAILS
LA-1	LANDSCAPE PLANTING PLAN
LA-2	LANDSCAPE SPECIFICATIONS AND DETAILS
LA-3	PLAZA LAYOUT AND GRADING PLAN
LA-4	PLAZA DETAILS AND NOTES
TP-1	TREE PRESERVATION PLAN

RECORD DRAWING
TO THE BEST OF OUR KNOWLEDGE, BANNISTER ENGINEERING, LLC, HEREBY STATES THAT THIS PLAN IS AS-BUILT. THE INFORMATION PROVIDED IS BASED ON SURVEYING AT THE SITE AND INFORMATION PROVIDED BY THE CONTRACTOR. IN THE EVENT THAT THE ORIGINAL DESIGN WAS MODIFIED IN THE FIELD WITHOUT THE ENGINEER'S KNOWLEDGE, THE SEAL OR SIGNATURE ON THIS DRAWING IS NOT INTENDED TO INDICATE THE ENGINEER'S APPROVAL OR ACCEPTANCE OF ANY SUCH DEVIATIONS FROM THE DESIGN.
DATE: 09.25.15
DAVID A. GREER, P.E. 109928

811
Know what's below.
Call before you dig.
(@ least 48 hours prior to digging)

COVER SHEET
RETAIL BUILDING
PLAZA AT ROCKWALL SHOPPING CENTER
INTERSTATE HIGHWAY 30
ROCKWALL, TX

HERSCHMAN
ARCHITECTS
INCORPORATED
25001 EMERY ROAD, SUITE 400
CLEVELAND, OH 44128
TEL (216) 223-3200
FAX (216) 223-3210
www.herschmanarchitects.com

086-14-03

C-0