


# POPEYES CHICKEN & BISCUITS

## PAVING, DRAINAGE & UTILITY IMPROVEMENTS

### CITY OF ROCKWALL, TEXAS

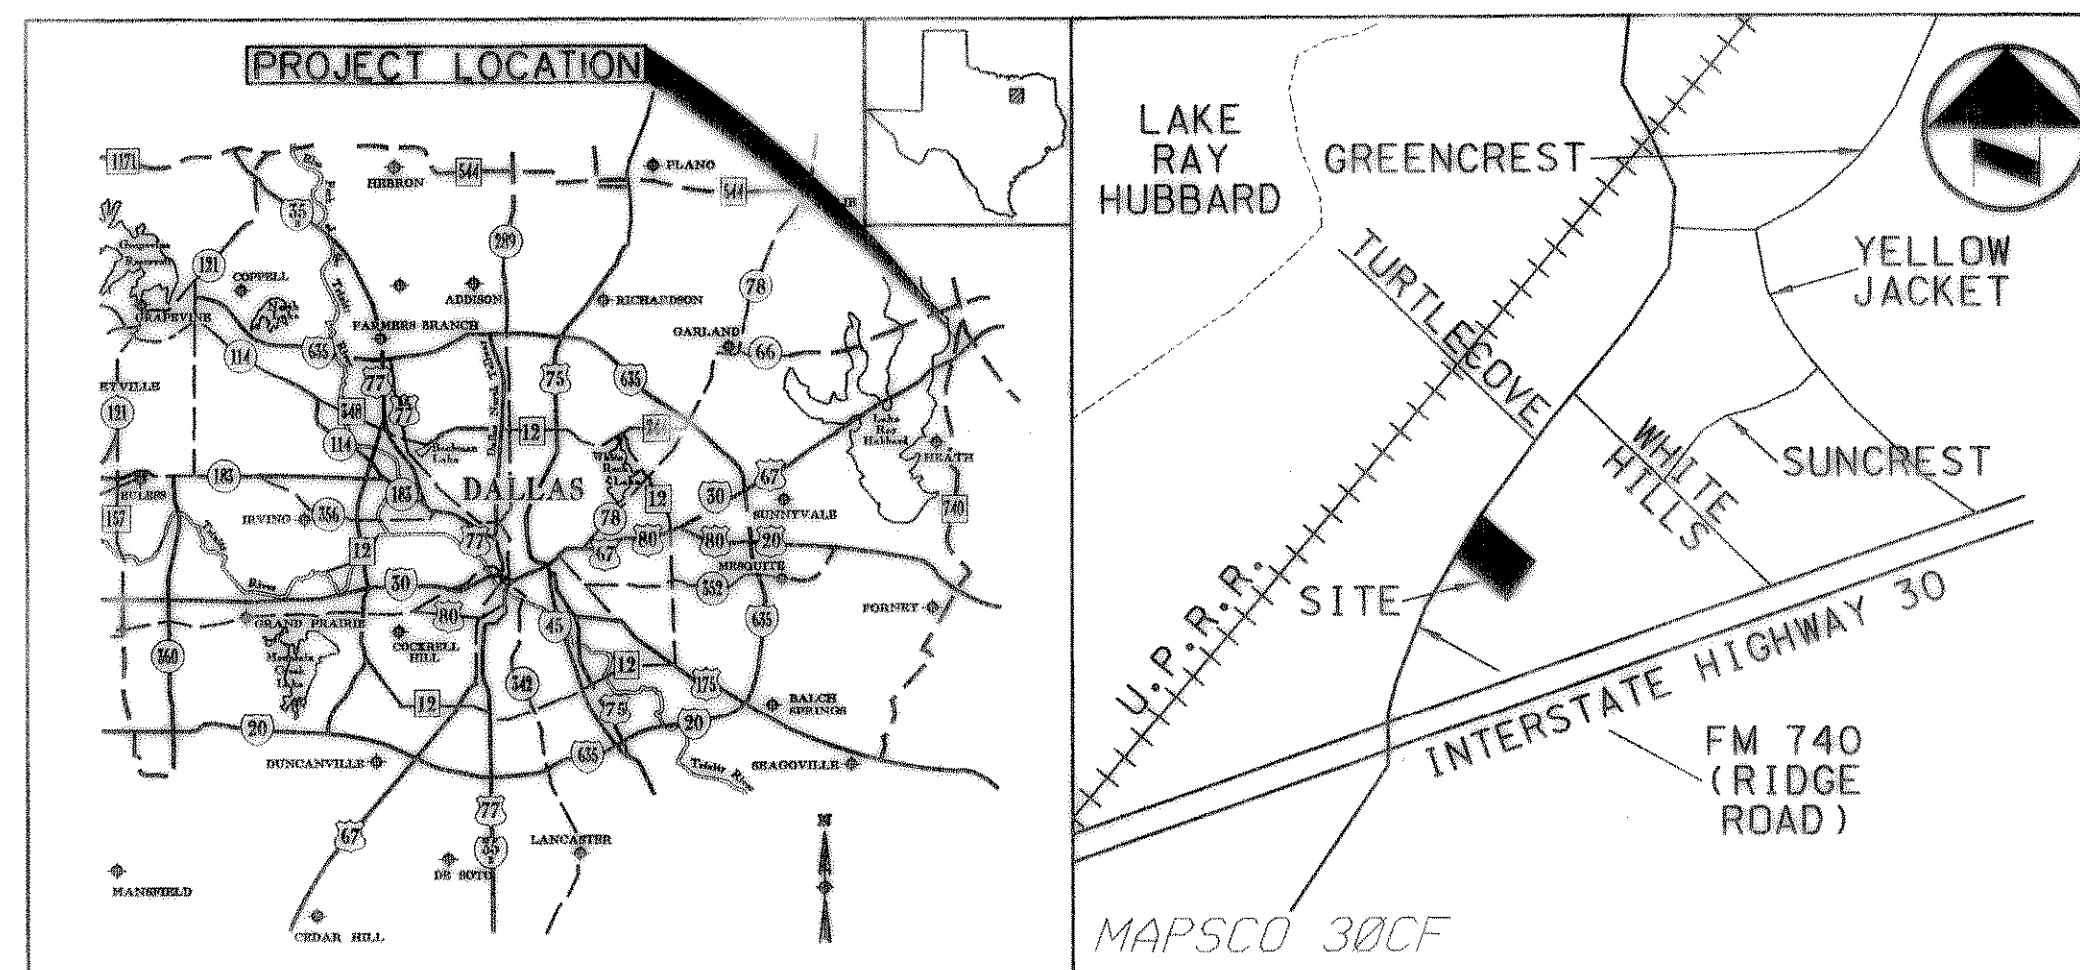

Professional Engineer Seal for Steven A. Helmsberger, State of Texas, No. 82948, dated 10/02.

#### SHEET INDEX

|                           |     |
|---------------------------|-----|
| COVER                     | FP1 |
| FINAL PLAN                | C1  |
| SITE PLAN                 | C2  |
| PAVING AND UTILITY PLAN   | C3  |
| GRADING AND DRAINAGE PLAN | C4  |
| EROSION CONTROL PLAN      |     |

ENGINEER:  
**HELMBERGER ASSOCIATES, INC.**  
 CIVIL AND ENVIRONMENTAL ENGINEERS  
 124 HOOPER ROAD, WYLIE TEXAS 75098 (972) 442-7459

OWNER:  
**CORRAL GROUP, INC.**  
 7750 N. MCARTHUR BOULEVARD  
 SUITES 120 - 221  
 IRVING, TEXAS 76084  
 972.556.1567

AS-BUILT 10-03-02

THIS DOCUMENT IS SUBMITTED AS AN "AS-BUILT DRAWING" FOR RECORD PURPOSES ONLY. ANY MODIFICATION OR CHANGES THAT HAVE BEEN MADE DURING CONSTRUCTION AND NOTED ON THIS DRAWING HAVE BEEN SUPPLIED BY THE OWNER, HIS REPRESENTATIVE OR THE CONTRACTOR. FIELD INSPECTION/CONTRACT SUPERVISION OF THE CONSTRUCTION WAS PERFORMED BY OTHERS. IT IS NOT GUARANTEED BY HELMBERGER ASSOCIATES, INC. THAT THIS DOCUMENT REPRESENTS "AS-BUILT" CONDITIONS.