


NOTE: Drainage detention is required for the parking lot.

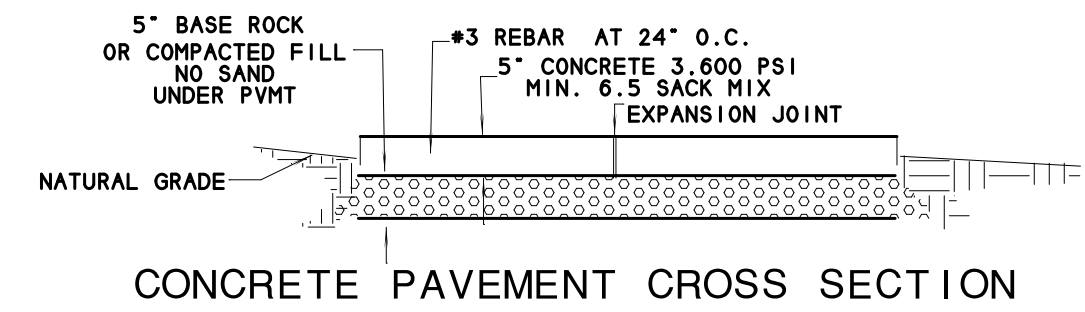

**SITE PLAN**  
**PREGNANCY RESOURCE CENTER**  
**1010 RIDGE ROAD**

OWNER:  
 PREGNANCY RESOURCE CENTER  
 713 W. RUSK STREET  
 ROCKWALL, TEXAS 75087  
 972-722-8292

SYMBOL LEGEND			
⊙	TV	⊙	TEL
⊙	TELEVISION	⊙	PHONE
⊙	CABLE RISER	⊙	RISER
⊙	GAS	⊙	FIRE
⊙	HYDRANT	⊙	HYDRANT
⊙	ELEC	⊙	LP
⊙	ELECTRIC	⊙	WATER
⊙	METER	⊙	POLE
⊙	BOX	⊙	4\"/>

**H.D. Fetty Land Surveyor, LLC**  
 6770 FM 1565 ROYSE CITY, TX 75189 972-635-2255 PHONE tracy@hdfetty.com

SURVEY DATE MAY 15, 2015  
 SCALE 1" = 20' FILE # 20150158-SP  
 CLIENT PRC GF # NONE