


**CAUTION:**  
CONTRACTOR TO VERIFY EXACT LOCATIONS OFF ALL UNDERGROUND CABLES AND FIBER OPTIC LINES PRIOR TO EXCAVATION.

**AS BUILT**  
THIS IS TO CERTIFY THAT CHANGES AND CORRECTIONS HAVE BEEN MADE TO CONFORM TO THE CONTRACTOR'S RECORD OF THIS PROJECT.

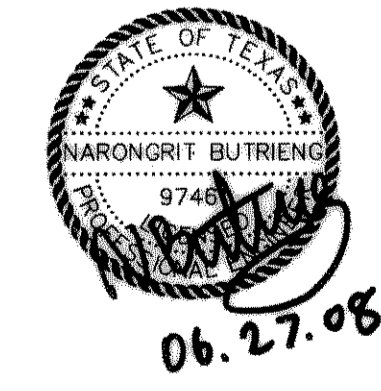

**PLAN AND PROFILE FOR 16" PVC WATER LINE LINE "A" STA. 0+00 TO 9+50**  
**HORIZON ROAD (FM 3097), SUMMER LEE DRIVE, AND TUBBS ROAD IMPROVEMENTS**  
**CITY OF ROCKWALL, TEXAS**

**PSA ENGINEERING**  
 17819 DAVENPORT ROAD, SUITE 215 DALLAS, TX 75252 (972) 248-9651

DESIGN	DRAWN	DATE	SCALE	CHECK	FILE	NO.
RNB	PSA	06/27/08	AS SHOWN	PSS	2607.PHR	C-14

**AS BUILT**

Y:\2607.PHR\AS-BUILT\C-14-15-16.dwg