

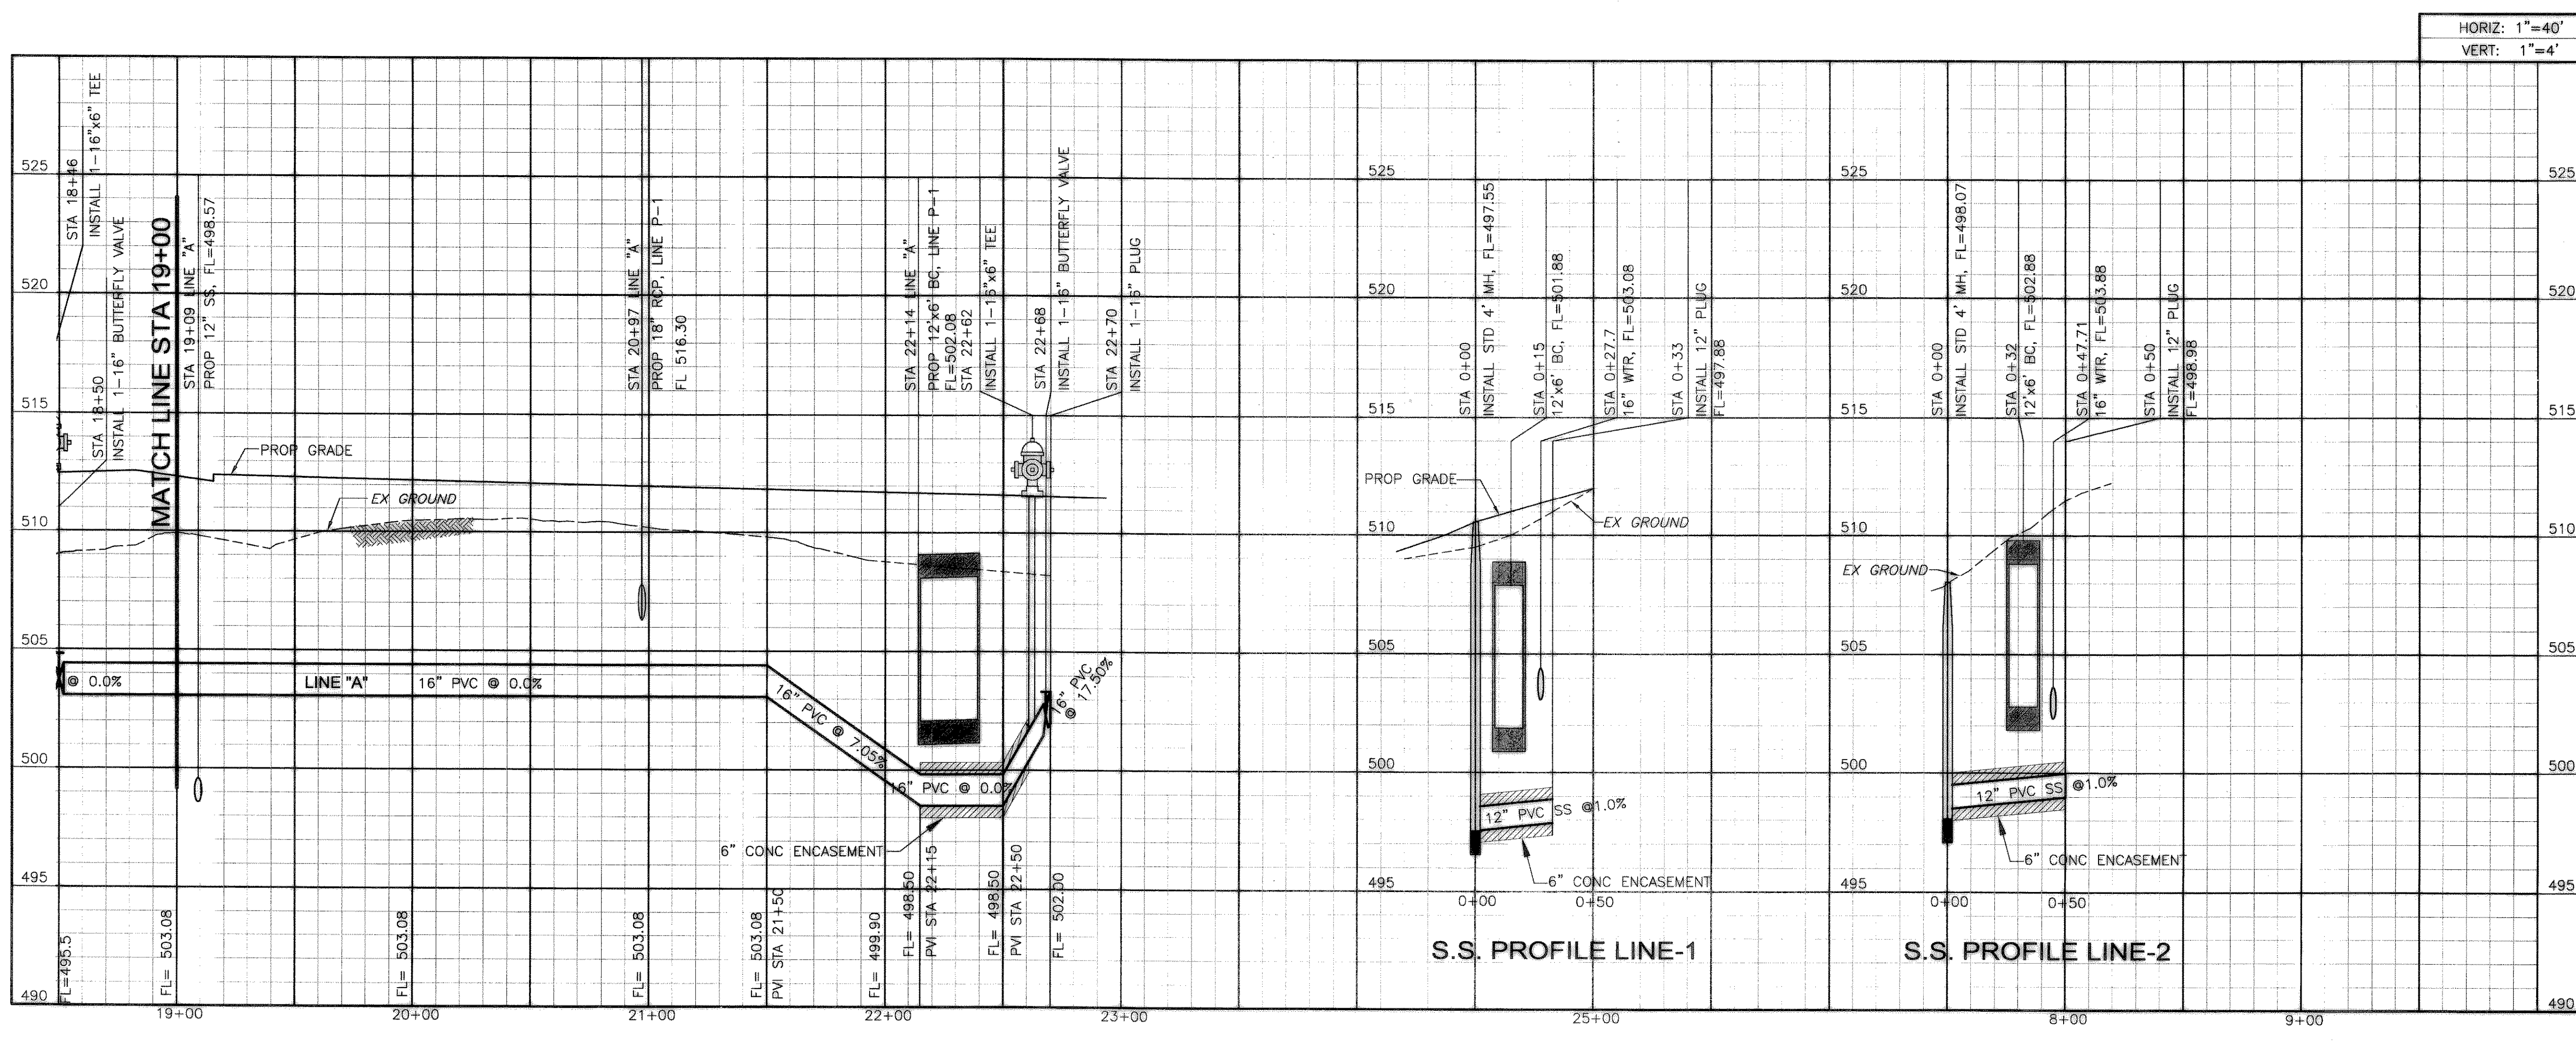


CAUTION:
CONTRACTOR TO VERIFY EXACT LOCATIONS
OFF ALL UNDERGROUND CABLES AND FIBER
OPTIC LINES PRIOR TO EXCAVATION.

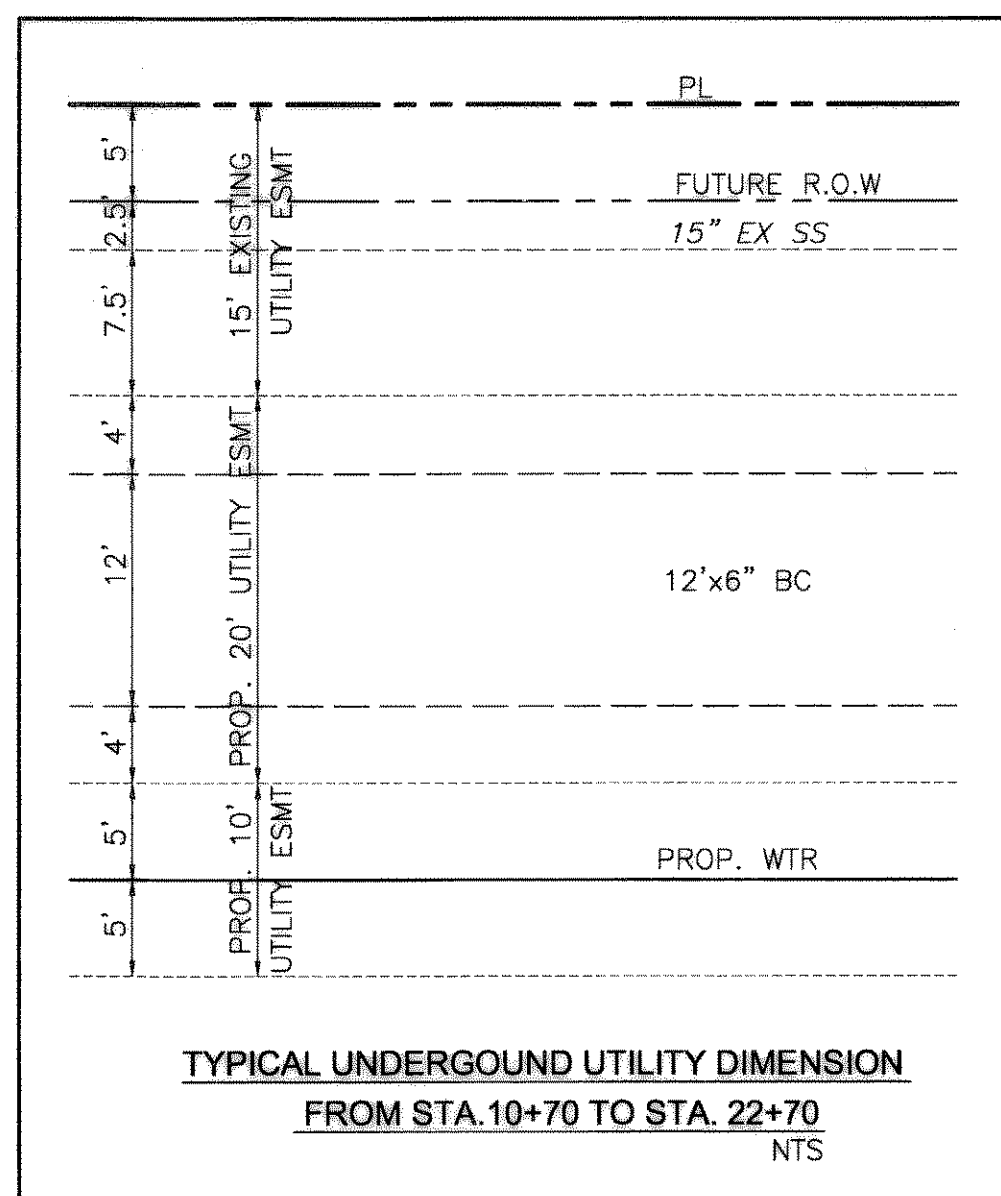

AS BUILT
THIS IS TO VERIFY THAT CHANGES AND
CORRECTIONS HAVE BEEN MADE TO
CONFORM TO THE CONTRACTOR'S
RECORD OF THIS PROJECT.

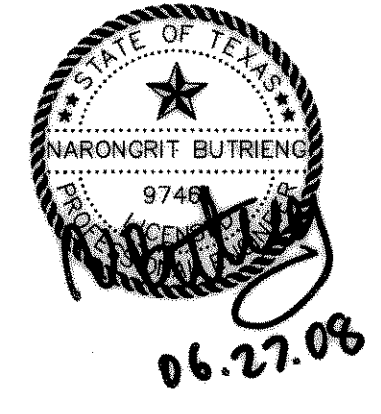

**PLAN AND PROFILE FOR 16" PVC WATER LINE
LINE "A" STA. 19+00 TO 22+70**

**HORIZON ROAD (FM 3097), SUMMER LEE DRIVE,
AND TUBBS ROAD IMPROVEMENTS**

CITY OF ROCKWALL, TEXAS

PSA ENGINEERING
17819 DAVENPORT ROAD, SUITE 215 DALLAS, TX 75282 (972) 248-0651

DESIGN	DRAWN	DATE	SCALE	CHECK	FILE	NO.
RNB	PSA	06/27/08	AS SHOWN	PSS	2607.PHR	C-16

Y:\2006\2607.PHR\AS-BUILT\C-14-15-16.dwg