


AS BUILT

THIS IS TO CERTIFY THAT CHANGES AND CORRECTIONS HAVE BEEN MADE TO CONFORM TO THE CONTRACTOR'S RECORD OF THIS PROJECT.

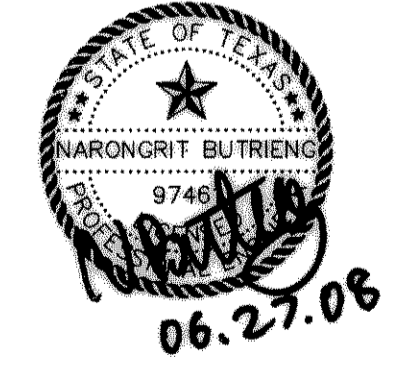

PLAN AND PROFILE OF SANITARY SEWER LINE 1						
HORIZON ROAD (FM 3097), SUMMER LEE DRIVE, AND TUBBS ROAD IMPROVEMENTS						
CITY OF ROCKWALL, TEXAS						
PSA ENGINEERING 17819 DAVENPORT ROAD, SUITE 215 DALLAS, TX 75252 (972) 248-9651						
DESIGN	DRAWN	DATE	SCALE	CHECK	FILE	NO.
RNB	PSA	06/27/08	AS SHOWN	PSS	2607.PHR	C-18

AS BUILT

Y:\2008\2607.PHR\AS-BUILT\C-18.dwg