


AS BUILT
 THIS IS TO CERTIFY THAT CHANGES AND CORRECTIONS HAVE BEEN MADE TO CONFORM TO THE CONTRACTOR'S RECORD OF THIS PROJECT.

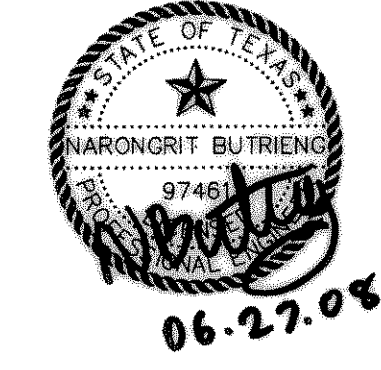

**PLAN AND PROFILE FOR
 LINE "T" LATERALS**

HORIZON ROAD (FM 3097), SUMMER LEE DRIVE,
 AND TUBBS ROAD IMPROVEMENTS

CITY OF ROCKWALL, TEXAS

PSA ENGINEERING
 17819 DAVENPORT ROAD, SUITE 215 DALLAS, TX 75252 (972) 248-9851

DESIGN	DRAWN	DATE	SCALE	CHECK	FILE	NO.
RNB	PSA	06/27/08	AS SHOWN	PSS	2607.PHR	C-9

AS BUILT

Y:\2006\2607_PHR\AS-BUILT\C-9.dwg