



LEGEND

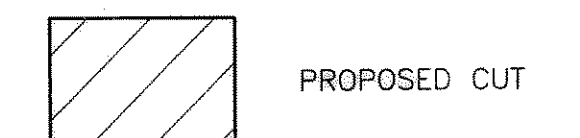

PROPOSED CUT

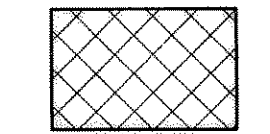

PROPOSED FILL

SCALE 1:4 V
1:40 H

AS BUILT

THIS IS TO CERTIFY THAT CHANGES AND CORRECTIONS HAVE BEEN MADE TO CONFORM TO THE CONTRACTOR'S RECORD OF THIS PROJECT.



**RAINBOW LAKE DETENTION POND
CROSS SECTION R-13 & R-14**

HORIZON ROAD (FM 3097), SUMMER LEE DRIVE,
AND TUBBS ROAD IMPROVEMENTS

CITY OF ROCKWALL, TEXAS

PSA ENGINEERING
17819 DAVENPORT ROAD, SUITE 215 DALLAS, TX 75262 (972) 248-9651

DESIGN	DRAWN	DATE	SCALE	CHECK	FILE	NO.
RNB	PSA	06/27/08	AS SHOWN	PSS	2607.PHR	D-10

AS BUILT