


**LEGEND**




PROPOSED CUT

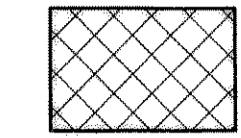

PROPOSED FILL

SCALE 1:4 V  
1:40 H

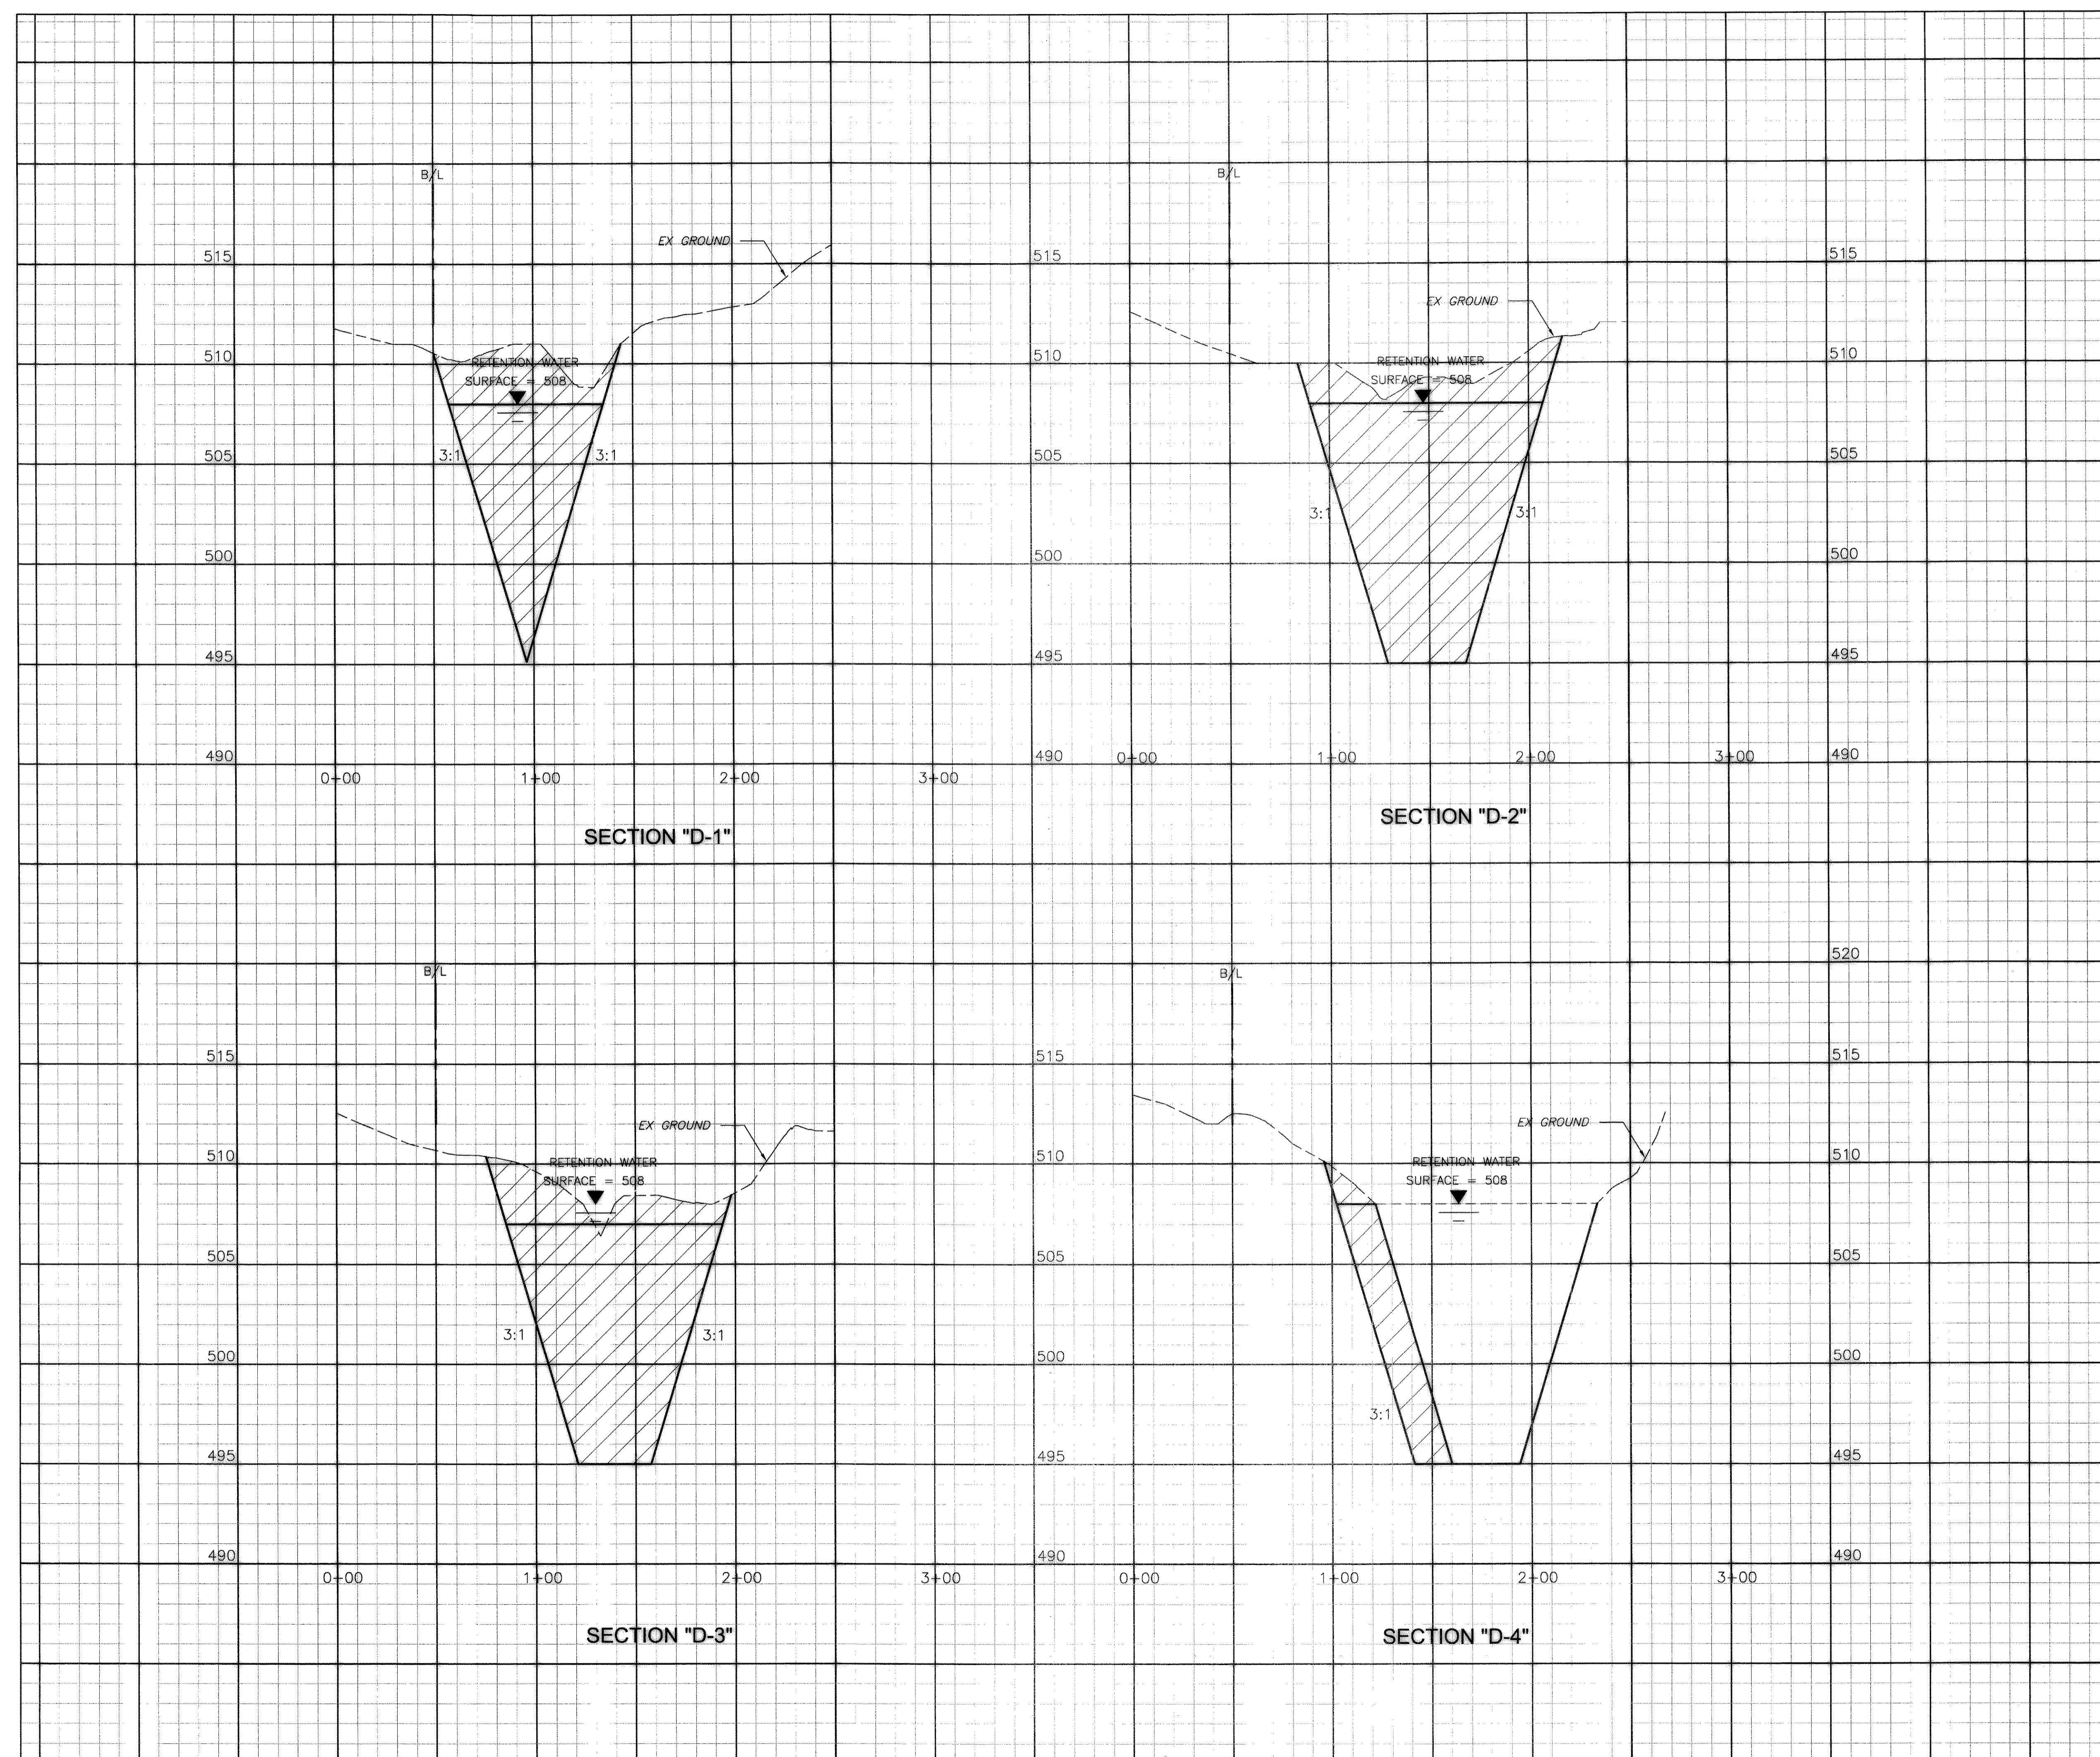

**AS BUILT**

THIS IS TO CERTIFY THAT CHANGES AND CORRECTIONS HAVE BEEN MADE TO CONFORM TO THE CONTRACTOR'S RECORD OF THIS PROJECT.



**FOX CHASE PARK DETENTION POND EXPANSION CROSS SECTIONS**

HORIZON ROAD (FM 3097), SUMMER LEE DRIVE, AND TUBBS ROAD IMPROVEMENTS  
CITY OF ROCKWALL, TEXAS

**PSA ENGINEERING**  
17819 DAVENPORT ROAD, SUITE 215 DALLAS, TX 75262 (972) 248-9851

DESIGN	DRAWN	DATE	SCALE	CHECK	FILE	NO.
RNB	PSA	06/27/08	AS SHOWN	PSS	2607.PHR	D-2

AS BUILT