
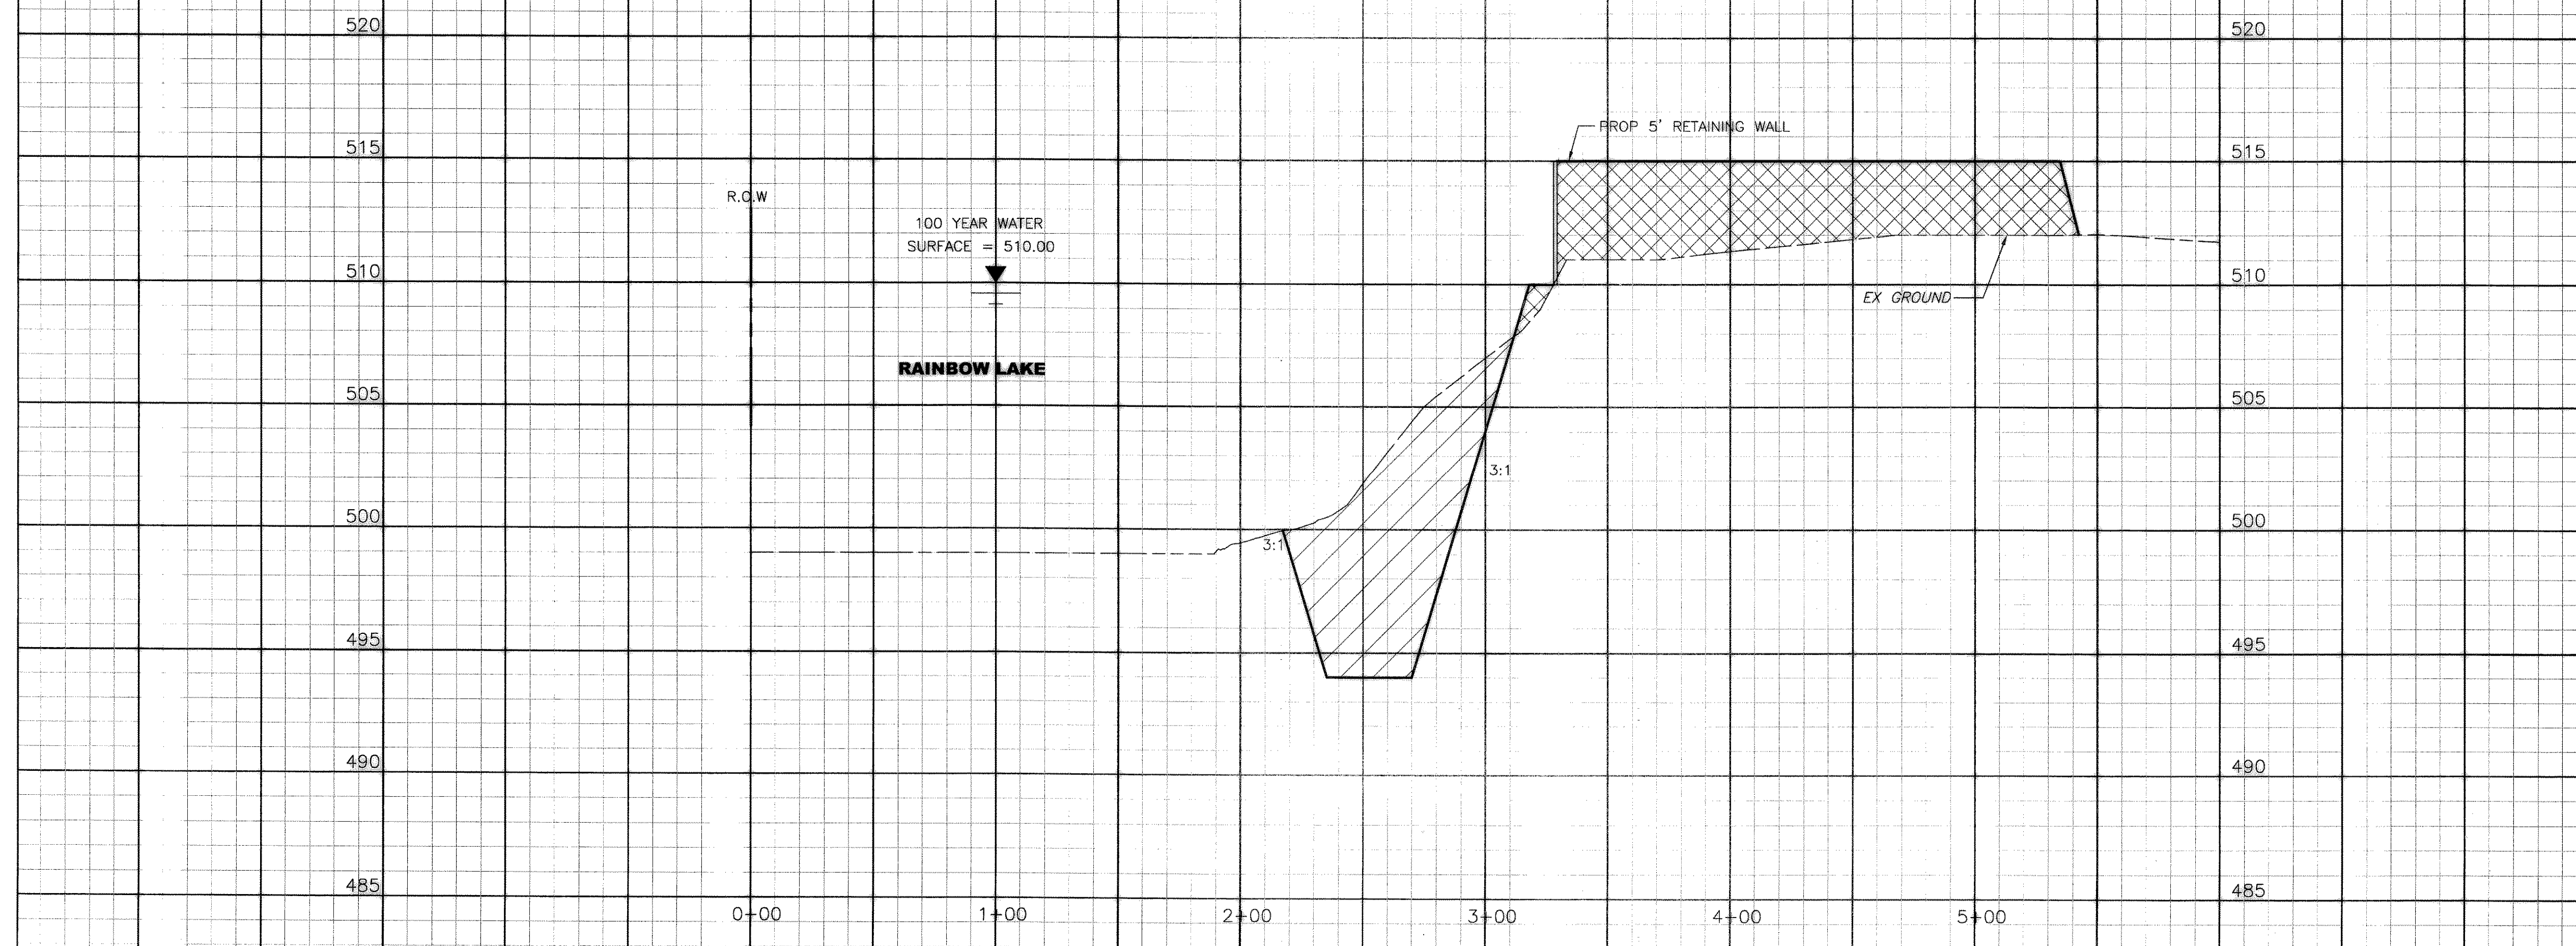



SECTION "R-11"

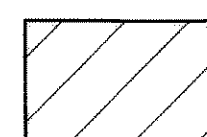

SECTION "R-12"

LEGEND

 PROPOSED CUT

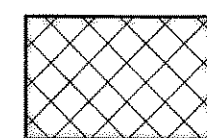 PROPOSED FILL

SCALE 1:4 V
1:40 H

AS BUILT

THIS IS TO CERTIFY THAT CHANGES AND CORRECTIONS HAVE BEEN MADE TO CONFORM TO THE CONTRACTOR'S RECORD OF THIS PROJECT.



RAINBOW LAKE DETENTION POND CROSS SECTION R-11 & R-12						
HORIZON ROAD (FM 3097), SUMMER LEE DRIVE, AND TUBBS ROAD IMPROVEMENTS						
CITY OF ROCKWALL, TEXAS						
PSA ENGINEERING 17819 DAVENPORT ROAD, SUITE 215 DALLAS, TX 75282 (972) 248-9651						
DESIGN	DRAWN	DATE	SCALE	CHECK	FILE	NO.
RNB	PSA	06/27/08	AS SHOWN	PSS	2607.PHR	D-9

Y:\2006\2607.PHR\AS-BUILT\2-4-5-6-7-9-10.dwg

AS BUILT