


INSTALL  
 1-2"x2" TEE  
 1-2" PLUG  
 2-2" GATE VALVE  
 1-2" WATER METER  
 1-2" DOUBLE CHECK VALVE

INSTALL  
 1-2" PLUG

**AS BUILT**  
 THIS IS TO CERTIFY THAT CHANGES AND CORRECTIONS HAVE BEEN MADE TO CONFORM TO THE CONTRACTOR'S RECORD OF THIS PROJECT.

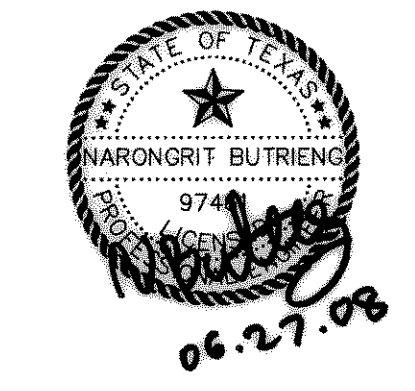

**UTILITY IMPROVEMENT AT FOX CHASE PARK**

**HORIZON ROAD (FM 3097), SUMMER LEE DRIVE, AND TUBBS ROAD IMPROVEMENTS**

**CITY OF ROCKWALL, TEXAS**

**PSA ENGINEERING**  
 17819 DAVENPORT ROAD, SUITE 215 DALLAS, TX 75252 (972) 248-9651

DESIGN	DRAWN	DATE	SCALE	CHECK	FILE	NO.
RNB	PSA	06/27/08	AS SHOWN	PSS	2607.PHR	FC-1