


LEGEND

	EXISTING POND
	PROP. POND

PROPOSED RETENTION POND EXPANSION
BOTTOM ELEVATION 495

CROSS SECTION	CUT	
	AREA SF	VOL CF
R-1	211.00	24,360.00
R-2	276.00	13,050.00
R-3	246.00	11,300.00
R-4	206.00	
TOTAL		48,700.00

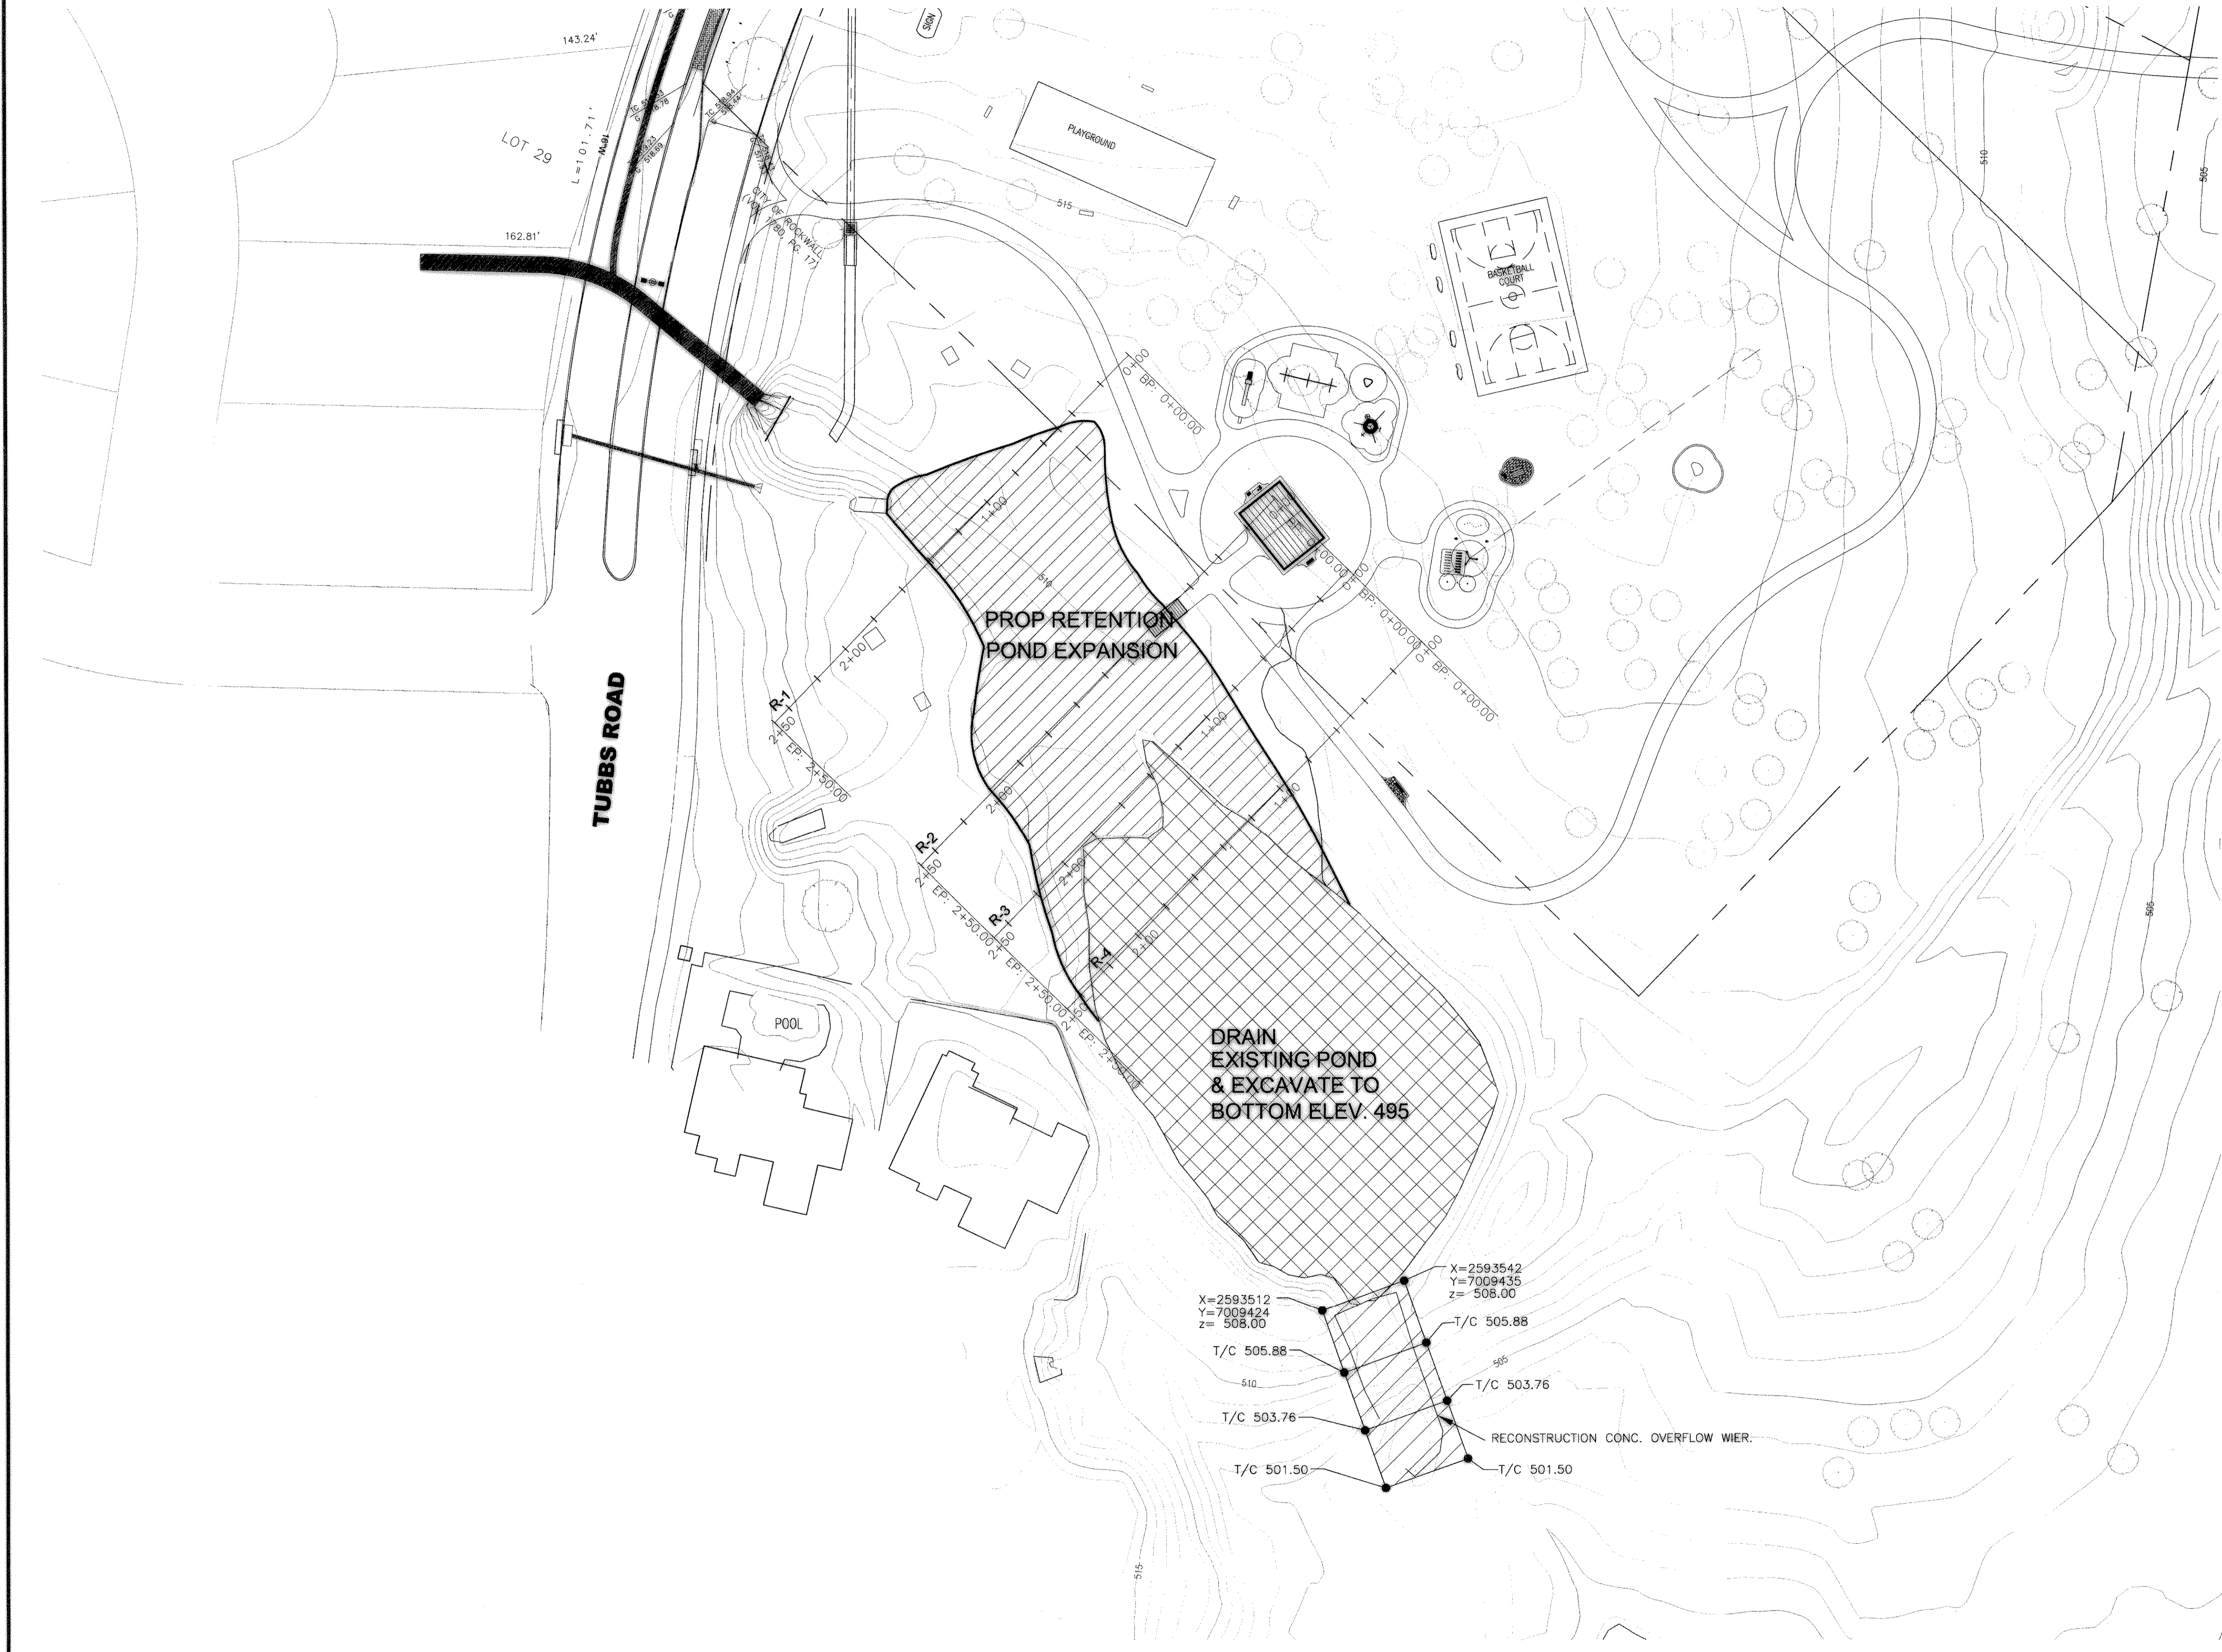

AS BUILT
 THIS IS TO VERIFY THAT CHANGES AND CORRECTIONS HAVE BEEN MADE TO CONFORM TO THE CONTRACTOR'S RECORD OF THIS PROJECT.



FOX CHASE PARK DETENTION POND EXPANSION PLAN

HORIZON ROAD (FM 3097), SUMMER LEE DRIVE, AND TUBBS ROAD IMPROVEMENTS

CITY OF ROCKWALL, TEXAS

PSA ENGINEERING
 17819 DAVENPORT ROAD, SUITE 215 DALLAS, TX 75252 (972) 248-9651

DESIGN	DRAWN	DATE	SCALE	CHECK	FILE	NO.
RNB	PSA	06/27/08	AS SHOWN	PSS	2607.PHR	D-1

C:\3006\2607.PHR\AS-BUILT\1D-13.dwg

AS BUILT