


AS BUILT
 THIS IS TO VERIFY THAT CHANGES AND CORRECTIONS HAVE BEEN MADE TO CONFORM TO THE CONTRACTOR'S RECORD OF THIS PROJECT.

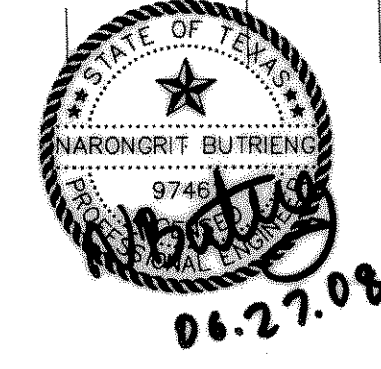

BENCH MARK LIST

- BM # 1 CITY OF ROCKWALL MONUMENT "RESET 1"; 3" BRASS DISK FOUND AT RIDGE ROAD (F.M. 740) AND SUMMER LEE DRIVE NEAR THE NORTH WEST CORNER OF THE A PARKING LOT FOR COMMUNITY BANK. ELEV=567.70
- BM # 2 " " CUT FOUND ON THE BACK OF CURB ON THE POINT ON CURVATURE OF THE SOUTHWEST CORNER OF THE INTERSECTION OF SUMMER LEE DRIVE AND OAK DRIVE. ELEV=563.21
- BM # 3 " " CUT SET ON THE BACK OF CURB AT THE POINT OF CURVE OF ROCKWALL PARKWAY AT THE NORTHEAST CORNER OF THE INTERSECTION OF SUMMER LEE DRIVE AND ROCKWALL PARKWAY. ELEV=552.82

HORIZONTAL CONTROL

HORIZONTAL ROAD (FM 3097), SUMMER LEE DRIVE, AND TUBBS ROAD IMPROVEMENTS
 CITY OF ROCKWALL, TEXAS

PSA ENGINEERING
 17819 DAVENPORT ROAD, SUITE 215 DALLAS, TX 75252 (972) 248-9681

DESIGN	DRAWN	DATE	SCALE	CHECK	FILE	NO.
RNB	PSA	06/27/08	AS SHOWN	PSS	2607.PHR	H-1

X:\2008\2607.PHR\AS-BUILT\PH-1.dwg