

CONSTRUCTION PLANS FOR **ROCKWALL COMMUNITY HOSPITAL**


HORIZON ROAD @ ROCKWALL PARKWAY EDWARD TEAL SURVEY, ABSTRACT No. 207

33.200 ACRES
CITY OF ROCKWALL, ROCKWALL COUNTY, TEXAS

FOR
PERKINS + WILL
10100 N. CENTRAL EXPRESSWAY SUITE 300
DALLAS, TEXAS 75206
OFFICE: 214-283-8700 ; FAX: 214-283-8701

PREPARED BY

Pacheco Koch
Consulting Engineers
8350 N. CENTRAL EXPWY., SUITE 1000 PH. 972.235.3031
DALLAS, TEXAS 75206 FAX 972.235.9544

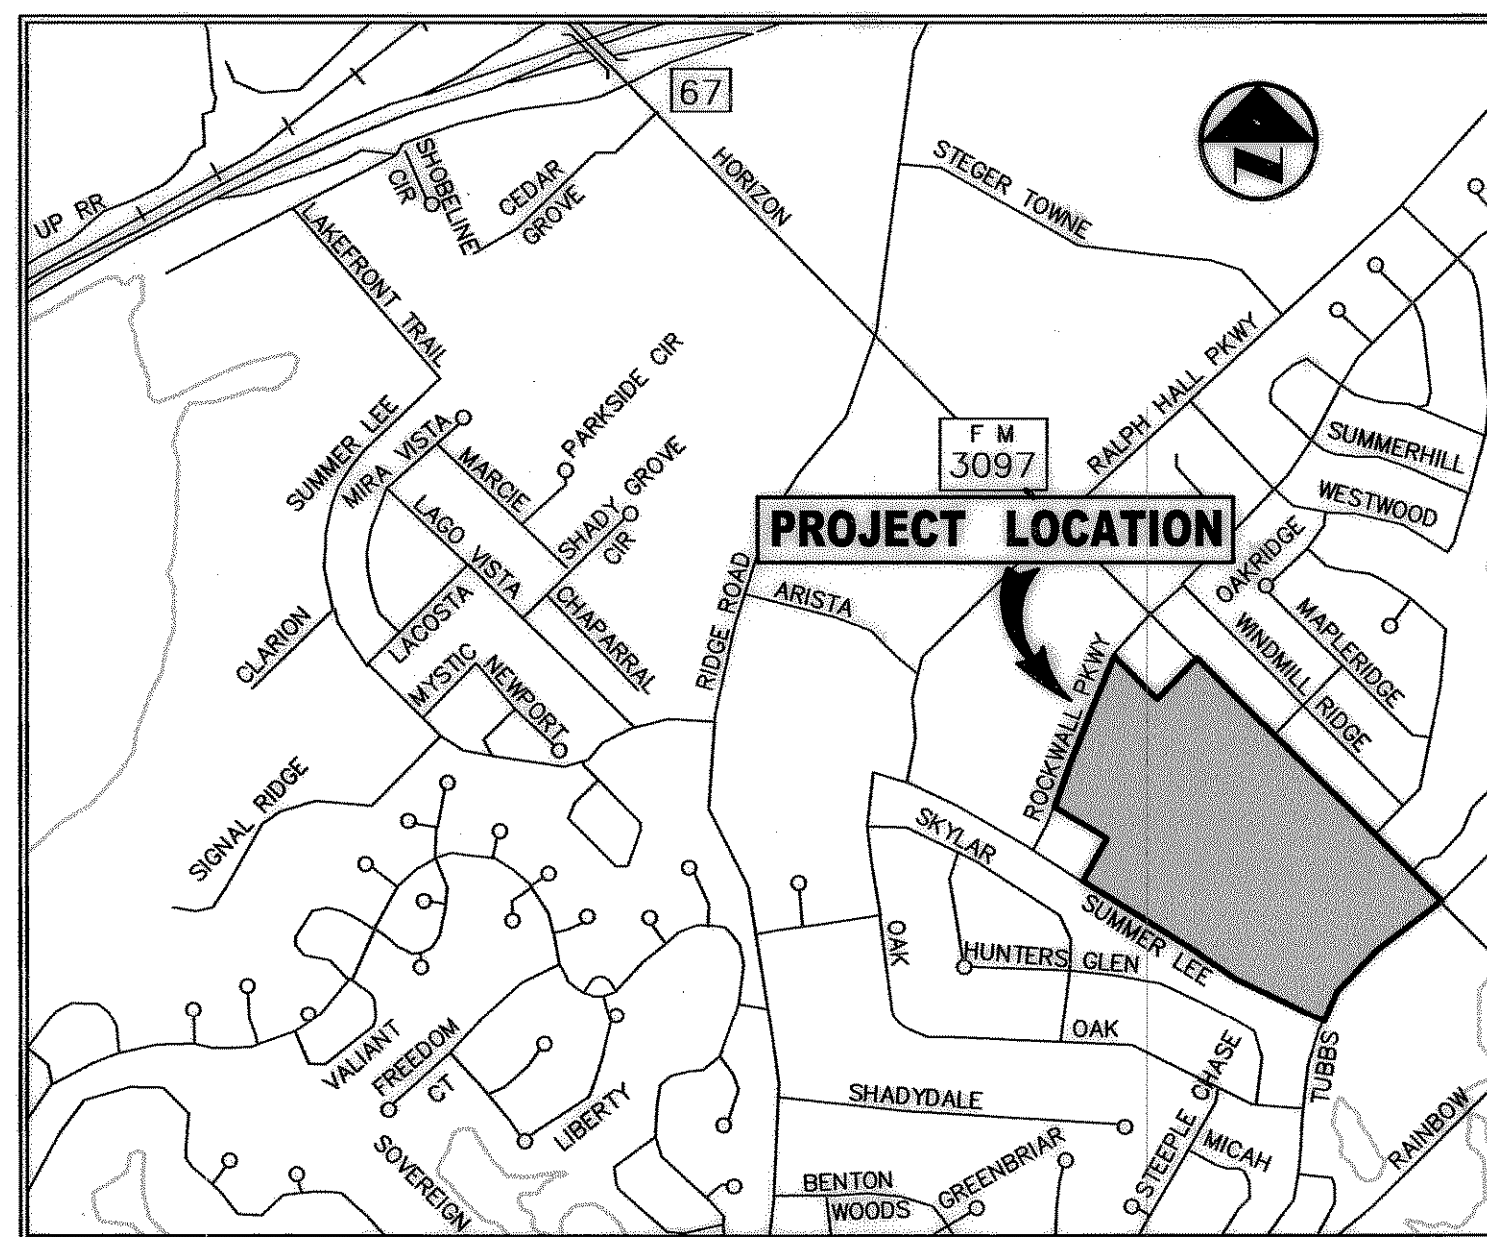

VICINITY MAP
NTS

DRAWING SHEET INDEX

SHEET	DESCRIPTION
C1.1 to C1.4	DIMENSIONAL CONTROL PLAN
C2.1 to C2.4	GRADING PLAN
C3.1 & C3.2	DRAINAGE AREA MAP
C4.1 to C4.4	STORM SEWER PLAN
C4.5 & C4.6	STORM SEWER PROFILES
C5.1 to C5.4	WATER & SANITARY SEWER PLAN
C5.5 to C5.6	SANITARY SEWER PROFILES
C5.7	UTILITY EXHIBIT
C6.1	PAVING PLAN & DETAILS
C7.1	EROSION CONTROL PLAN

RECORD DRAWING

THIS DRAWING HAS BEEN REVISED TO REFLECT CONSTRUCTION RECORDS MAINTAINED AND PROVIDED BY THE CONTRACTOR FOR THIS PROJECT. VISUAL REVIEW OF THE COMPLETED SITE CONSTRUCTION BY PACHECO KOCH, AND FIELD SURVEY VERIFICATION AT MANHOLES AND INLETS BY PACHECO KOCH.

CONTRACTOR: ROGERS-O'BRIEN
CONSTRUCTION CO.
DATE REVISED: 11/14/2007



THE SEAL APPEARING ON THIS DOCUMENT WAS AUTHORIZED BY ERIK M. HAUGLIE, P.E. 94736 ON 07/17/2006. ALTERATION OF A SEALED DOCUMENT WITHOUT PROPER NOTIFICATION TO THE RESPONSIBLE ENGINEER IS AN OFFENSE UNDER THE TEXAS ENGINEERING PRACTICE ACT.