


MATCHLINE SHEET C1.1

MATCHLINE SHEET C1.3

RECORD DRAWING

THIS DRAWING HAS BEEN REVISED TO REFLECT CONSTRUCTION RECORDS MAINTAINED AND PROVIDED BY THE CONTRACTOR FOR THIS PROJECT. A VISUAL REVIEW OF THE COMPLETED SITE CONSTRUCTION BY PACHECO KOCH, AND FIELD SURVEY VERIFICATION AT MANHOLES AND INLETS BY PACHECO KOCH.

CONTRACTOR: ROGERS-O'BRIEN CONSTRUCTION CO.
 DATE REVISED: 11/14/2007

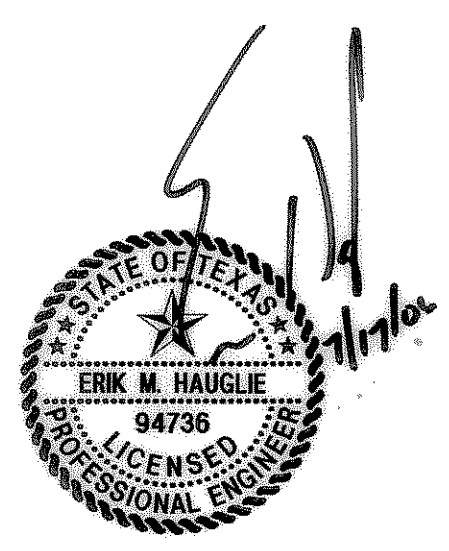

THE SEAL APPEARING ON THIS DOCUMENT WAS AUTHORIZED BY ERIC M. HAUGLE, P.E. 94736 ON 07/17/2006. ALTERATION OF A SEALED DOCUMENT WITHOUT PROPER NOTIFICATION TO THE RESPONSIBLE ENGINEER IS AN OFFENSE UNDER THE TEXAS ENGINEERING PRACTICE ACT.

NO.	DATE	REVISION				
<p>Pacheco Koch Consulting Engineers 8350 N. CENTRAL EXPWY. SUITE 1000 DALLAS, TX. 75206 972.235.3031</p>						
<p>DIMENSIONAL CONTROL PLAN</p>						
<p>ROCKWALL COMMUNITY HOSPITAL HORIZON ROAD @ ROCKWALL PARKWAY EDWARD TEAL SURVEY, ABST. NO. 207</p>						
<p>CITY OF ROCKWALL, TEXAS</p>						
DESIGN	DRAWN	DATE	SCALE	NOTES	FILE	NO.
EMH	RRL	AUG 2006	1"=40'			C1.2

REVISIONS: 02/08 - 8/04/AM
 05/15/06 - 15/15/06
 05/27/06 - 05/27/06
 05/27/06 - 05/27/06
 05/27/06 - 05/27/06