

SANITARY SEWER PROFILE - LINE "SS-1"

SANITARY SEWER PROFILE - LINE "SS-2"


BENCH MARK LIST

BM# 1	CITY OF ROCKWALL MONUMENT "RESET 1", 3" BRASS DISK FOUND AT RIDGE ROAD (F.M. 740) AND SUMMER LEE DRIVE NEAR THE NORTH WEST CORNER OF THE A PARKING LOT FOR COMMUNITY BANK. ELEV=567.70
BM# 2	" □ " CUT FOUND ON THE BACK OF CURB ON THE POINT ON CURVATURE OF THE SOUTHWEST CORNER OF THE INTERSECTION OF SUMMER LEE DRIVE AND OAK DRIVE. ELEV=563.21
BM# 3	" □ " CUT SET ON THE BACK OF CURB AT THE POINT OF CURVE OF ROCKWALL PARKWAY AT THE NORTHEAST CORNER OF THE INTERSECTION OF SUMMER LEE DRIVE AND ROCKWALL PARKWAY. ELEV=552.82

RECORD DRAWING

THIS DRAWING HAS BEEN REVISED TO REFLECT CONSTRUCTION RECORDS MAINTAINED AND PROVIDED BY THE CONTRACTOR FOR THIS PROJECT. A VISUAL REVIEW OF THE COMPLETED SITE CONSTRUCTION BY PACHECO KOCH, AND FIELD SURVEY VERIFICATION AT MANHOLES AND INLETS BY PACHECO KOCH.

CONTRACTOR: ROGERS-O'BRIEN CONSTRUCTION CO.
DATE REVISED: 11/14/2007

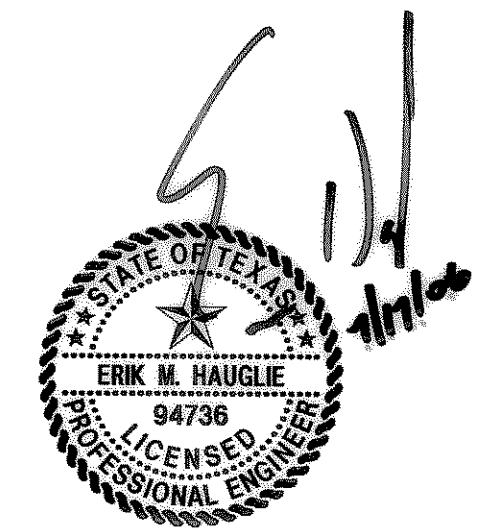

THE SEAL APPEARING ON THIS DOCUMENT WAS AUTHORIZED BY ERIK M. HAUGLIE, P.E. 94736 ON 07/17/2006. ALTERATION OF A SEALED DOCUMENT WITHOUT PROPER NOTIFICATION TO THE RESPONSIBLE ENGINEER IS AN OFFENSE UNDER THE TEXAS ENGINEERING PRACTICE ACT.

NO.	DATE	REVISION
	9/25/2006	ADDED DROP CONNECTION MANHOLE AND CHANGED SLOPE FROM STA 4+30.40 TO 6+35.80

Pacheco Koch Consulting Engineers
 8360 N. CENTRAL EXPWY. SUITE 1000 DALLAS, TX. 75206 972.235.3031

SANITARY SEWER PROFILE
ROCKWALL COMMUNITY HOSPITAL
HORIZON ROAD @ ROCKWALL PARKWAY
EDWARD TEAL SURVEY, ABST. NO. 207
CITY OF ROCKWALL, TEXAS

DESIGN	DRAWN	DATE	SCALE	NOTES	FILE	NO.
EMH	RRL	JULY 2006	1"=40'; 1"=05';V			C5.5

RLEWS
 07/25/2006 9:53AM
 H:\WORK\15\1567-05-270CV.DWG

ROCKWALL COMMUNITY HOSPITAL