


**UTILITY TRENCH**  
NOT TO SCALE

**RECORD DRAWING**  
THIS DRAWING HAS BEEN REVISITED TO REFLECT CONSTRUCTION RECORDS MAINTAINED AND PROVIDED BY THE CONTRACTOR FOR THIS PROJECT.  
CONTRACTOR: ROGERS-O'BRIEN CONSTRUCTION CO.  
DATE REVISED: 11/14/2007

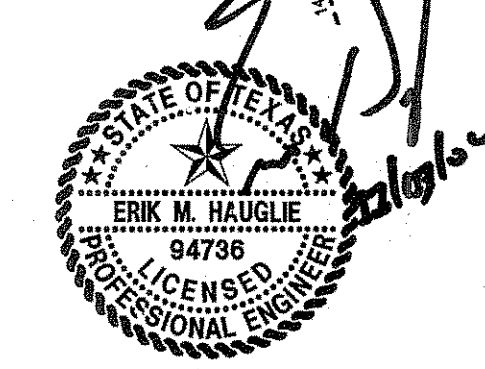

THE SEAL APPEARING ON THIS DOCUMENT WAS AUTHORIZED BY ERIC M. HAUJULE, P.E. 94736 ON 11/03/2006. ALTERATION OF A SEALED DOCUMENT WITHOUT PROPER NOTIFICATION TO THE RESPONSIBLE ENGINEER IS AN OFFENSE UNDER THE TEXAS ENGINEERING PRACTICE ACT.

**Pacheco Koch Consulting Engineers**  
8350 N. CENTRAL EXPWY., SUITE 1000 DALLAS, TX 75206 972.255.3031

**UTILITY EXHIBIT**  
**ROCKWALL COMMUNITY HOSPITAL**  
**HORIZON ROAD @ ROCKWALL PARKWAY**  
**EDWARD TEAL SURVEY, ABST. NO. 207**  
**CITY OF ROCKWALL, TEXAS**

DESIGN	DRAWN	DATE	SCALE	NOTES	FILE	NO.
EMH	RRL	JULY 2006	1"=60'			<b>C5.7</b>

AHINTHORN - 4:14PM  
 11/14/2007  
 M: VDWG-151567-05-270 DMC 1567-05-270C/DWG

ROCKWALL COMMUNITY HOSPITAL