



# CONSTRUCTION PLANS FOR **THR PRESBYTERIAN HOSPITAL OF ROCKWALL** **PARKING LOT EXPANSION** **3150 HORIZON ROAD**

1.47 ACRES ±  
CITY OF ROCKWALL, ROCKWALL COUNTY, TEXAS  
DECEMBER 2013

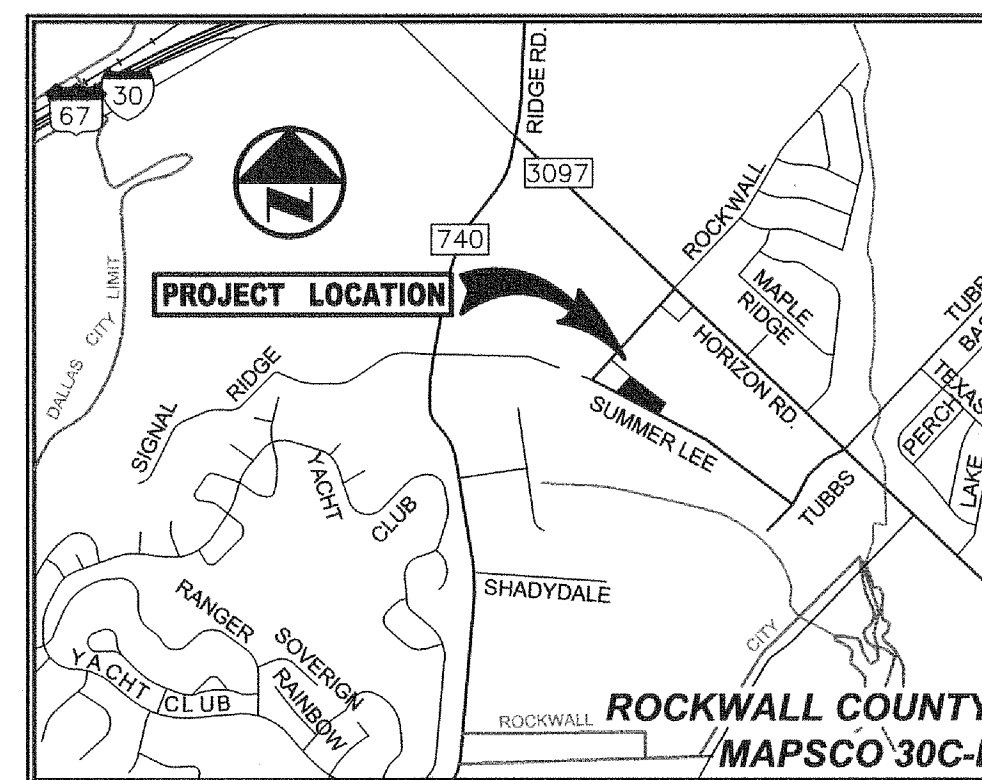

**VICINITY MAP**  
(NOT TO SCALE)

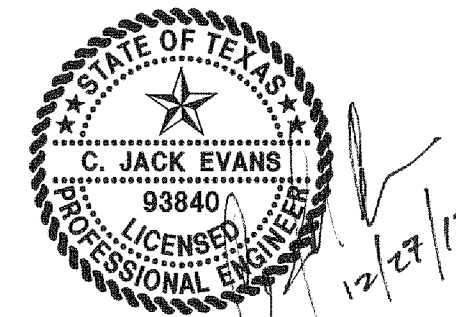

THE SEAL APPEARING ON THIS DOCUMENT WAS AUTHORIZED BY C. JACK EVANS, P.E. 93840 ON 12/27/2013. ALTERATION OF A SEALED DOCUMENT WITHOUT PROPER NOTIFICATION TO THE RESPONSIBLE ENGINEER IS AN OFFENSE UNDER THE TEXAS ENGINEERING PRACTICE ACT.

FOR  
ROGERS O'BRIEN CONSTRUCTION COMPANY  
1901 REGAL ROW  
DALLAS, TEXAS 75235-2309  
214-962-3000

OWNER  
ROCKWALL REGIONAL HOSPITAL, LLP  
14181 MIDWAY ROAD, SUITE 1050  
ADDISON, TEXAS 75001  
972-419-1512

PREPARED BY



8350 N. CENTRAL EXPWY. SUITE 1000 PH. 972.235.3031  
DALLAS, TX 75206 FAX 972.235.9544  
TX REG. ENGINEERING FIRM F-14439  
TX REG. SURVEYING FIRM LS-101938-05

### DRAWING SHEET INDEX

SHEET	DESCRIPTION
C1.1	COVER SHEET
C2.1	DIMENSIONAL CONTROL PLAN
C3.1	GRADING & DRAINAGE PLAN
C4.1	DRAINAGE AREA MAP
C5.1	PAVING PLAN & DETAILS
C6.1	EROSION CONTROL PLAN & DETAILS
L1.1	LANDSCAPE PLAN
L2.1	LANDSCAPE DETAILS
-	PHOTOMETRICS PLAN

### RECORD DRAWING

THE SIGNED AND SEALED CONSTRUCTION DOCUMENT HAS BEEN REVISED TO REFLECT CONSTRUCTION RECORDS MAINTAINED AND PROVIDED BY THE CONTRACTOR FOR THIS PROJECT. THE INFORMATION SHOWN ON THIS RECORD DRAWING, WHICH WAS PROVIDED BY THE CONTRACTOR, OR OTHERS NOT ASSOCIATED WITH THE DESIGN ENGINEER, CANNOT BE VERIFIED FOR ACCURACY OR COMPLETENESS. PACHECO KOCH SHALL ASSUME NO LIABILITY FOR ANY CHANGES MADE DURING CONSTRUCTION THAT WERE NOT SPECIFICALLY APPROVED BY THE ENGINEER PRIOR TO CONSTRUCTION. THE SEALED CONSTRUCTION DRAWINGS ARE ON FILE AT THE OFFICES OF PACHECO KOCH.

ATTESTED BY:  
SIGNATURE:   
ENGINEER OF RECORD: C. JACK EVANS  
CONTRACTOR: ROGERS-O'BRIEN CONSTRUCTION CO., LTD  
DATE REVISED: 03/26/2014