

	*10 8 8 8 12 12	G SCHEDULE				
CANC	PY TR					
QTY	UNIT	COMMON NAME	BOTANICAL NAME	SIZE/CONDITION	SPACING	REMARKS
7	EΑ	TEXAS RED OAK	QUERCUS BUCKLEYI (TEXANA)	4" CAL B&B	PER PLAN	MATCHED, 7 CLEAR TRUNK, 16-18
11	EΑ	CHINQUAPIN OAK	QUERCUS MUEHLENBERGII	4" CAL B&B	PER PLAN	MATCHED, 7 CLEAR TRUNK, 16-18
SHRUE	S					
QTY	UNIT	COMMON NAME	BOTANICAL NAME	SIZE/CONDITION	SPACING	REMARKS
26	EΑ	DWARF PITTOSPORUM	PITTOSPORUM TOBIRA WHEELER'S DWARF	5 GAL CONT	3 O.C.	9" SOIL MIX
47	EΑ	DWARF HEAVENLY BAMBOO	NANDINA DOMESTICA HARBOUR DWARF'	5 GAL CONT	2-6" O.C.	9" SOIL MIX
GROU	NDCC	VER				
QTY	UNIT	COMMON NAME	BOTANICAL NAME	SIZE/CONDITION	SPACING	REMARKS
2,593	EA	PURPLE WINTER CREEPER	EUONYMUS FORTUNEI COLORATUS'	4" POT	1" O.C.	4" SOIL MIX 1-1/2" MULCH
TURF	GRASS					
QTY	UNIT	COMMON NAME	BOTANICAL NAME	SIZE/CONDITION	SPACING	REMARKS
22,210	SF	COMMON BERMUDA	CYNODON DACTYLON	SOLID SOD		
HAR	DSC	APE SCHEDULE				
QTY	UNIT	COMMON NAME	DESCRIPTION	SIZE/CONDITION	SPACING	REMARKS
388	SF	DECOMPOSED GRANITE	TEXAS BUFF			

LANDSCAPE TABULATION	VS		
GENERAL LANDSCAPE REQUIREM			
ZONING TYPE: O (OFFICE)			
20% OF TOTAL SITE AREA SHOULD BE LANI	DSCAPED, NO LESS THAN 5 WIDE		
TOTAL SITE AERA:	62,134 S.F.		
REQUIRED: 12,427 S.F. (20%)	PROVIDED: 26,174 S.F. (42%)		
PARKING AREA LANDSCAPE REQ	UIREMENTS		
MIN. 5% OR 200 S.F. IN THE INTERIOR OF TH	SE PARKING LOTIN LANDSCAPING		
TOTAL PARKING AREA: 35,960 S.F.			
REQUIRED: 1,798 S.F. (5%)	PROVIDED: 3,139 S.F. (8.7%)		
ONE (1) CANOPY TREE FOR EACH 10 REQU	IRED PARKING SPACES IN THE LOT		
TOTAL PARKING SPACES: 108			
REQUIRED:	PROVIDED:		
11	11		
LANDSCAPE BUFFERSTRIP REQUIR	EMENTS		
A 10' WIDE LANDSCAPE BUFFER ADJACENE	ET TO ALL STREETS OR PROPERTY LINE SHOULD HAVE:		
ONE (1) CANOPY TREE PER 50 L.F.			
SUMMER LEE DRIVE (RIGHT-OF-WAY)	327 L.F.		
REQUIRED:	PROVIDED:		
(7) CANOPY TREES	(7) CANOPY TREES		

RECORD DRAWING

THE SIGNED AND SEALED CONSTRUCTION DOCUMENT HAS BEEN REVISED TO REFLECT CONSTRUCTION RECORDS MAINTAINED AND PROVIDED BY THE CONTRACTOR FOR THIS PROJECT. THE INFORMATION SHOWN ON THIS RECORD DRAWING, WHICH WAS PROVIDED BY THE CONTRACTOR, OR OTHERS NOT ASSOCIATED WITH THE DESIGN ENGINEER, CANNOT BE VERIFIED FOR ACCURACY OR COMPLETENESS. PACHECO KOCH SHALL ASSUME NO LIABILITY FOR ANY CHANGES MADE DURING CONSTRUCTION THAT WERE NOT SPECIFICALLY APPROVED BY THE ENGINEER PRIOR TO CONSTRUCTION. THE SEALED CONSTRUCTION DRAWINGS ARE ON FILE AT THE OFFICES OF PACHECO KOCH.

ENGINEER OF RECORD: WADE C. PETERSON

CONTRACTOR: ROGERS-O'BRIEN CONSTRUCTON CO., LTD DATE REVISED: 03/26/2014

LEGEND

TEXAS RED OAK CHINQUAPIN OAK DWARF PITTOSPORUM DWARF HEAVENLY BAMBOO LANDSCAPE BUFFER ZONE PURPLE WINTER CREEPER IRRIGATED TURF GRASS (COMMON BERMUDA) DECOMPOSD GRANITE VISIBILITY TRIANGLE TREE PROTECTION FENCE


PLANTING GENERAL NOTES

- 1. ALL PLANTS SHALL BE SET OUT FOR APPROVAL BY THE OWNER'S REPRESENTATIVE PRIOR TO INSTALLATION.
- 2. FINE GRADING SHALL BE PERFORMED IN ALL AREAS TO BE LANDSCAPED. FINE GRADING SHALL INCLUDE THE REMOVAL OF DEBRIS, ROCKS, ETC. FROM THE SITE AND INSURE POSITIVE DRAINAGE IN ALL AREAS.
- 3. THE CONTRACTOR SHALL SHALL LOCATE ALL UTILITIES AND EASEMENTS IN THE FIELD PRIOR TO COMMENCEMENT OF WORK. CONTRACTOR IS RESPONSIBLE FOR ANY DAMAGE TO UTILITIES DURING THE COURSE OF CONSTRUCTION.
- 4. WRITTEN DIMENSIONS SHALL GOVERN OVER SCALED DIMENSIONS.
- 5. IT IS PREFERABLE THAT NO TREE BE STAKED. HOWEVER, CONDITIONS AND PLANT MATERIAL SIZE MAY NECESSITATE STAKING. THE OWNER'S REP SHALL DETERMINE IF SUPPORT IS NEEDED AND SHALL DIRECT THE CONTRACTOR ACCORDINGLY.
- 6. THE CONTRACTOR SHALL REFER TO THE SPECIFICATIONS FOR ADDITIONAL INFORMATION AND REQUIREMENTS ASSOCIATED WITH THE LANDSCAPE AND ACCESSORIES.
- 7. ALL PLANT MATERIALS SHALL MEET ANSI Z60.1 STANDARDS FOR CALIPER, HEIGHT AND ROOT BALL SIZE. ANY MATERIALS THAT DO NOT MEET OR EXCEED SUCH STANDARDS SHALL BE REJECTED AND REPLACED AT THE CONTRACTOR'S EXPENSE.
- 8. BALLED AND BURLAPPED TREES SHALL HAVE THE TOP HALF OF THE WIRE BASKET REMOVED. THE BURLAP SHALL BE REMOVED TO THE GREATEST EXTENT POSSIBLE, USING A KNIFE TO CUT AND REMOVE THE BOTTOM HALF UNDER THE WIRE BASKET THAT REMAINS.

MAINTENANCE GENERAL NOTES

1. REQUIRED LANDSCAPING MUST BE MAINTAINED IN A HEALTHY, GROWING CONDITION AT ALL TIMES. THE PROPERTY OWNER IS RESPONSIBLE FOR REGULAR WEEDING, MOWING OF GRASS, IRRIGATION, FERTILIZING, PRUNING, OR OTHER MAINTENANCE OF ALL PLANTINGS AS NEEDED. ANY PLANT THAT DIES MUST BE REPLACED WITH ANOTHER APPROVED PLANT VARIETY, GENERALLY OF THE SAME SIZE, THAT COMPLIES WITH THE APPROVED LANDSCAPE PLAN WITHIN 90 DAYS AFTER NOTIFICATION BY THE CITY.

2. ANY DAMAGE TO UTILITY LINES RESULTING FROM THE NEGLIGENCE OF THE PROPERTY OWNER, HIS AGENTS, OR EMPLOYEES IN THE INSTALLATION AND MAINTENANCE OF REQUIRED LANDSCAPING IN A UTILITY EASEMENT IS THE RESPONSIBILITY OF THE PROPERTY OWNER. IF A PUBLIC UTILITY DISTURBS A LANDSCAPED AREA IN A UTILITY EASEMENT, IT SHALL MAKE EVERY REASONABLE EFFORT TO PRESERVE THE LANDSCAPING MATERIALS, AND RETURN THEM TO THEIR PRIOR LOCATIONS AFTER UTILITY WORK. IF, NONETHELESS, SOME PLANT MATERIALS DIE, IT IS THE OBLIGATION OF THE PROPERTY OWNER TO REPLACE THE PLANT MATERIALS.

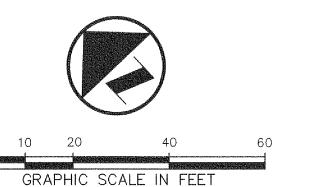



NO. DATE REVISION Pacheco Koch 8350 N. CENTRAL EXPWY. SUITE 1000 DALLAS, TX 75206 972.235.3031

DALLAS . FORT WORTH . HOUSTON TX REG. SURVEYING FIRM LS-100080-00

TX REG. ENGINEERING FIRM F-469

LANDSCAPE PLAN

THR PRESBYTERIAN HOSPITAL OF ROCKWALL PARKING LOT EXPANSION 3150 HORIZON ROAD

CITY OF ROCKWALL, ROCKWALL COUNTY, TEXAS DATE SCALE NOTES DESIGN DRAWN

1"=20'

PK FILE: 1567-13.397

CM

WCP

JAN 2013