


# CONSTRUCTION PLANS FOR THE PRESERVE PHASE 1 CITY OF ROCKWALL ROCKWALL COUNTY, TEXAS

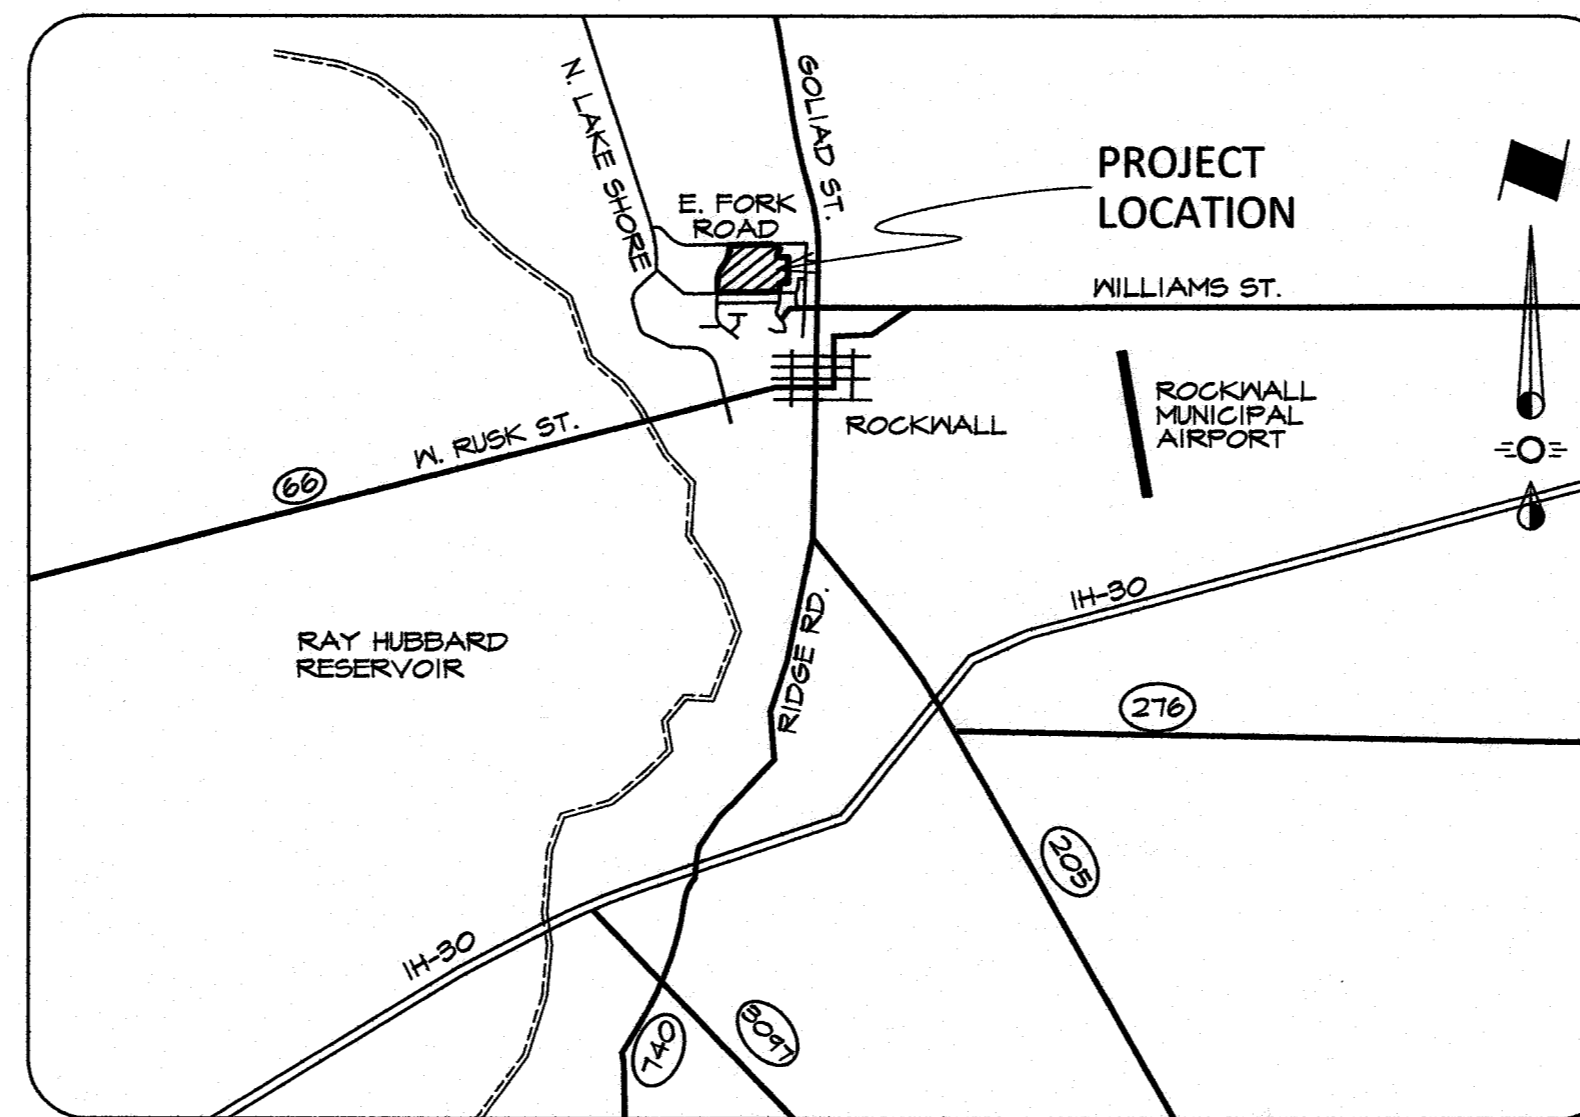

Vicinity Map  
N.T.S.  
MapscO Grid Reference: 20C-L

## INDEX OF DRAWINGS

1-5	Final Plat
6-26	Paving Plans
27	Drainage Area Map
28	Storm Sewer Calculations
29	Existing Drainage Area Map
30	Overall Drainage Area Map
31	Detention Pond Calculations
32-33	Detention Pond Details
34-47	Storm Sewer Plan & Profiles
48-49	Water & Sanitary Sewer Plan
50-51	Sanitary Sewer Profiles
52	Erosion Control Plan
53	Erosion Control Details
54-57	Lot Grading Plans
58	Street Light & Signage Plan
59	Traffic Control Plan
60-62	Details
RW1	Concrete Weir Structural Plans
AD1-2	Armormax Details

### PREPARED FOR:

**MASTER DEVELOPERS-SNB, LLC**  
2400 Dallas Parkway, Suite 560  
Plano, Texas 75093  
Telephone: 972-985-5505

### AS-BUILT DRAWINGS

THIS DRAWING HAS BEEN REVISED TO CONFORM TO THE CONSTRUCTION RECORDS PROVIDED BY THE CONTRACTOR. ALIGNMENT AND GRADES SHOWN ON THIS DRAWING WERE NOT FIELD VERIFIED BY THE ENGINEER.

*Greg T. Hefsel*  
Greg T. Hefsel, P.E.

DATE 11/29/16

Note:  
Use City Of Rockwall Standards  
And NCTCOG 3rd Edition With  
Revisions And Addendums.