

AS-BUILT DRAWINGS
 THIS DRAWING HAS BEEN REVISED TO CONFORM TO THE CONSTRUCTION RECORDS PROVIDED BY THE CONTRACTOR. ALIGNMENT AND GRADES SHOWN ON THIS DRAWING WERE NOT FIELD VERIFIED BY THE ENGINEER.

Greg T. Helsel
 Greg T. Helsel, P.E.
 DATE 11/29/16

Note:
 All Barrier Free Ramp To Be Installed With Truncated Dome Plates In Colonial Red Or Brick Red. All Barrier Free Ramps Shown On Plans To Be Installed By Paving Contractor Per 1xDot Standards.

**CAUTION !!!
 EXISTING UTILITIES**



EXISTING UTILITIES AND UNDERGROUND FACILITIES INDICATED ON THESE PLANS HAVE BEEN LOCATED FROM REFERENCE INFORMATION. IT SHALL BE THE RESPONSIBILITY OF THE CONTRACTOR TO VERIFY BOTH HORIZONTALLY AND VERTICALLY THE LOCATION OF ALL EXISTING UTILITIES AND UNDERGROUND FACILITIES PRIOR TO CONSTRUCTION, TO TAKE NECESSARY PRECAUTIONS IN ORDER TO PROTECT ALL FACILITIES ENCOUNTERED. THE CONTRACTOR SHALL PRESERVE AND PROTECT ALL EXISTING UTILITIES FROM DAMAGE DURING CONSTRUCTION.

BM1
 Being an "X" found in concrete at the intersection of the north line of Arcadia Way with the west line of Highland Drive and being the southeast corner of Lot 24, Block Q of the Preserve Phase III.
 Elevation = 565.30

BM2
 Being an "X" found in concrete at the intersection of the north line of East Fork Road with the west line of Calistoga Drive and being the southeast corner of Lot 16, Block X of Lakeview Summit, Phase One.
 Elevation = 500.49

CALL 1-800-344-8377 (DIG-TESS) OR OTHER UTILITY LOCATION SERVICES 48 HOURS PRIOR TO CONSTRUCTION ACTIVITY. SPIARS ENGINEERING, INC. IS NOT RESPONSIBLE FOR KNOWING ALL EXISTING UTILITIES OR DEPICTING EXACT LOCATIONS OF UTILITIES ON DRAWINGS.

ALLEY 'B'

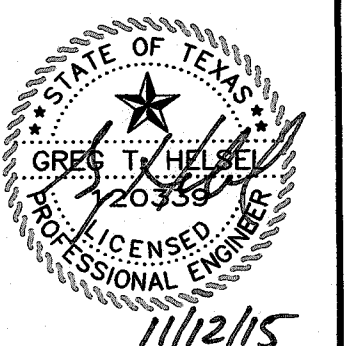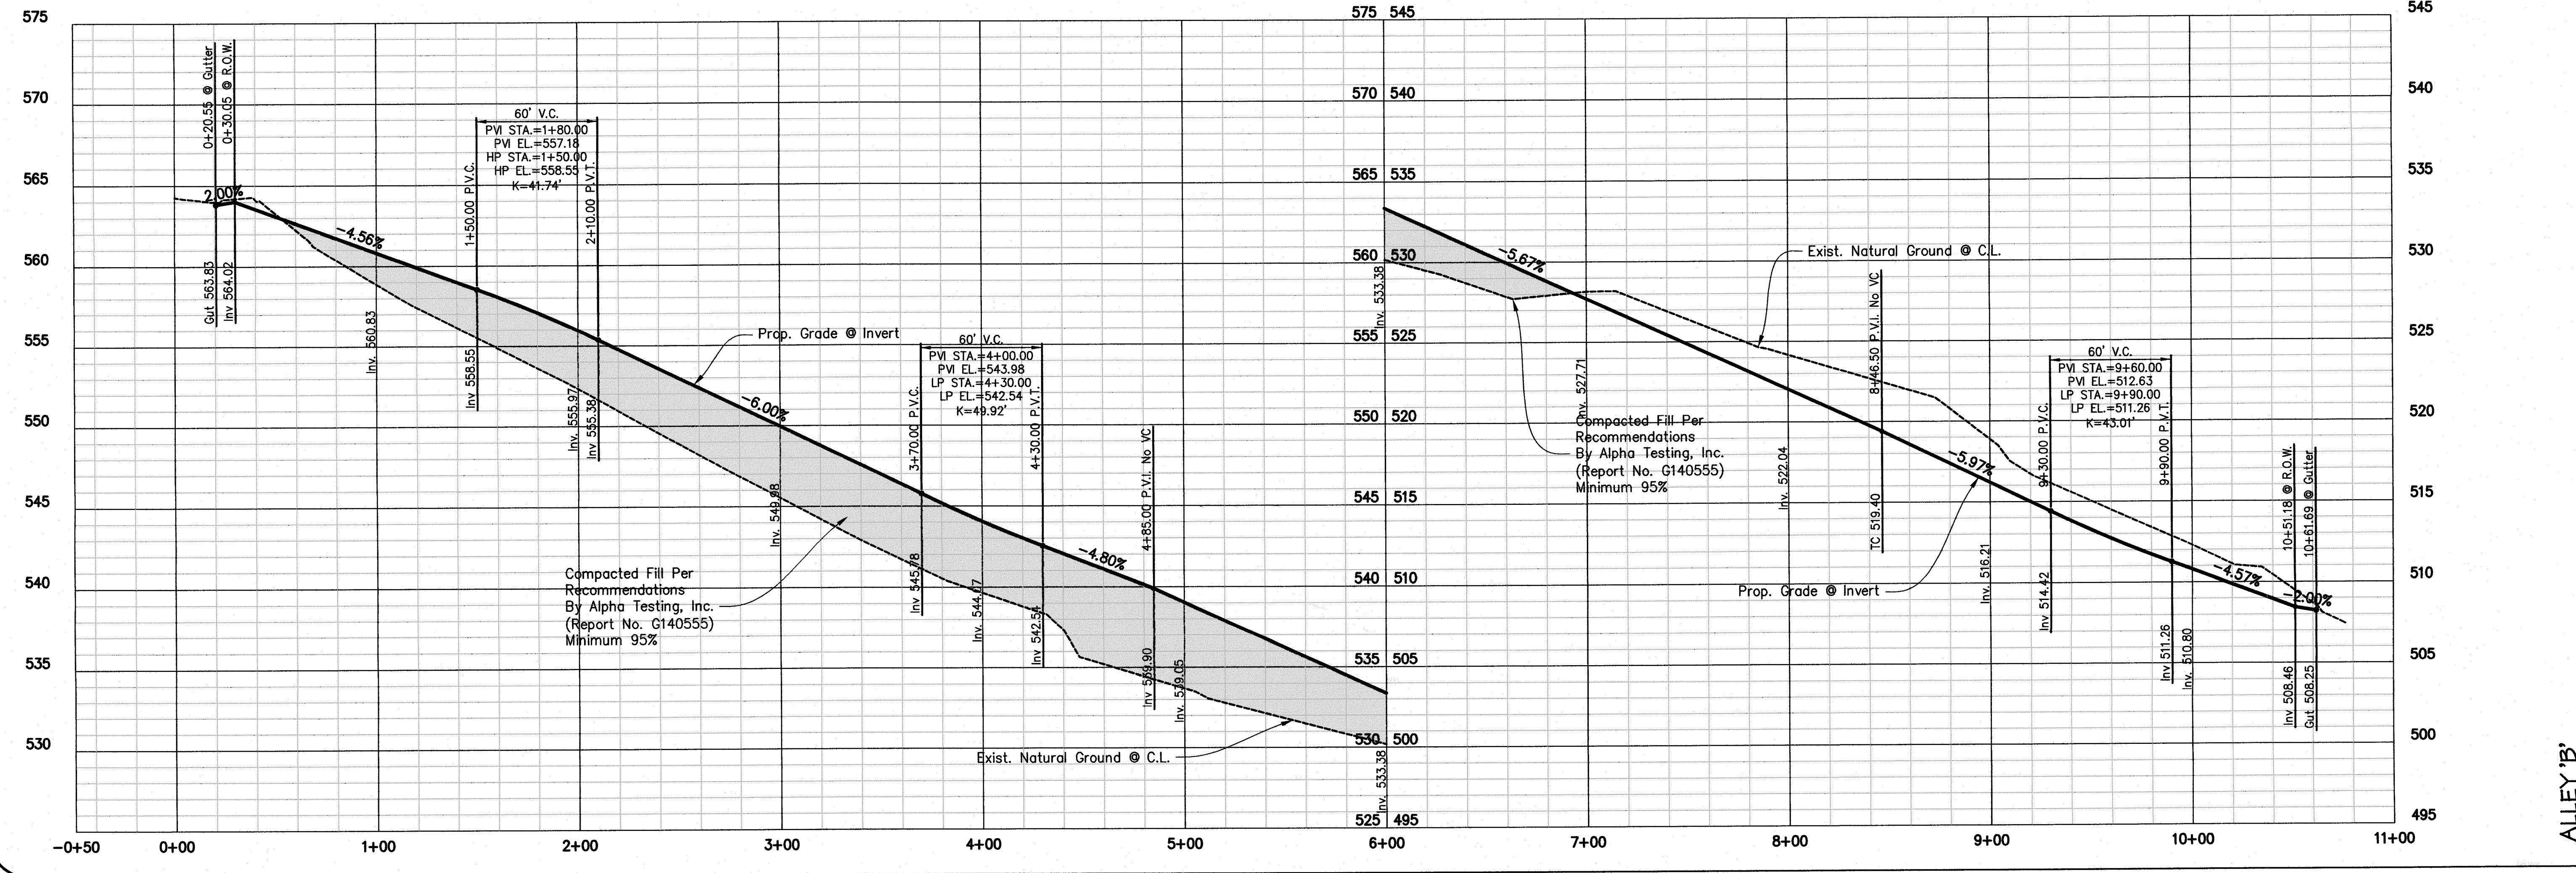

THE PRESERVE PHASE 1
 CITY OF ROCKWALL
 ROCKWALL COUNTY, TEXAS

PAVING PLAN & PROFILE

Issue Dates:
 06-30-2015

Date	Revisions

Scale: 1"=40'H, 1"=5'V
 Drawn By: GD
 Checked By: GTH
 Sheet 21
 of 62
 SEI No. 13-141

Drawings: 03/2013, 05/13/14, The Preserve Phase 1, 13-14, srs, 15-17, 11/20/2015, 2:10:03 PM
 Printed by: gth@piars.com Date: 10/27/2015 2:35:38 PM