

NOTE:


- 1) PAVEMENT FOR STREETS SHALL CONSIST OF 8" 3600 P.S.I. REINFORCED CONCRETE AND 6" LIME-STABILIZED SUBGRADE WITH 6" PARABOLIC CROWN.
- 2) CONTRACTOR TO RUN LIME SERIES BEFORE CONSTRUCTION.

**BENCHMARK: #1**  
BRASS CAP IN CL. OF MEDIAN NORTH ON LAKESHORE DRIVE NORTH OF THE INTERSECTION OF NORTH ALAMO AND LAKESHORE DRIVE.  
ELEV. 524.78

**BENCHMARK: #2**  
BRASS CAP IN CL. OF MEDIAN ON LAKESHORE DRIVE BETWEEN TO STREETS, STONEBROOK AND AMESBURY BEING NORTH OF HAVEN HILL.  
ELEV. 518.63

"AS BUILTS"

Information shown on these plans was furnished by the Contractor. All responsibility for the accuracy belongs to the Contractor.

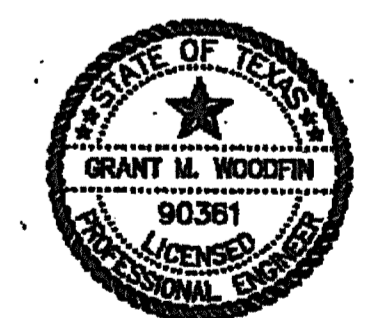

The Seal Appearing On This Document Was Authorized By  
*Grant H. Woodfin*  
90351, Gr  
2.11.06

PAVING DETAILS  
THE PRESERVE - PHASE 2  
CITY OF ROCKWALL, TEXAS

**C&P Engineering, LTD.**  
Engineering • Planning • Surveying  
1801 GATEWAY BLVD. - SUITE 101  
RICHARDSON, TEXAS 75080  
email: info@c-pengineering.com

(972) 644-2800 OFC (972) 644-2817 FAX  
DRAWN BY: DATE: SCALE: JOB NUMBER: SHEET NUMBER:  
C&P 2/06 1"=40'-H 05109 5 of